
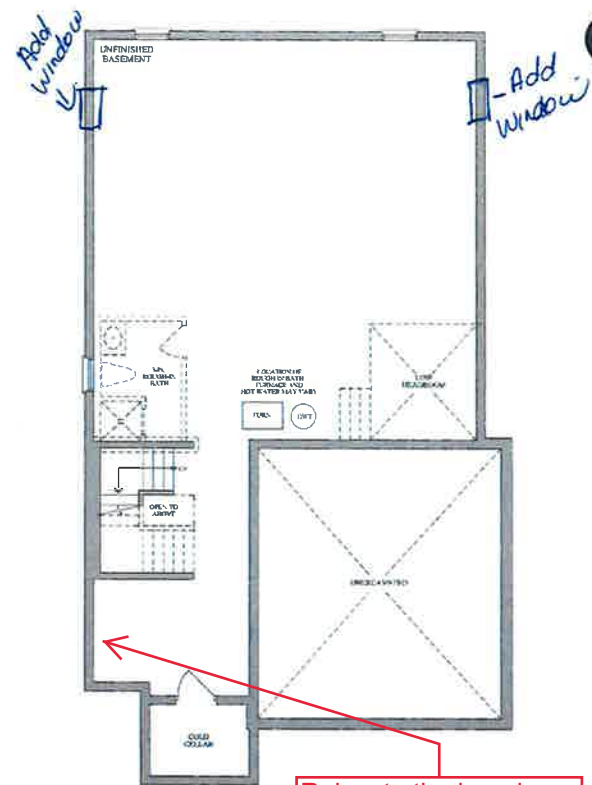
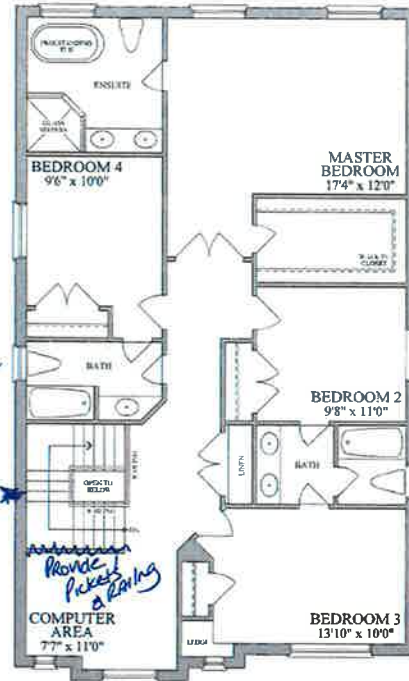


38'
DESIGNS

The manitou / Elev. A & B
2480 sq.ft.

Remove wall, add railing & pickets
Add window at stairs between main & 2nd
Relocate closet - Remove wall, add railing & pickets
delete sunken
stackable washer/dryer
Add 2 windows 2.4ft x 5ft
Provide pickets & railing
Add window
- Add window

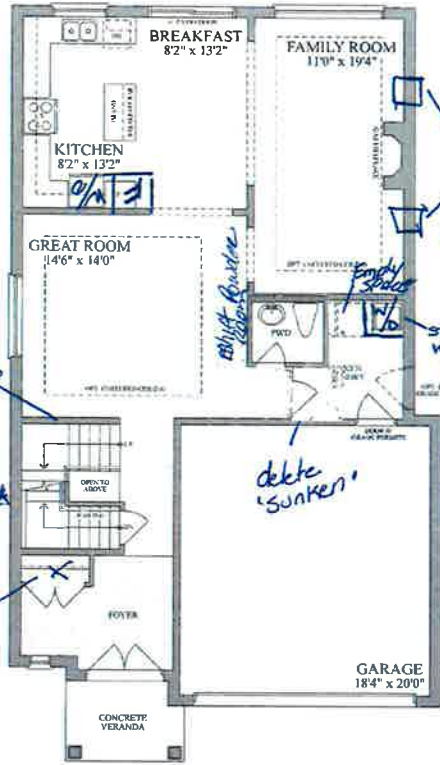

Relocate the laundry connections to this area W/D/Tub



Plans and specifications are subject to change without notice. L. & D. E. Actual double floor space may vary from the stated floor area. All measurements are owner's concept.

LOT 5-76, PH5, PE003, SKETCH
Ali Afshar
PURCHASER: Ali Afshar (Oct 13, 2021 16:36 EDT)
Nargis Hussaini
PURCHASER: Nargis Hussaini (Oct 13, 2021 16:37 EDT)

