
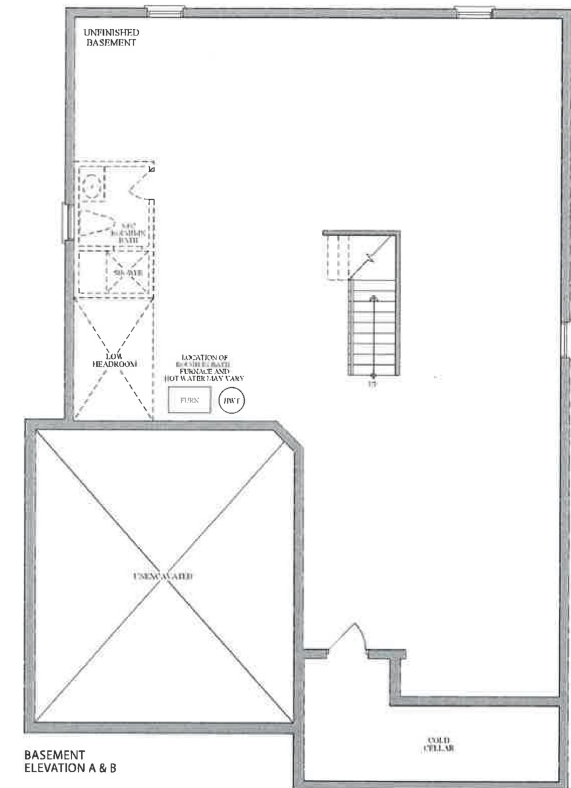


LOT 5-60, PH5, INNISFIL, PE 004

PURCHASER INITIALS: SG

47'
DESIGNS

The Kahshe / Elev. A & B
3000 sq.ft.

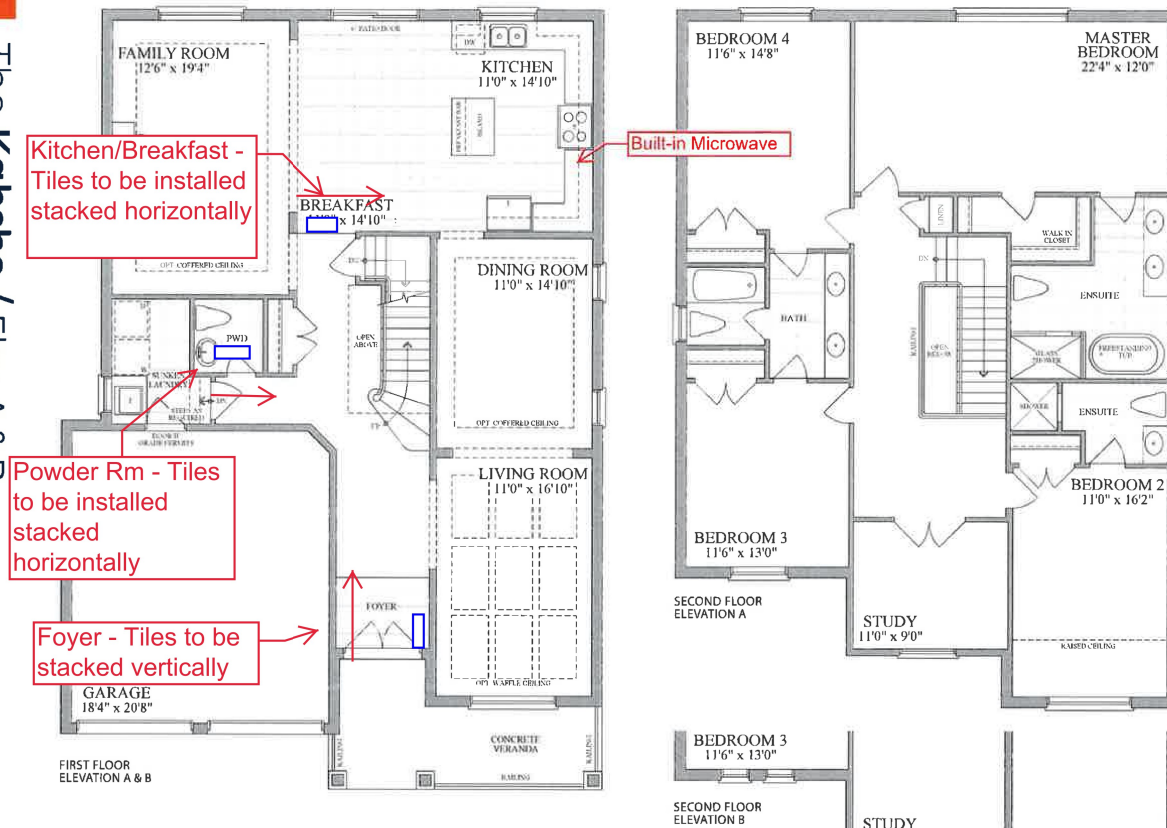

LOT 5-60, PH5, INNISFIL, PE 003

PURCHASER INITIALS: SG