
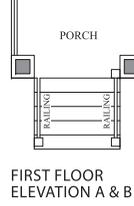



**The Temagami / Elev. A & B**  
**3 Car Tandem 3068 sq.ft.** - includes 478 sq. ft. of finished area in lower level  
**2 Car Garage 3350 sq.ft.** - includes 760 sq. ft. of finished area in lower level

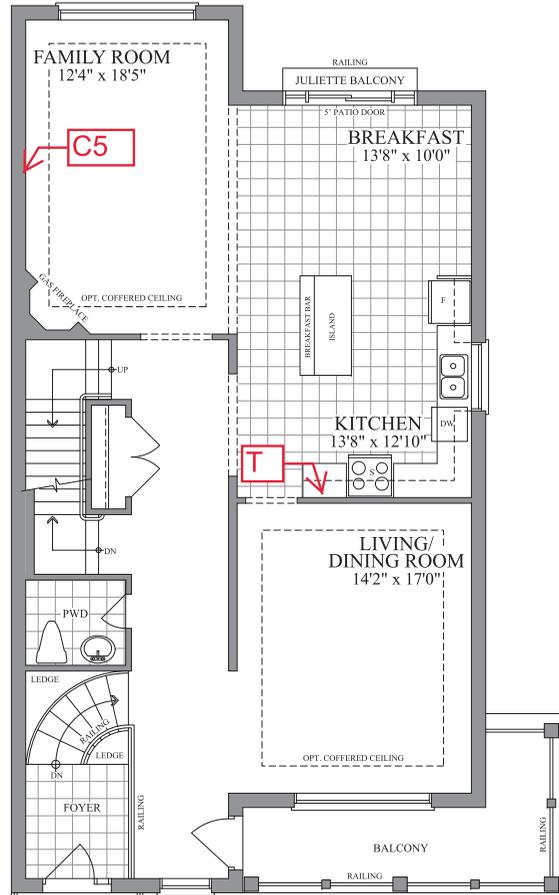


FIRST FLOOR  
ELEVATION A & B

Please indicate the location of the rough-ins on your plan


Description	Symbol on Sketch	Standard Locations
Cable (Rough-in)	C	Family room Or Great Room, all bedrooms, Study/Den/Computer, (as per model)
Cat5	C5	A Cat5 wire can replace the rough-in cable at no additional cost.
Cat6	C6	Upgrade - \$50 per location
Telephone (Rough-in)	T	Kitchen and Primary Ensuite
Smart-Wire (Cat5)	S	Can be installed a Purchaser's desired location

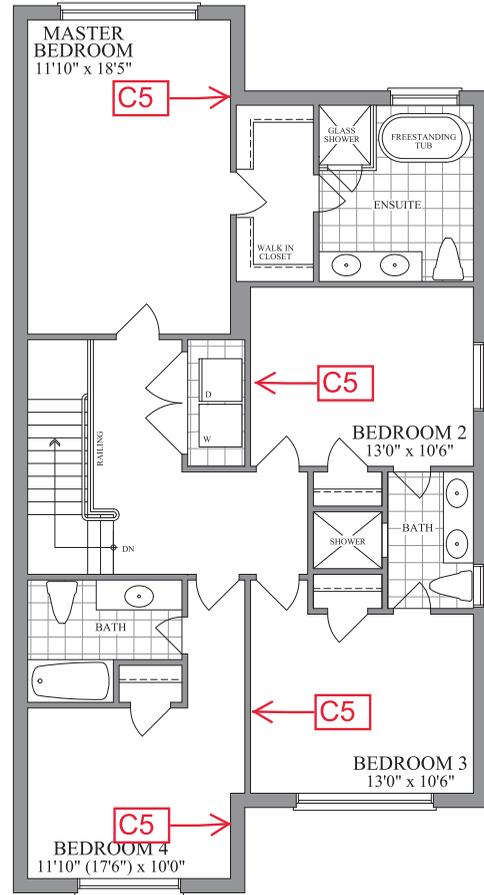


SECOND FLOOR  
ELEVATION A

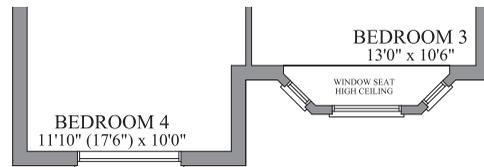

SECOND FLOOR  
ELEVATION B

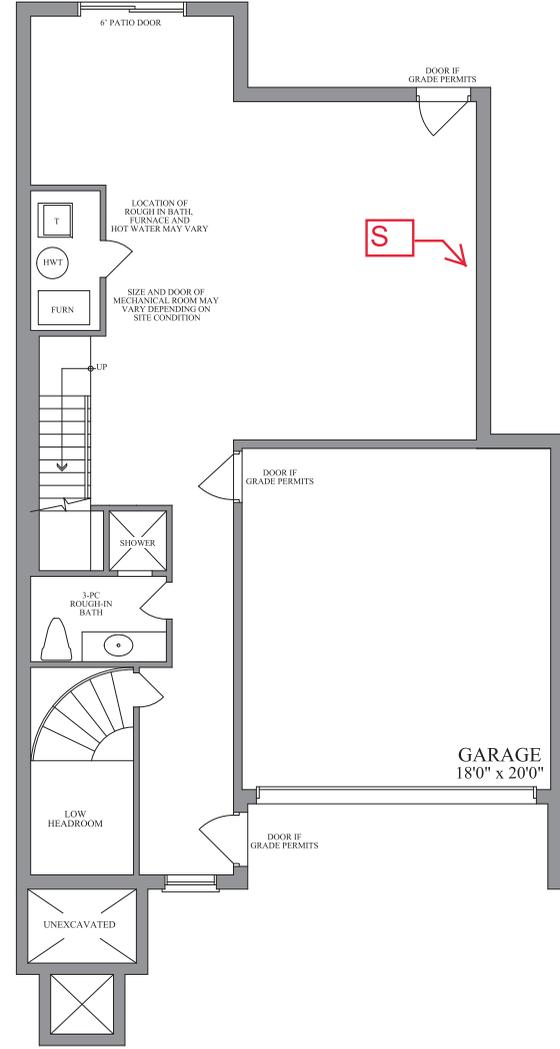

LOWER LEVEL  
ELEVATION A & B  
 2 CAR GARAGE  
 3350 SQ. FT. INCLUDES 760 SQ. FT. OF FINISHED AREA IN LOWER LEVEL

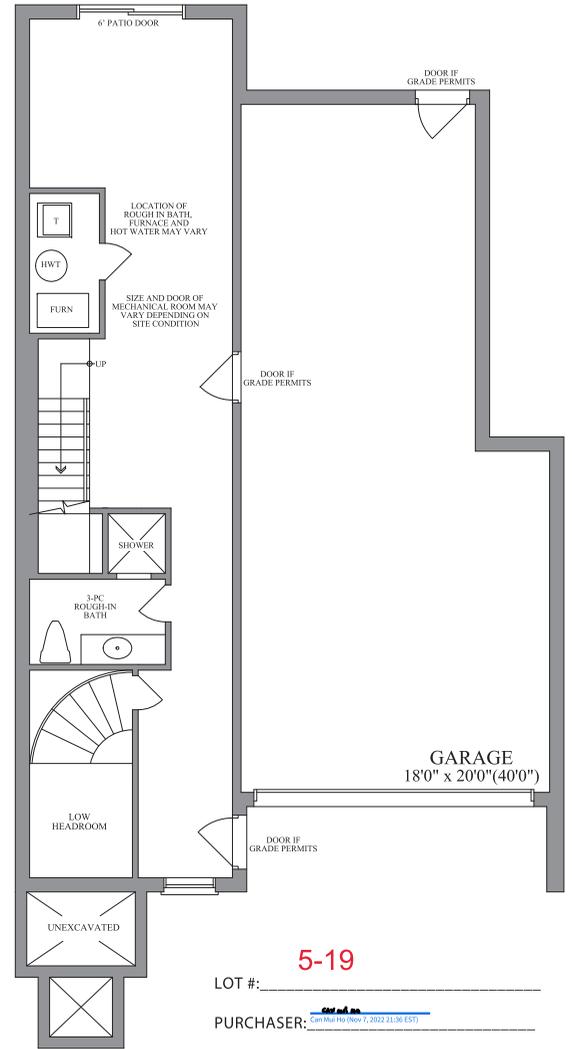

LOWER LEVEL  
ELEVATION A & B  
 OPT. TANDEM 3 CAR GARAGE  
 3068 SQ. FT. INCLUDES 478 SQ. FT. OF FINISHED AREA IN LOWER LEVEL

LOT #: **5-19**  
 PURCHASER: \_\_\_\_\_  
 PURCHASER: \_\_\_\_\_