

PE006 - REFLECT THE KITCHEN
LAYOUT / UPGRADES ONLY




Lot 5-90 PE#003

INCREASE
SHOWER
BY
1 FOOT.

DECREASE
MASTER
BY
1 FOOT
RE Center
Window

38'
LOTIONS

The Buckhorn / Elev. A & B
1800 sq.ft.

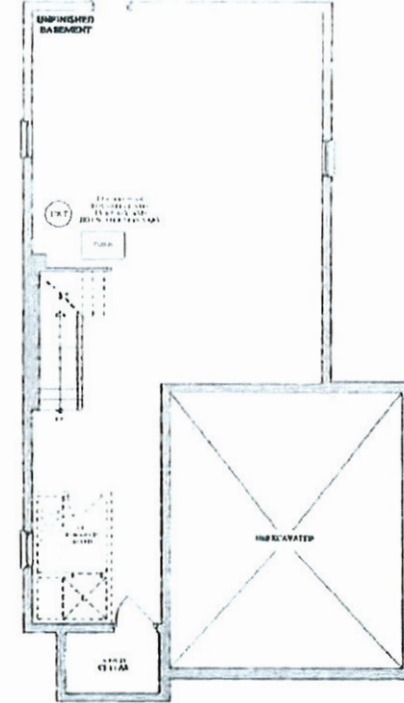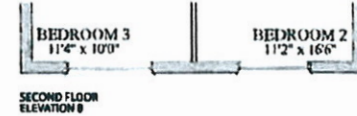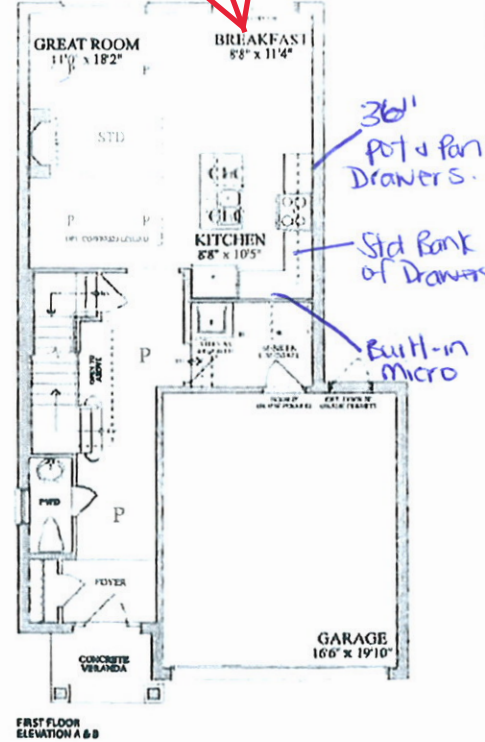

BASMENT
ELEVATION A & B

LOT 5-90, PH5, PE002, SKETCH

PURCHASER: [Signature]



Plans and specifications are subject to change without notice. All dimensions are given in feet and inches. All measurements are given to the centerline of the wall or to the centerline of the window or door.