

47
DESIGNS

The Carlyle / Elev. A & B
2950 sq.ft.

E/C/CONDUIT FOR
TV ABOVE
FIREPLACE

8ft - Exterior Garden
Door, full length glass

TWO (2) Glass
Cabinets above
dishwasher space

Island to 3x5 - includes
base and countertop
(no overhang)

48" stove & chimney
style hood fan; 10"vent

Approx 33" wall


Include spacing and
electrical for beverage
center

Swap location of the
servery cabinetry and
the walk-in pantry

98" HIGH DOOR
FROM HOUSE TO
GARAGE


8FT TALL GARAGE
DOORS

TILES - FOYER,
POWDER & KITCHEN/
BREAKFAST AREAS,
INSTALLED STACKED
HORIZONTALLY

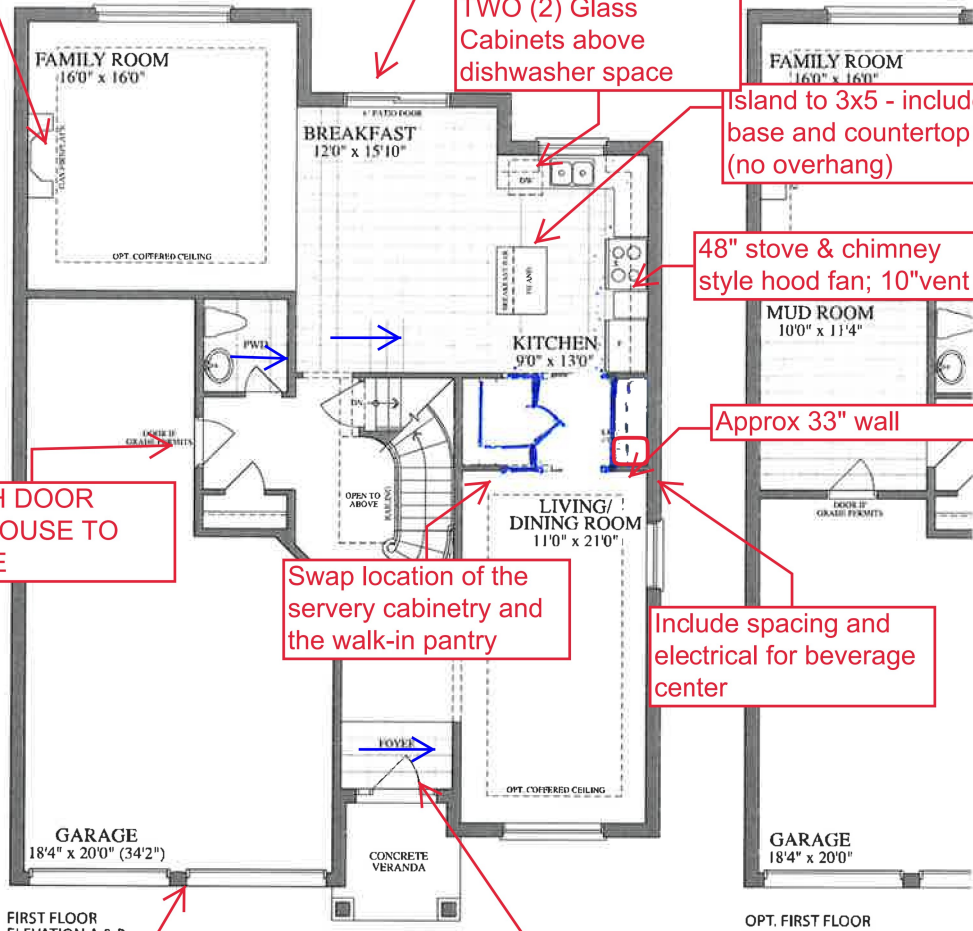


FIRST FLOOR
ELEVATION A & B

OPT. FIRST FLOOR

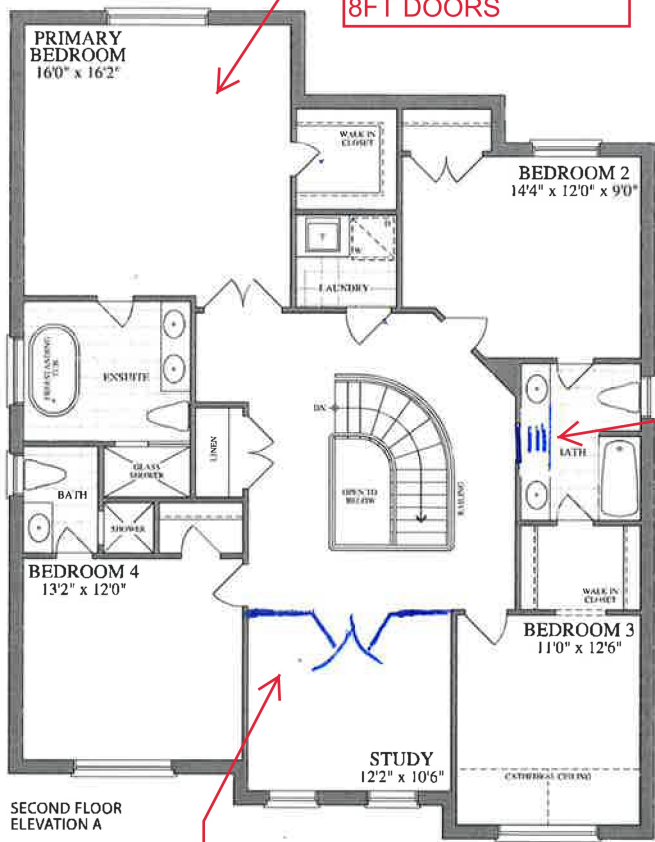

SECOND FLOOR
ELEVATION A

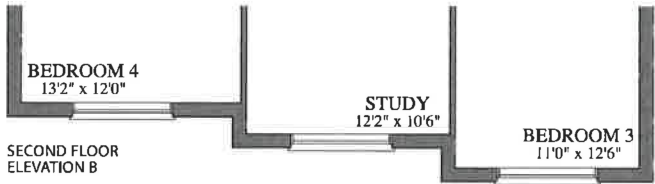


SECOND FLOOR
ELEVATION B


Delete dor from
hallway, extend the
vanity



BASEMENT
ELEVATION A

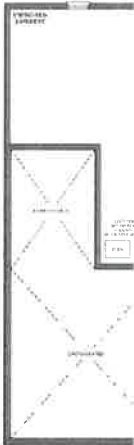

BASEMENT
ELEVATION B

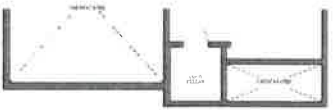

BASEMENT
ELEVATION C



Purchaser's Initial(s): MC Pf