



LIBERTY
CUSTOM CABINETRY

131B CARLAUREN RD., WOODBRIDGE, ONTARIO L4L 8A8
TEL: (905) 856-7678 • FAX: (905) 856-7379
www.libertycustomcabinetry.com

QUOTATION

DATE:

JOB NO.

TO: LeRMEZ

SHIP TO: LOT 5-54
INNISFIL

TYPE OF CABINETS:

FINISH OF CABINETS:

HARDWARE:

COUNTERTOP:


INSTALLATION:

☐ WITH

☐ WITHOUT

HOUSE TYPE:

REMARKS:

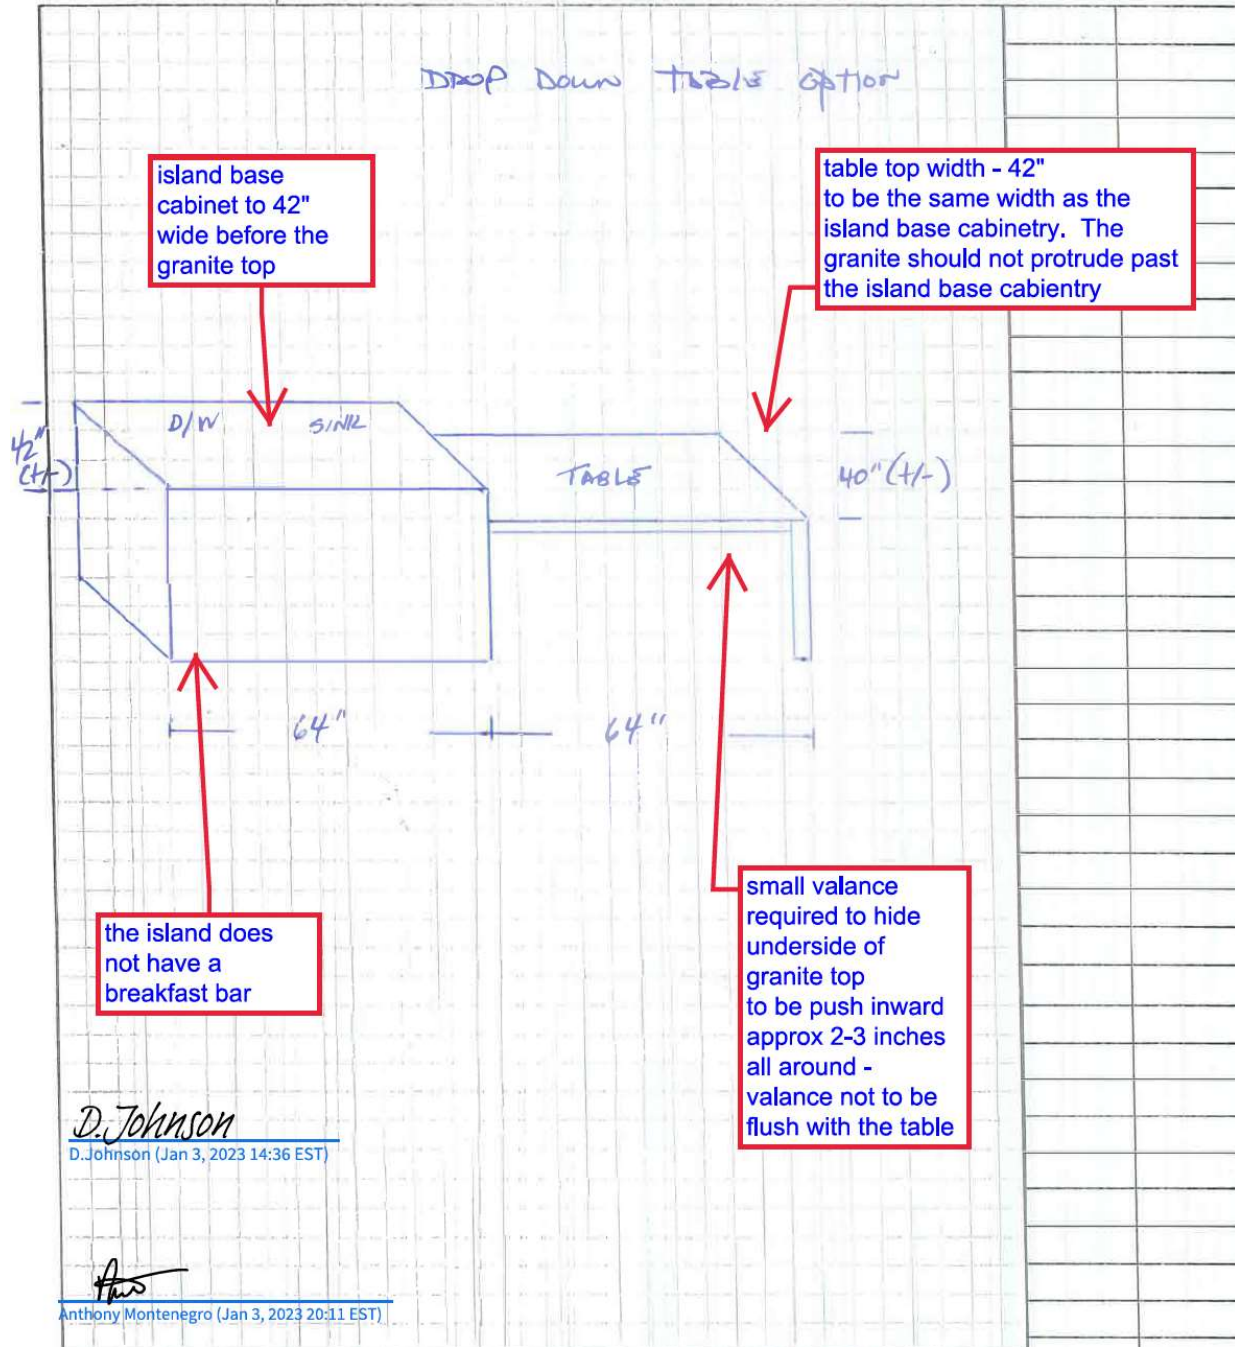

All prices subject to confirmation from head office.
Goods delivered shall be checked and inspected on delivery. We shall not be responsible for any claims or complaints after this inspection.

All agreements are contingent upon strikes, accidents, and delays beyond our control.

Please provide our installer with template for sinkholes or \$100.00 will be charged for callback.

ACCEPTED DATE: _____ TERMS: _____
LAYOUT THOROUGHLY EXPLAINED AND FULLY UNDERSTOOD

TOTAL \$

CUSTOMER SIGNATURE

SALESMAN'S SIGNATURE

LIBERTY
CUSTOM GABRIELTY

131B CARLAUREN RD., WOODBRIDGE, ONTARIO L4L 8A8
TEL: (905) 850-2070

TEL: (905) 856-7670 • FAX: (905) 856-7379

www.libertycustomcabinetry.com

QUOTATION

DATE-

JOB NO. _____

TO:

SHIP TO:

TYPE OF CABINETS:

FINISH OF CABINETS

HALDINARE:

COUNTERTOP:


INSTALLATION:

☐ WITH

☐ WITHOUT

HOUSE TYPE:

REMARKS:

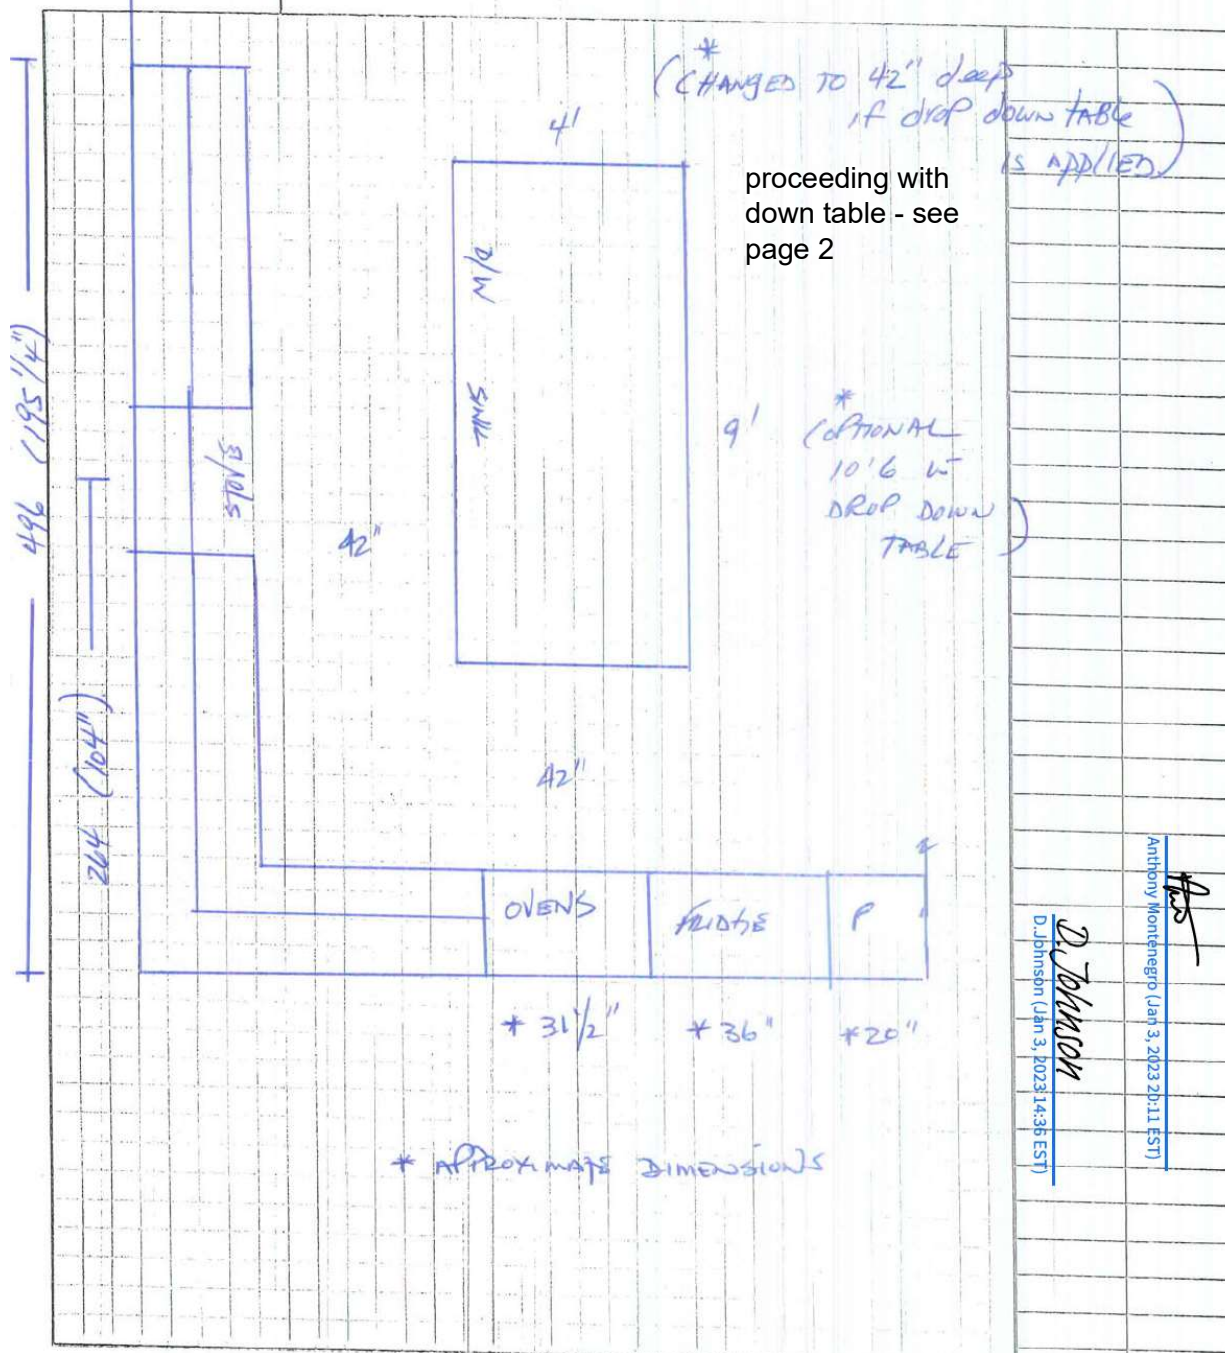

All prices subject to confirmation from head office.
Goods delivered shall be checked and inspected on delivery. We shall not be responsible for any claims or complaints after this inspection.

All agreements are contingent upon strikes, accidents, and delays beyond our control.

Please provide our installer with template for sinkholes or \$100.00 will be charged for callback.

ACCEPTED DATE:

TERMS:

LAYOUT THOROUGHLY EXPLAINED AND FULLY UNDERSTOOD

TOTAL \$

CUSTOMER SIGNATURE

SALESMAN'S SIGNATURE _____

Anthony Montenegro (Jan 3, 2023 20:11 EST)

D. Johnson
D. Johnson (Jan 3, 2023: 14:36 EST)