


LOT 5-17, PH5, PE003 SKETCH

38'
DESIGNS


The Superior /
3 Car Tandem 3400 sq.
2 Car Garage 3615 sq.ft. includes 748 sq. ft. of finished area in lower level

FUTURE CHIMNEY
HOODFAN

FRIDGE ENCLOSURE

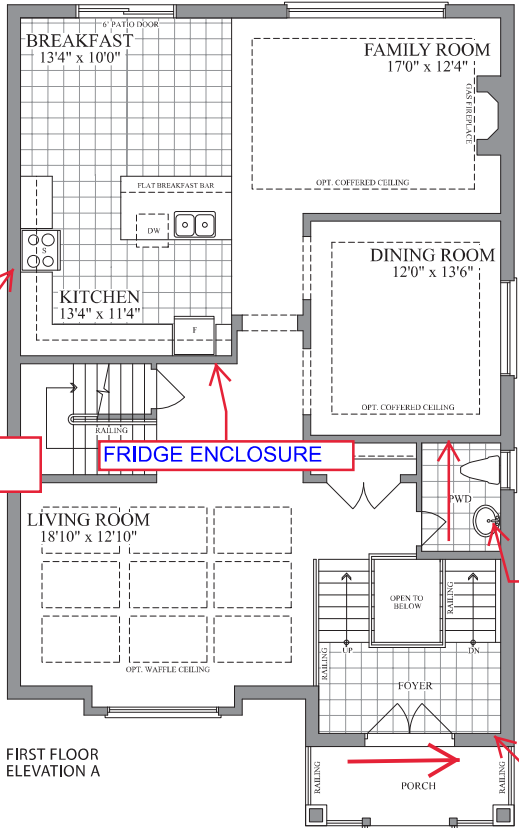


FIRST FLOOR
ELEVATION A

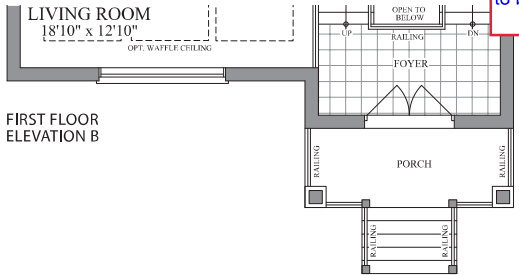


FIRST FLOOR
ELEVATION B

Purchaser's Initial(s): AM

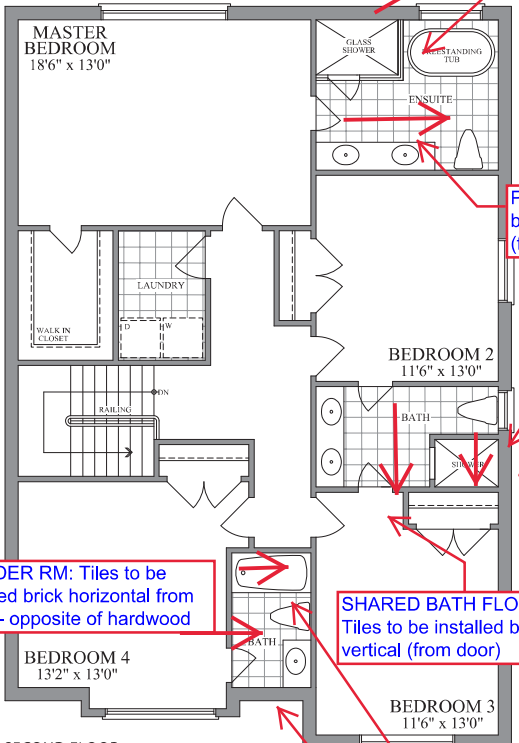

SECOND FLOOR
ELEVATION A

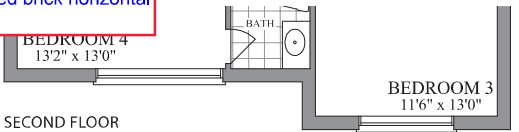

SECOND FLOOR
ELEVATION B

PRIMARY SHOWER: Tiles to be installed brick horizontal

PRIMARY FLOOR: Tiles to be installed brick vertical (form door)

FRAMELESS GLASS SHOWER ENCLOSURE (2 PANEL GLASS) W/ DOOR


SHARED BATH SHOWER: Tiles to be installed brick horizontal

SHARED BATH FLOOR: Tiles to be installed brick vertical (from door)


2nd ENSUITE TUB WALL: Tiles to be installed brick horizontal

2nd ENSUITE FLOOR: Tiles to be installed brick vertical (from door)

FOYER (MAIN LEVEL): Tiles to be installed brick horizontal

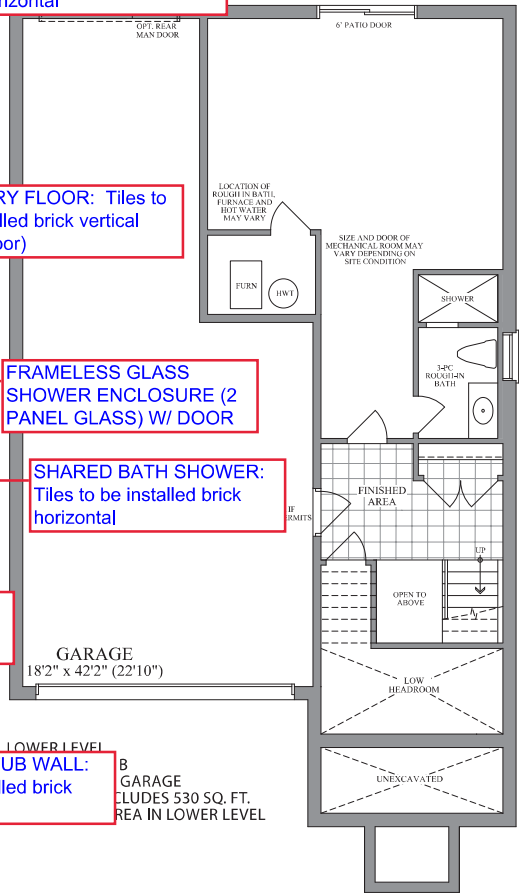

LOWER LEVEL
ELEVATION A & B
GARAGE INCLUDES 530 SQ. FT. OF FINISHED AREA IN LOWER LEVEL

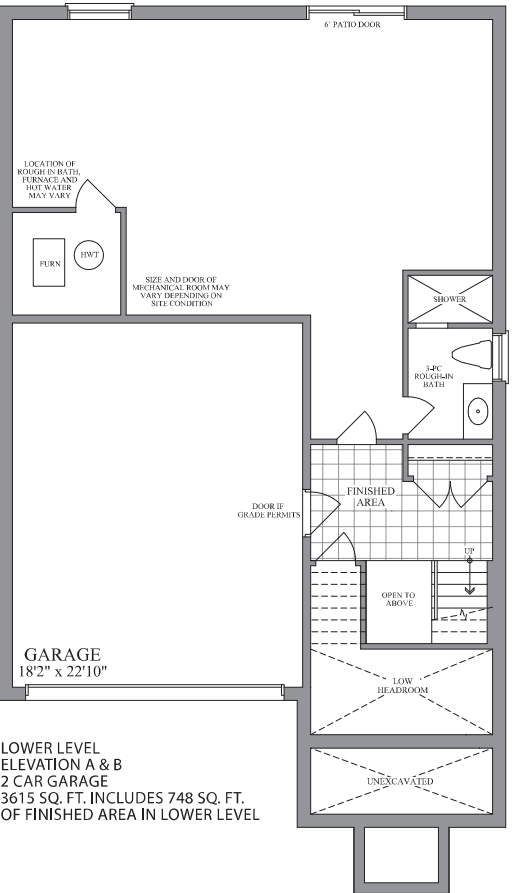

LOWER LEVEL
ELEVATION A & B
2 CAR GARAGE
INCLUDES 530 SQ. FT. OF FINISHED AREA IN LOWER LEVEL



Plans and specifications are subject to change without notice, E. & O. E. Actual usable floor space may vary from the stated floor area. All renderings are artist's concept.