



LOT 5-26, PH5, PE003, SKETCH

Purchaser's Initial(s): JT



47
DESIGN

The Kahn
3000 sq.ft.
Elev. A & B

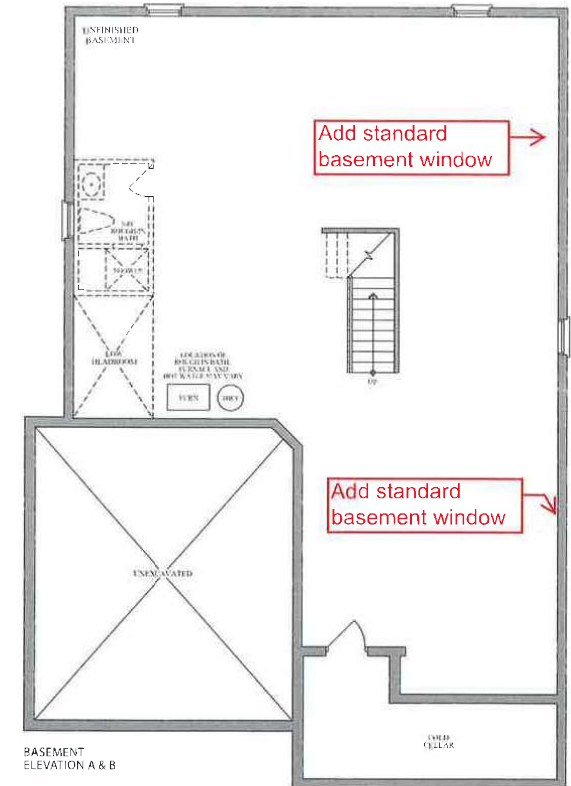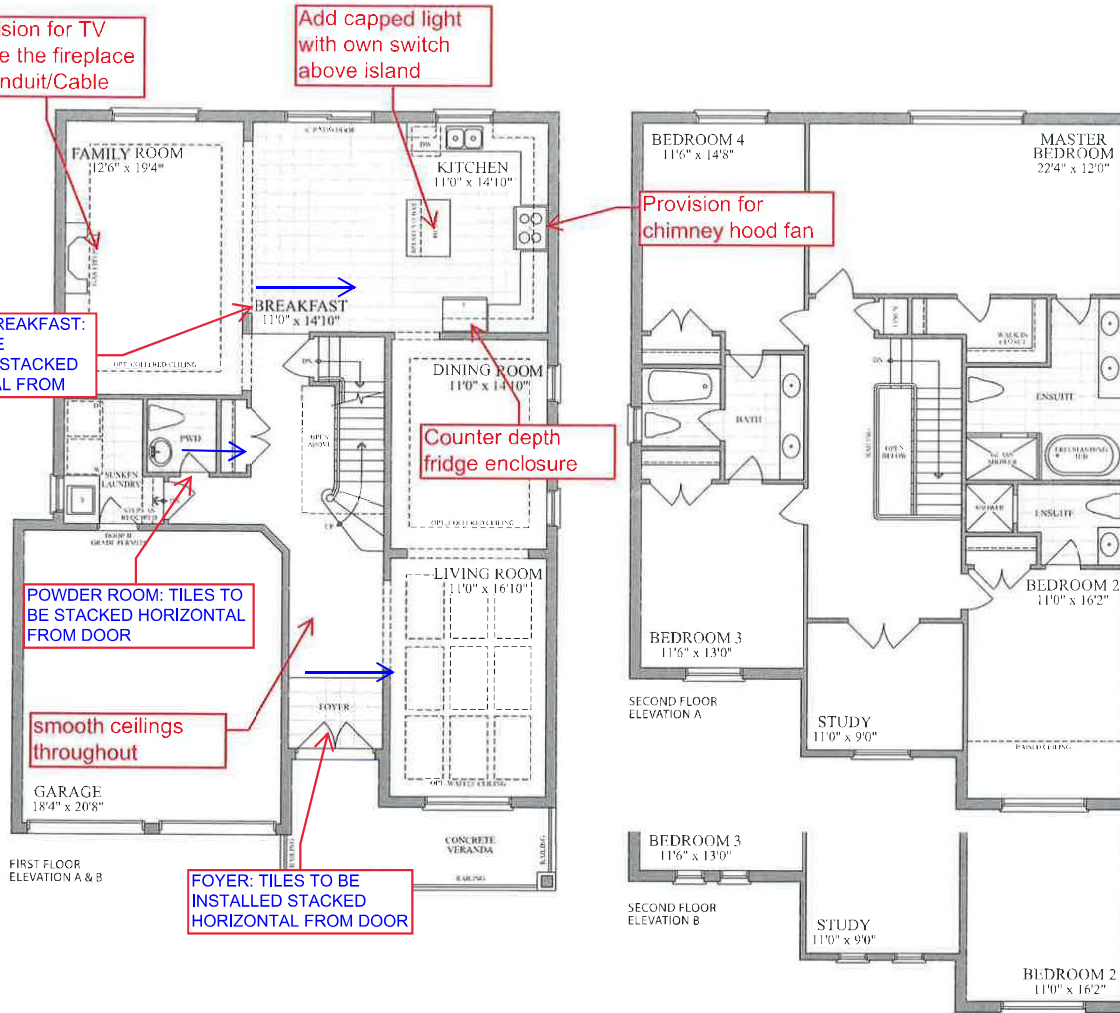

LOT 5-26, PH5, ~~PE002~~, ~~SKETCH~~

Purchaser: Jaswantkthind
(May 3, 2022 23:36 EDT)



Plans and specifications are subject to change without notice, E. & O. E. Actual usable floor space may vary from the stated floor area. All renderings are artist's concept.