


38'
DESIGNS

The Finlay / Elev. A & B
2515 sq.ft.

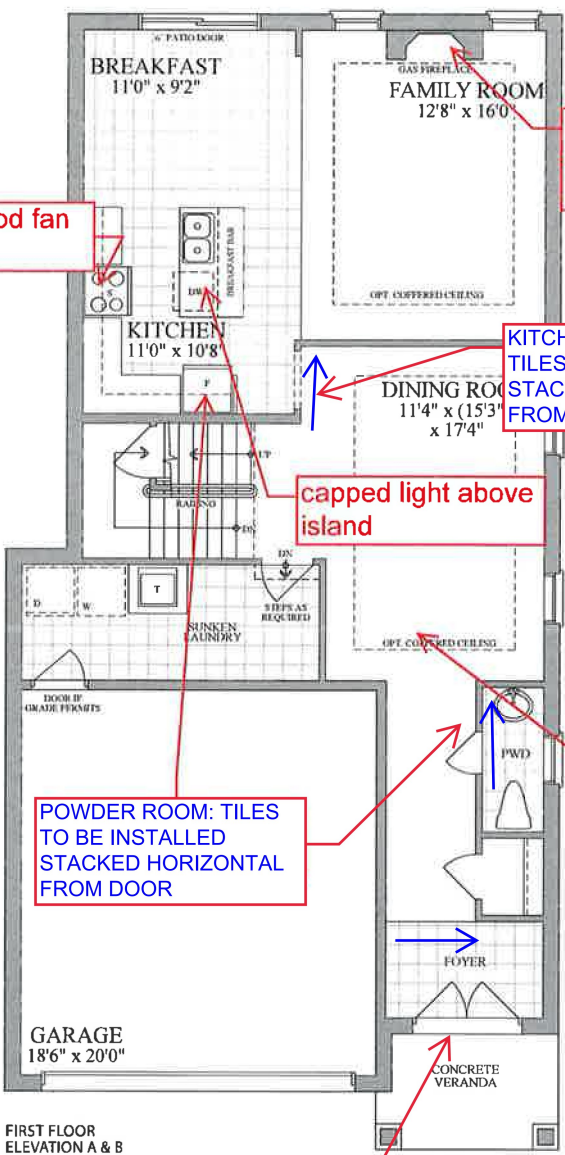

FIRST FLOOR
ELEVATION A & B


Provision for TV
above the fireplace
E/Conduit/Cable

KITCHEN/BREAKFAST:
TILES TO BE INSTALLED
STACKED HORIZONTAL
FROM DOOR

capped light above
island

POWDER ROOM: TILES
TO BE INSTALLED
STACKED HORIZONTAL
FROM DOOR

FOYER: TILES TO BE
INSTALLED STACKED
HORIZONTAL FROM DOOR

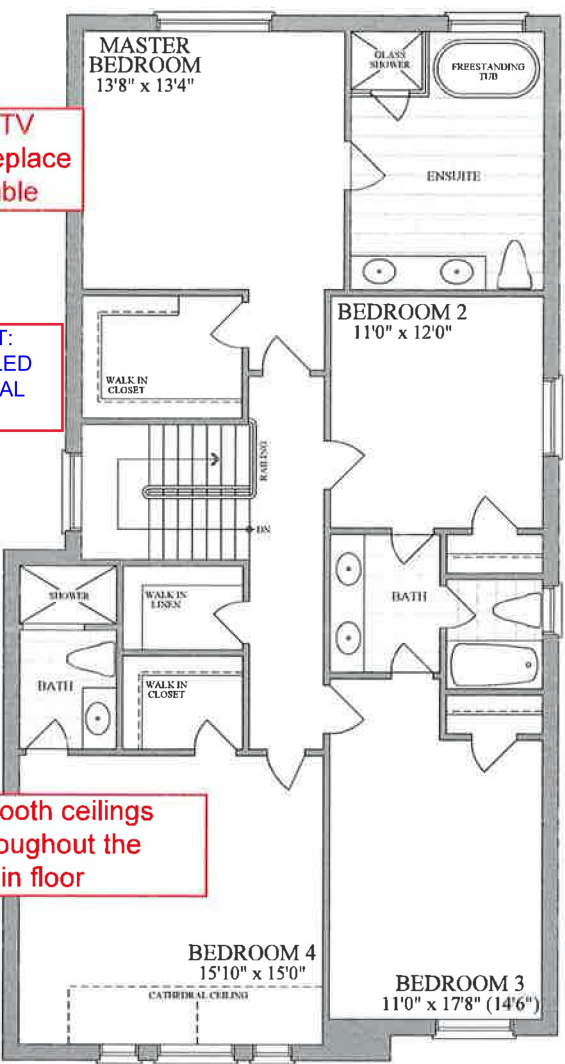


SECOND FLOOR
ELEVATION A



SECOND FLOOR
ELEVATION B

smooth ceilings
throughout the
main floor

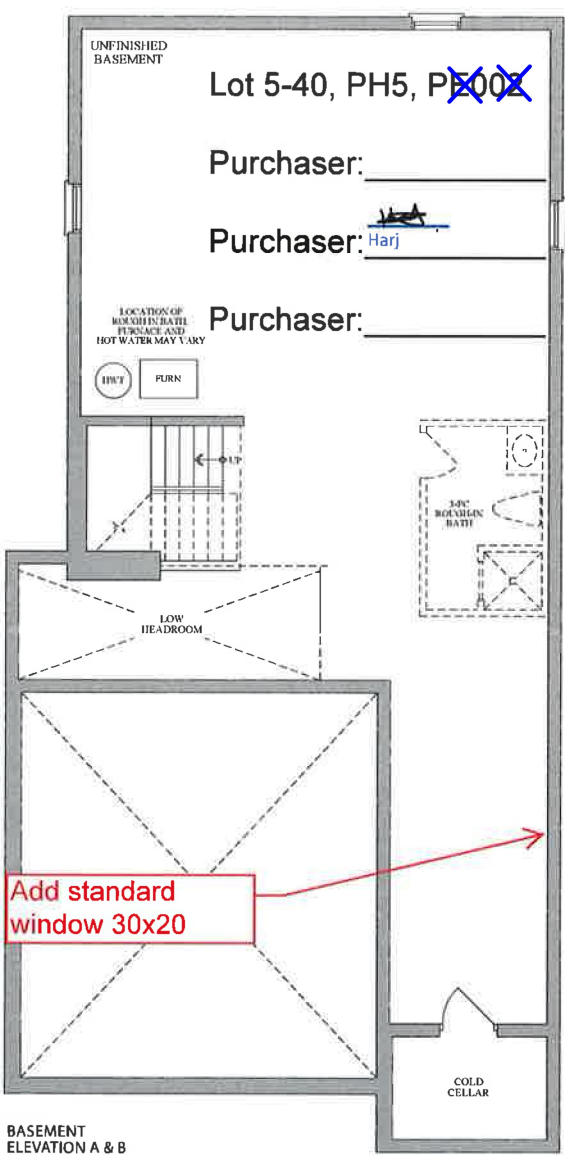

BASEMENT
ELEVATION A & B

Lot 5-40, PH5, PE003

Purchaser: _____

Purchaser: Harj

Purchaser: _____

Add standard
window 30x20

