

#### Town of Innisfil

2101 Innisfil Beach Road Innisfil | ON L9S 1A1 Phone: 705-436-3710

Phone: /05-436-3710 Toll Free: 1-888-436-3710

# NOTICE OF COMPLETION (FINAL)

Permit number: 2021-0388

Municipal address: 752 GREEN ST

Status of inspection: Completed

Permit type:

Legal address: PLAN 51M1169 LOT 66

Issue date: 2021-06-16

#### **Deficiencies**

No deficiencies or remarks noted.

#### **Visits**

VISIT DATE	INSPECTOR	VISIT RESULT	COMMENTS
2023-11-27, 11:50 a.m.	Tristan Munro	Passed (Substantially complete)	- The exterior of the building appears complete at the time of inspection. "Notice of Completion" is granted.

Acceptance and approval by a building inspector is required to continue with construction. If deficiencies are identified, you are required to book a re-inspection. Construction must not be concealed until infractions have been inspected by the Town of Innisfil and accepted by the building inspector. Failure to resolve outstanding concerns may result in the issuance of an Order.

#### **Parties**

NAME AND COMPANY	CONTACT DETAILS	ROLES
Zach De Meneghi Lormel Homes	331 Cityview Blvd, Unit 300, Vaughan (416) 576-7587	Applicant
BELLAIRE PROPERTIES INC	331 CITYVIEW BOULEVARD, Unit 300, VAUGHAN	Property owner
Roberto - Lormel Homes	+1 14166889324	Builder



#### CONSULTANT'S FINAL LOT GRADING CERTIFICATION LETTER

Date: September 8, 2023

Town of Innisfil 2101 Innisfil Beach Road Innisfil, ON L9S 1A1

Attention: Frank Ruffolo, Development Inspector

Dear Sir:

RE: Municipal Address: 752 Green Street, Innisfil

Lot or Block No.: Lot 66

Registered Plan No.: 51M-1169

Certification of Building and Final Lot Grading

I have inspected the complete lot grading and building elevations on the above lot, and do hereby certify that:

- 4. The lot grading and building elevations on the above referenced lot are:
  - o In conformity with the approved grading and site plans
  - Not in conformity with the approved plan, but have been constructed in accordance with sound engineering principles and vary from the approved plan as shown on the attached "as-built" plan, signed and stamped by the undersigned, subject to approval by the Town of Innisfil.
- 5. The water service "curb-stop" is located in the grassed portion of the front yard, is accessible, and is flush with finished grade.
- 6. The driveway conforms with minimum clearances listed in our Engineering Design Standards, Appendix C: Minimum Offset Matrix.


Sincerely,

IBW Surveyors Ltd.

Kevin Ertl, B.Eng, O.L.S.

September 8, 2023

Date

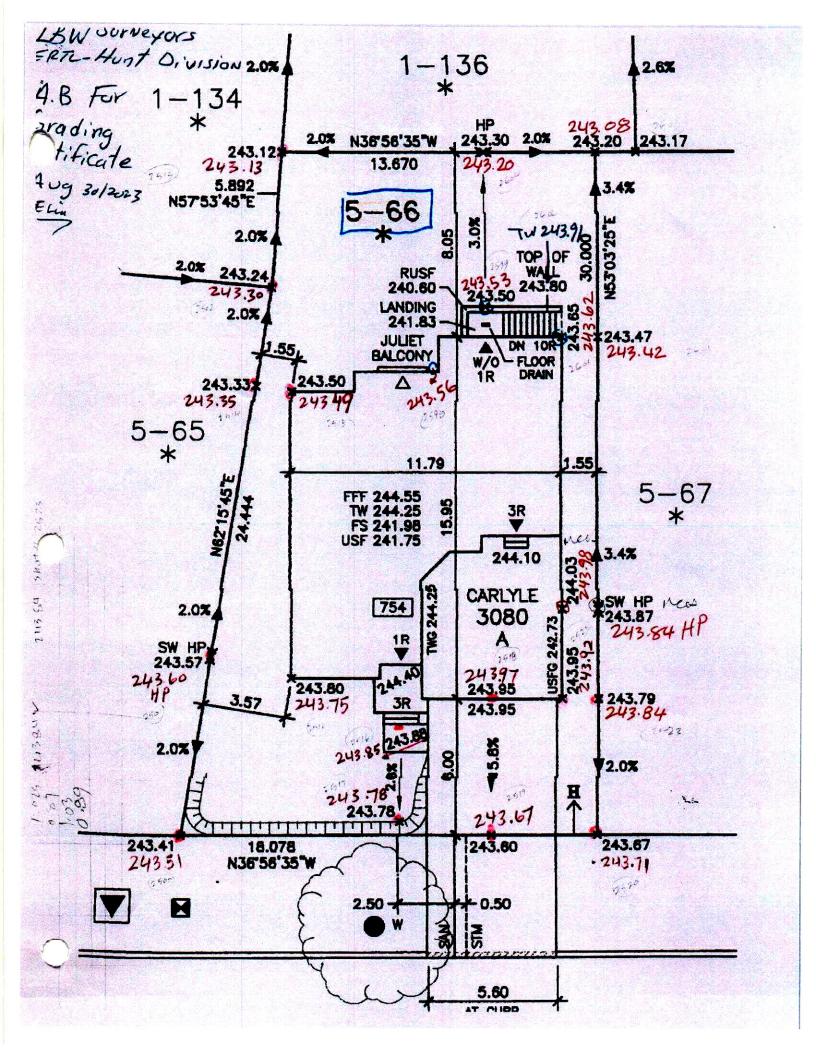

## Consultants Final Lot Grading Certification Letter



September 15, 2023

File No. 231437

Town of Innisfil
2101 Innisfil Beach Road
Innisfil, ON L9S 1A1

Attention: Fabian Van Romberg, Development Inspector:

Re:

**Municipal Address:** 

752 Green Street

Lot or Block No.:

Lot 66

Registered Plan No.:

2021-0388

Certification of building and final lot grading

Bellaire Properties Inc.

I have inspected the complete lot grading and building elevations on the above lot, and do hereby certify that:

- 1. The lot grading and building elevations on the above referenced lot are:
  - In conformity with the approved grading and site plans
  - □ Not in conformity with the approved plan, but have been constructed in accordance to sound engineering principles and vary from the approved plan as shown on the attached "as-built" plan, signed and stamped by the undersigned, subject to approval by the Town of Innisfil.
- The water service "curb-stop" is located in the grassed portion of the front yard, is accessible, and is flush with finished grade.

**HUSSON Limited** 

Name of Engineering Firm

Carmen Sframeli, P. Eng.

Professional Engineer's Name



ENGINEERING + MANAGEMENT

P 905.709.5825 OO CACHET WOODS COURT, SUITE 204

HUSSON,C

#### ZONING INFORMATION ZONE DESIGNATION R1-26 LOT AREA (sq m) 420.00 470.73 LOT FRONTAGE (m) 14.300 FRONT YARD SETBACK TO DWELLING (m) 4.50 6.91 FRONT YARD SETBACK TO GARAGE (m) 6.00 ONE INTERIOR SIDE YARD SETBACK (m) 1.20 1.55 OTHER INTERIOR SIDE YAR SETBACK (m) 1.20 REAR YARD SETBACK (m) 6.00 8.05 LOT COVERAGE (%) 40.00 36.02 BUILDING HEIGHT (m) 10.00 8.30 LANDSCAPED OPEN SPACE (%) 30.00 55.90 FRONT YARD LANDSCAPED OPEN SPACE (%) 40.00 68.25

STRUCTU	RE	
MODEL NO.	CARLYLE 3080A	
HOUSE STYLE (i.e. walkout, bungalow	2 STOREY WALK-UP	
	EAST	ARROWHEAD 2650A
ADJACENT MODEL	WEST	n/a
	NORTH	MADAWASKA 3190A
	SOUTH	KAHSHE 3000B
FIREBREAK LOT	NO	

### LEGEND

SINGLE CATCHBASIN DOUBLE CATCHBASIN O STORM MH

SANITARY SERVICE CONNECTION STORM SERVICE CONNECTION

WATER SERVICE CONNECTION FLOW DIRECTION

\* FNCINEERED FILL 000.00 EXISTING ELEVATION PROPOSED ELEVATION

FFF FINISHED 1ST FLOOR TW TOP OF FOUNDATION WALL

USF U/S FOOTING RUSF REAR U/S FOOTING TWG TOP OF GARAGE FOUNDATION WALL

USFG U/S FOOTING GARAGE SUMP PUMP

9 VALVE AND BOX HYDRANT AND VALVE BELL PEDESTAL

△ CABLE PEDESTAL

★ UNDERGROUND PEDESTAL -O- STREETLIGHT

P STREETLIGHT PEDESTAL

MB SUPER MAILBOX 1234 MUNICIPAL ADDRESS TTTTT SLOPE 3:1 MAXIMUM FOOTINGS LOWERED TO MAINTAIN 1.22m FROST PROTECTION

#### **GENERAL NOTES**

ALL SLOPES TO BE 3:1 MAX

THE BUILDER SHALL BE RESPONSIBLE FOR THE VERIFICATION OF HOUSE TYPE AND ELEVATION, PRIOR TO COMMENCEMENT OF CONSTRUCTION

#### BENCHMARK

#### **ELEVATION: 286.399**

ELEVATION IS BASED ON BENCHMARK No. 0011931U463S HAVING AN ELEVATION OF 286.399 METRES. LOCATION: TOWNSHIP OF CHURCHILL UNITED CHURCH, TABLET IN NORTH STONE FOUNDATION WALL OF TOWER, 23cm FROM NORTHWEST CORNER AND 1.62m BELOW BRICKWORK.

#### SERVICING CHECK BOX WATER SERVICE AT P/L SANITARY SERVICE AT P/L STORM SERVICE AT PA DEPTH INVERT DEPTH DEPTH INVERT

# THIS IS AN ENGINEERED FILL LOT. \* THE SUITABILITY OF THE FOUNDATION SOIL IS TO BE CONFIRMED BY A GEOTECHNICAL ENGINEER.


THE UNDERSIGNED HAS REVIEWED AND TAKES RESPONSIBILITY FOR THE ARCHITECTURAL PORTION OF THIS PLAN AND HAS THE QUALIFICATIONS AND MEETS THE REQUIREMENTS SET OUT IN THE ONTARIO BUILDING CODE TO BE A DESIGNER. QUALIFICATION INFORMATION

LEO ARIEMMA 7561 SIGNATURE LICENCE NUMBER







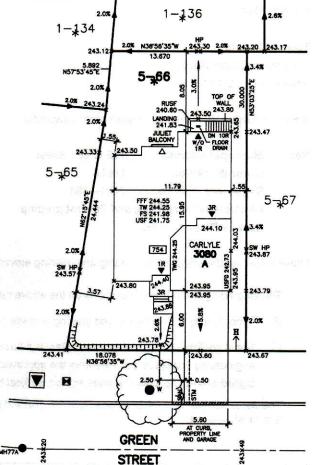



ISSUED	AP 06 21	TP
REVISED PER COLE REVIEW	AP 09 21	TP
AS BUILT	SE 15 23	BJJ
	ADDED BASEMENT WALK-UP REVISED PER COLE REVIEW	ADDED BASEMENT WALK-UP AP 10 21 REVISED PER COLE REVIEW AP 09 21

## ARCHITECTURAL DESIGN INC.



56 PENNSYLVANIA AVE. UNIT 1 CONCORD, ONTARIO L4K 3V9 TEL 905 660-9393 FAX 905 660-9419

adci@bellnet.ca

ASSOCIATE ARCHITECTS 2



DRAWINGS MUST NOT BE SCALED

THE PROPOSED LOT GRADING IS APPROVED AS BEING IN GENERAL CONFORMITY WITH THE OVERALL APPROVED GRADING PLAN FOR THIS SUBDIMISION

COMPANY NAME: HUSSON ENGINEERING C. SFRAMELI

APPROVED BY

DATE:

**SEPTEMBER 15, 2023** 

752 GREEN STREET LOT 66, PLAN 51M-1169 PHASE 5, STAGE BELLAIRE PROPERTIES INC. PARCEL P1 - LEFROY TOWN OF INNISFIL

SCALE:	1:250		
DATE:	APR 2021		
DRAWN:	T.P.		
DESIGNED:	T.P.		

DRAWING No. A-1