


SUITE 313

Purchaser's Initial(s):

A.S.


KAZ-11

Frameless mirrored
sliding doors

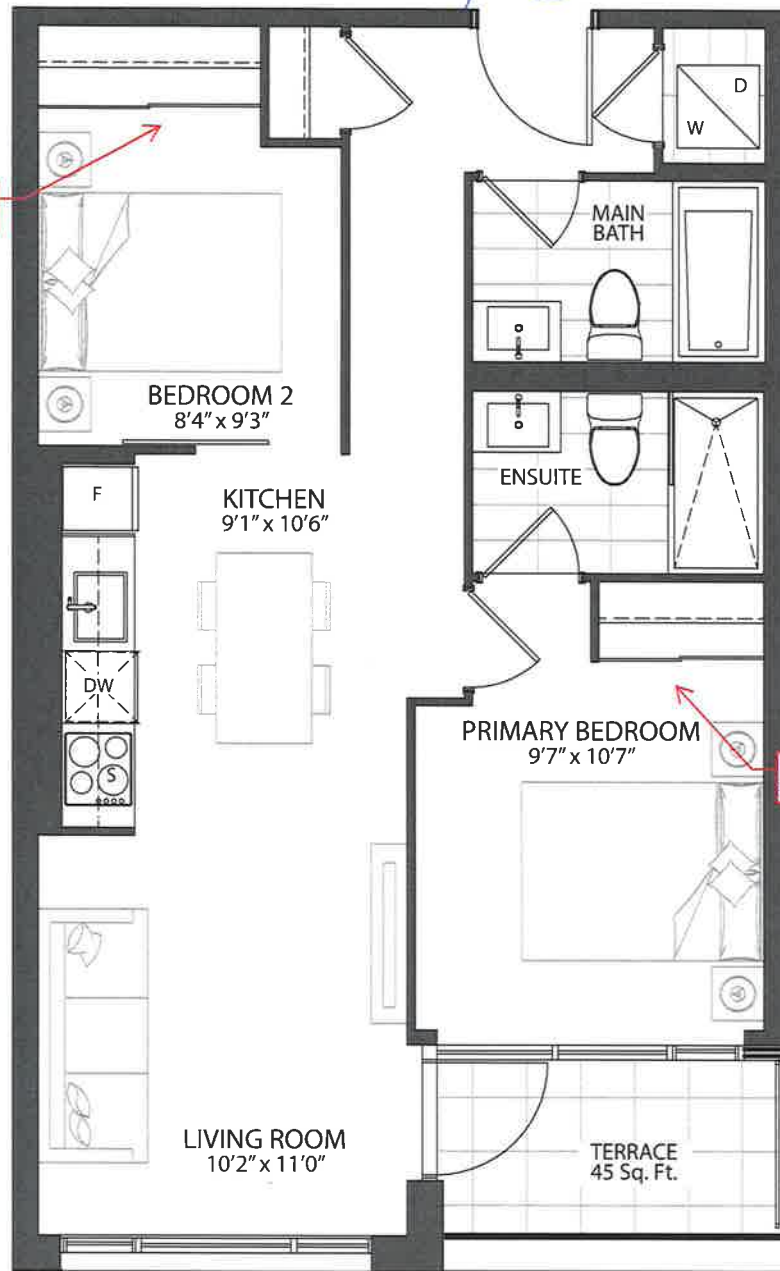


Frameless mirrored
sliding doors


LORMEL
KAZMIR
213-313-411 - 2B (665 SF)

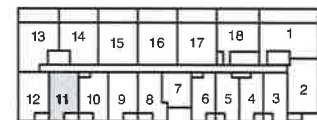

FLOOR 4

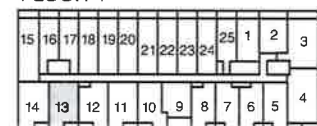

FLOOR 3

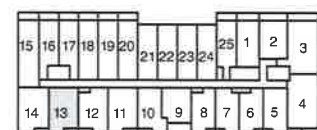

FLOOR 2