

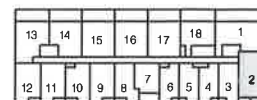



A-R

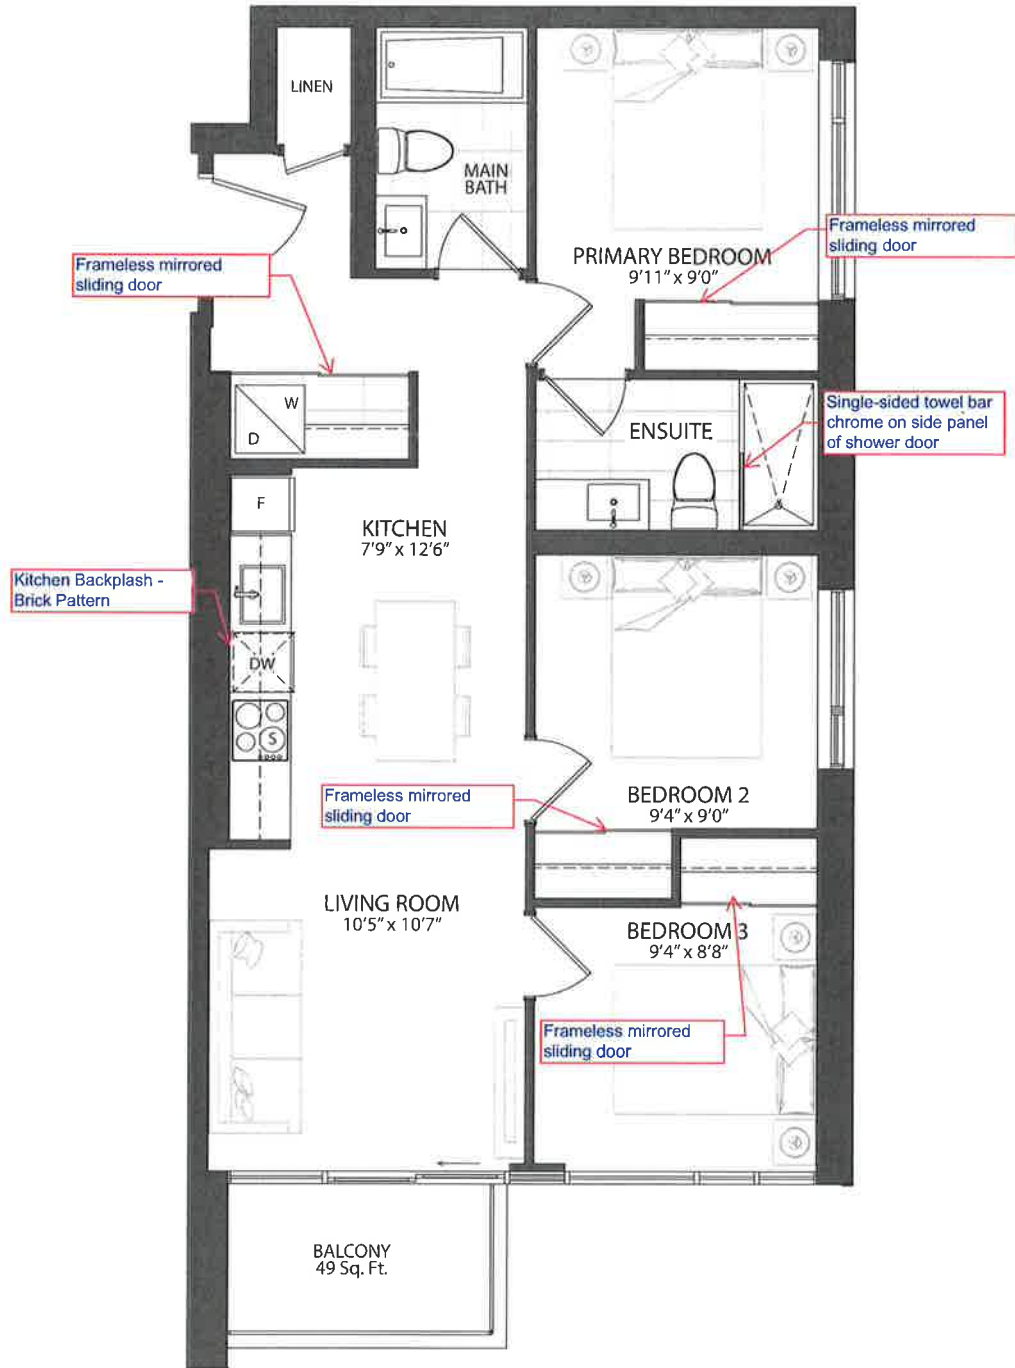

FLOOR 4

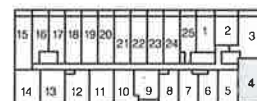

FLOOR 3

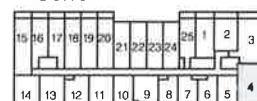

FLOOR 2

LORMEL
KAZMIR
204-304-402 - 3B (823 SF)