




~~SP~~
J.A.
JA

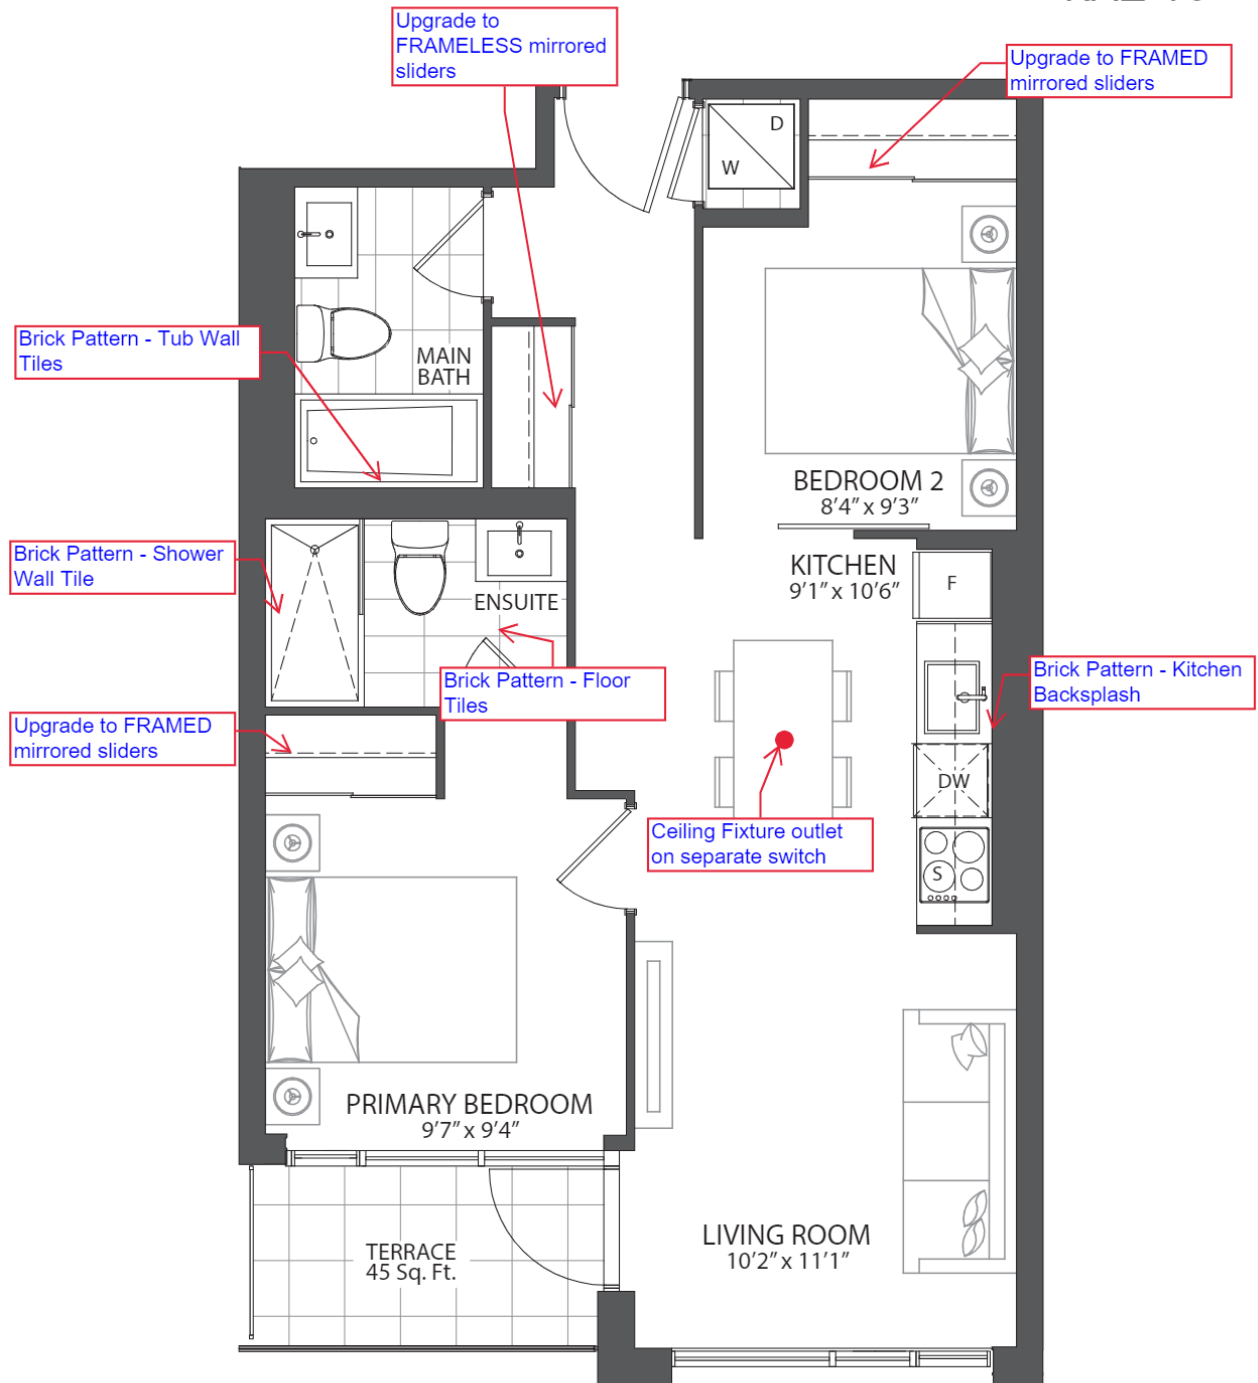