

SUITE 502

KAZ-32

Purchaser's Initial(s): AK


JK

KITCHEN
BACKSLASH -
STANDARD TILES TO
BE INSTALLED IN
BRICK PATTERN

UPGRADE - FRAMED
MIRRORED SLIDERS

UPGRADE - FRAMED
MIRRORED SLIDERS

UPGRADE - FRAMED
MIRRORED SLIDERS

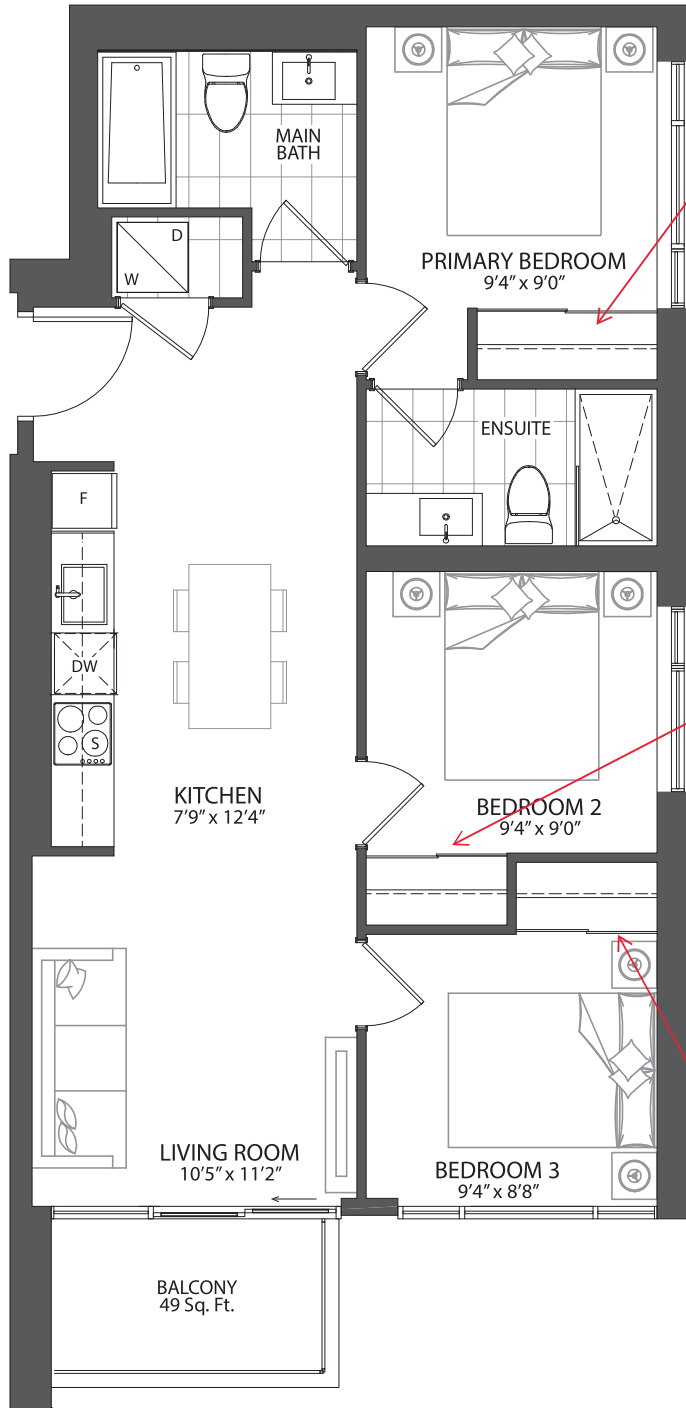

LORMEL
KAZMIR
502 - 3B (816 SF)

