


SUITE 511

Purchaser's Initial(s): _____

KAZ-35

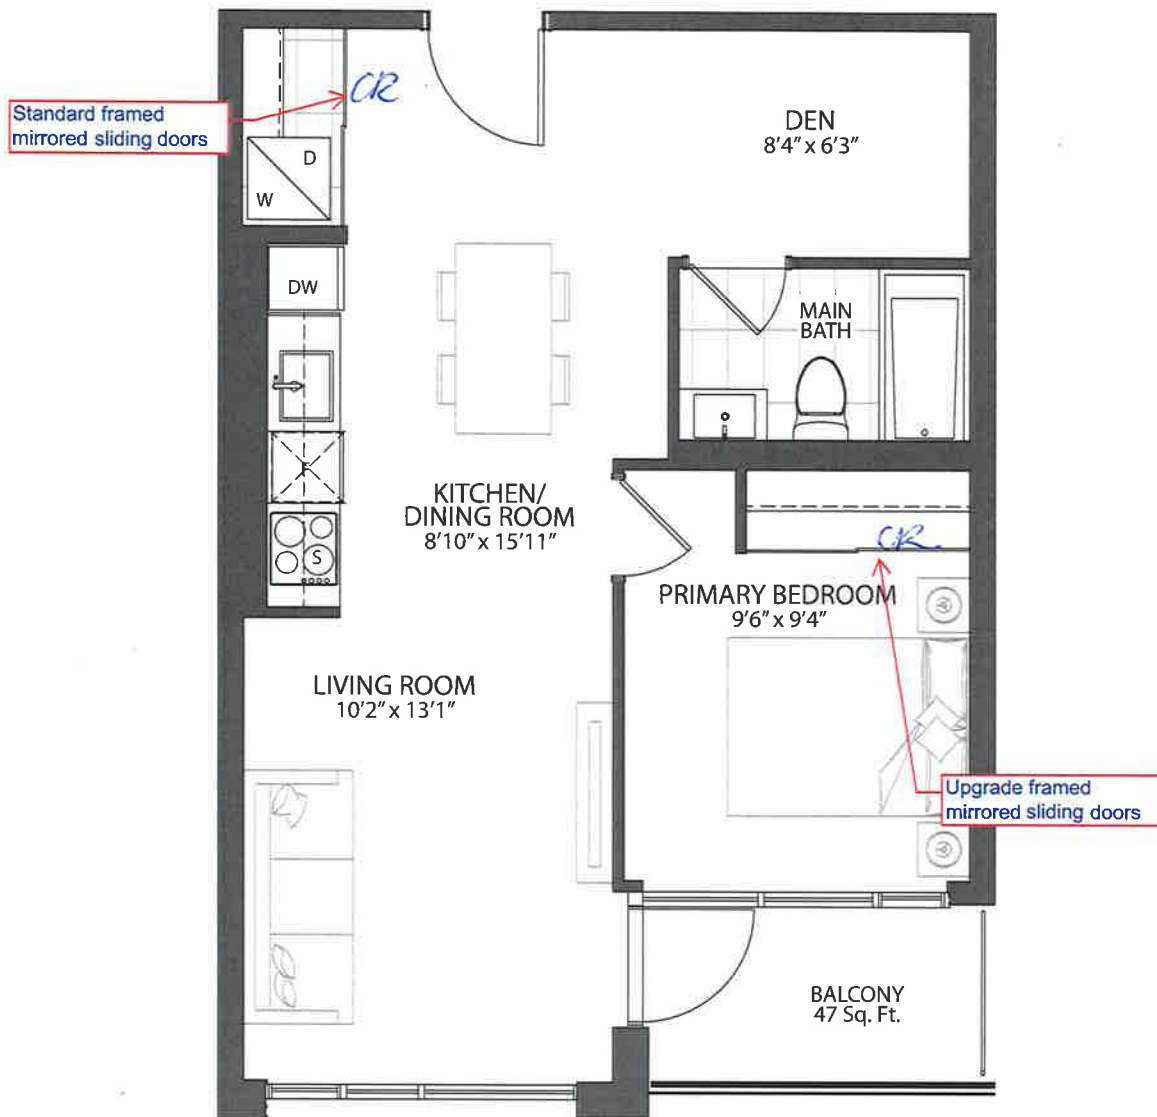

LORMEL
KAZMIR
511 - 1B + DEN (576 SF)

