



SUITE 708

LC *LC*

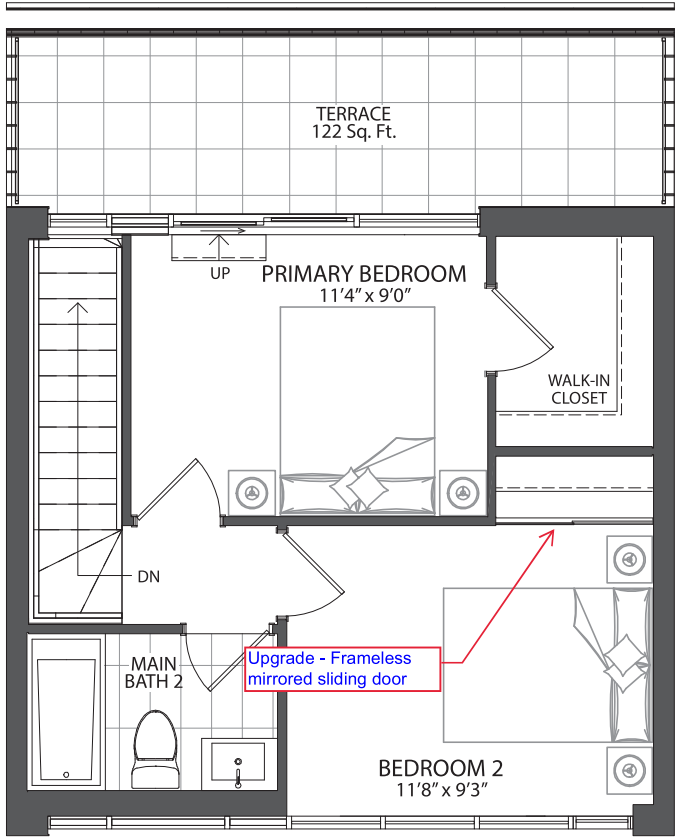

8TH FLOOR UPPER

KAZ-PH-8

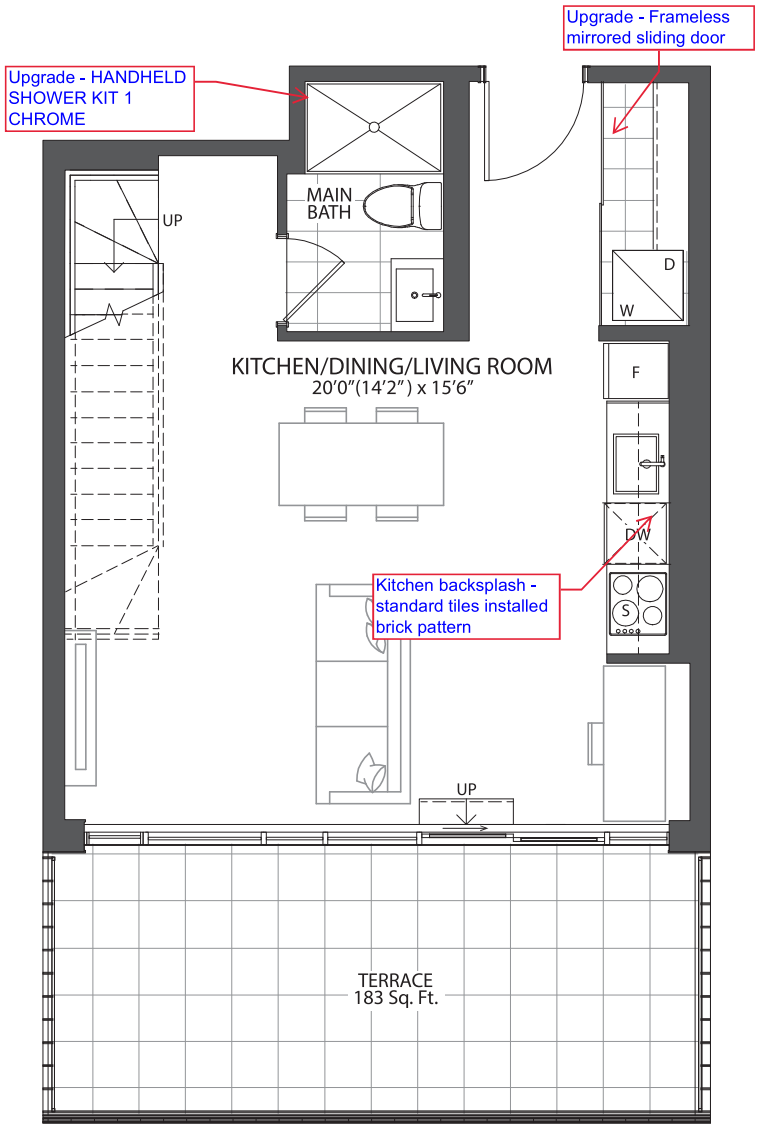

7TH FLOOR LOWER

LORMEL
KAZMIR
708 - 2B (903 SF)

