




SECOND FLOOR

LORMEL
KAZMIR

221-222-223-224 - 1R (543 SF)

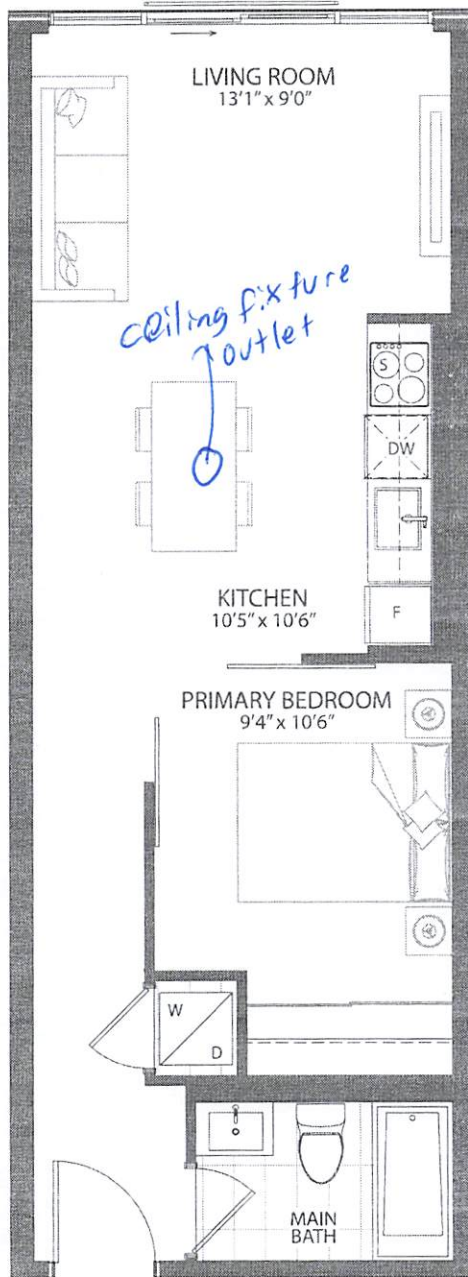