
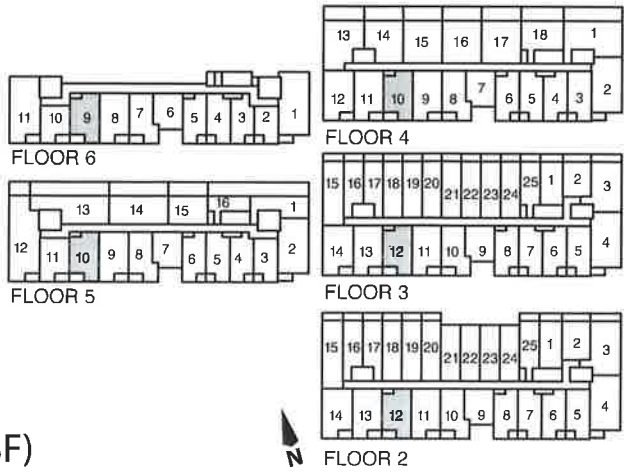


KAZ-10

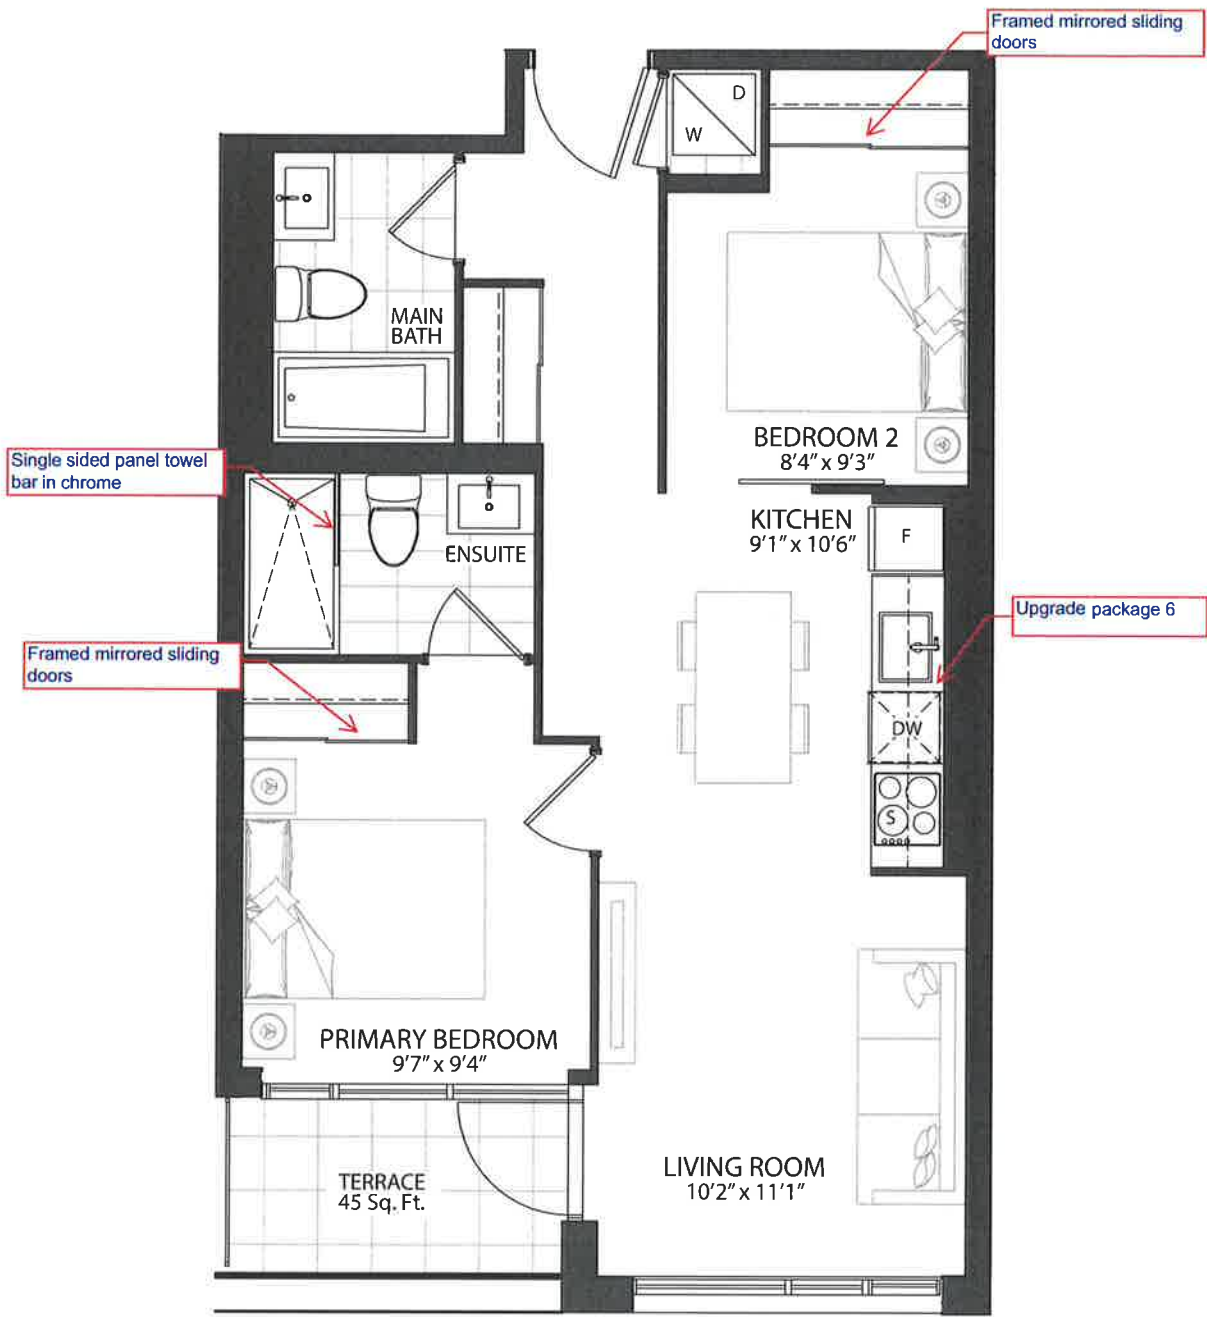

LORMEL
KAZMIR
212-312-410-510-609 - 2B (641 SF)