



SUITE 709

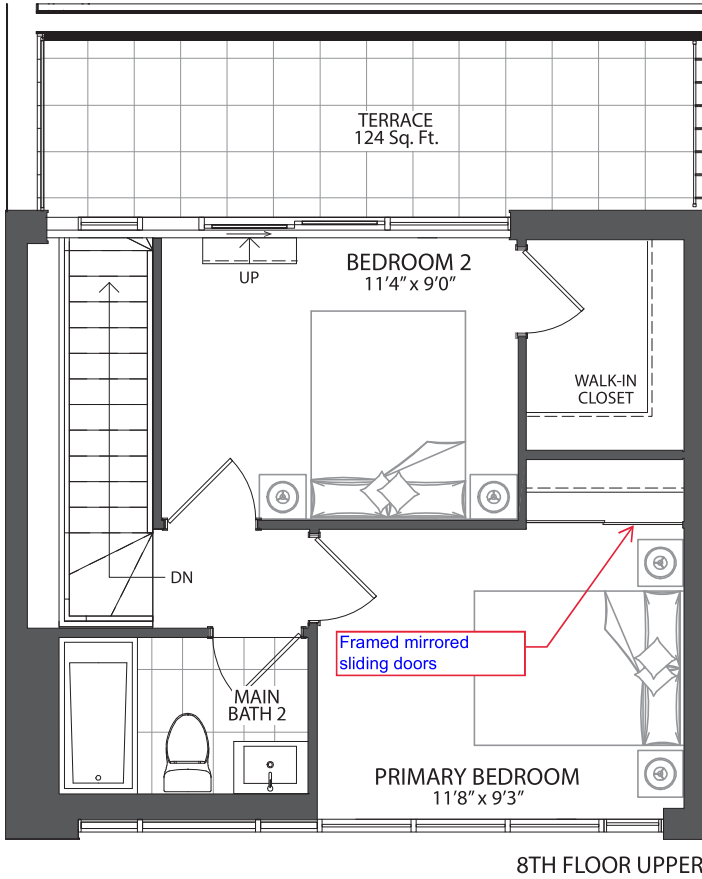

KAZ-PH-9

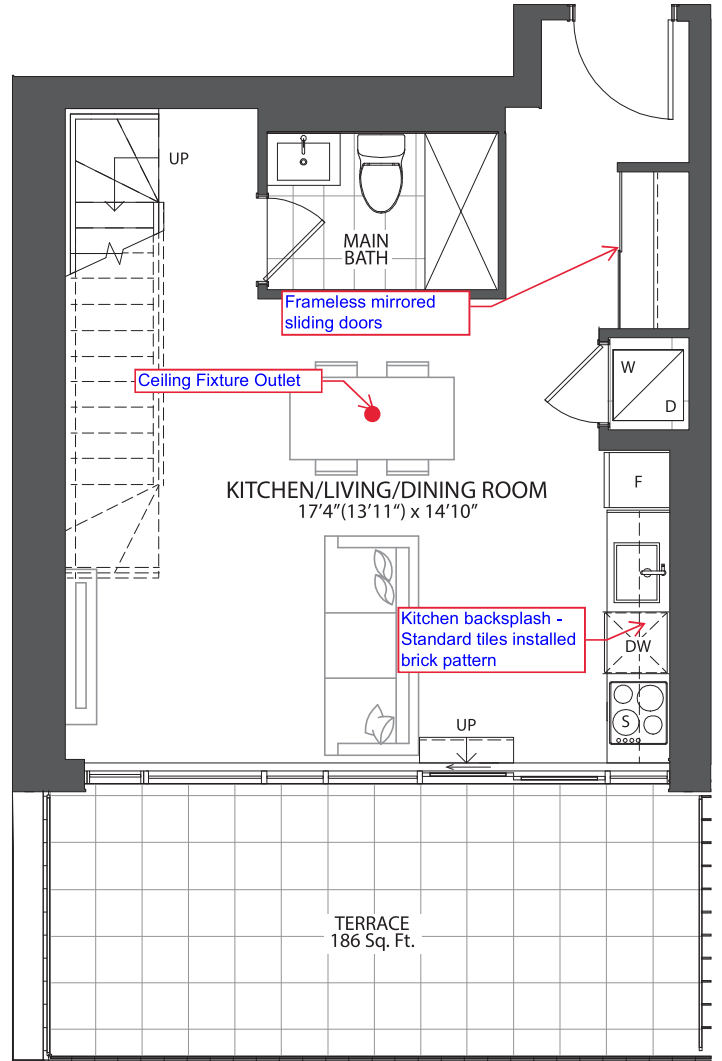

7TH FLOOR LOWER

LORMEL
KAZMIR
709 - 2B (943 SF)

