Consultants Final Lot Grading Certification Letter



April 30, 2024

File No. 231437

Town of Innisfil

2101 Innisfil Beach Road Innisfil, ON L9S 1A1

Attention: Fabian Van Romberg, Development Inspector:

Re: Municipal Address: 1425 Stovell Crescent

Lot or Block No.: Lot 35
Registered Plan No.: 2021-1170

Certification of building and final lot grading

Bellaire Properties Inc.

I have inspected the complete lot grading and building elevations on the above lot, and do hereby certify that:

- 1. The lot grading and building elevations on the above referenced lot are:
 - oxdot In conformity with the approved grading and site plans
 - □ Not in conformity with the approved plan, but have been constructed in accordance to sound engineering principles and vary from the approved plan as shown on the attached "as-built" plan, signed and stamped by the undersigned, subject to approval by the Town of Innisfil.
- 2. The water service "curb-stop" is located in the grassed portion of the front yard, is accessible, and is flush with finished grade.

HUSSON Limited

Name of Engineering Firm

Carmen Sframeli, P. Eng.

Professional Engineer's Name

ZONING INFORMATION			
ZONE DESIGNATION R2-15	PERMITTED	PROVIDED	
LOT AREA (sq m)	335.00	348.00	
LOT FRONTAGE (m)	11.500	11,600	
FRONT YARD SETBACK TO DWELLING (m)	4.50	7.02	
FRONT YARD SETBACK TO GARAGE (m)	6.00	6.00	
ONE INTERIOR SIDE YARD SETBACK (m)	0.60	1.25	
OTHER INTERIOR SIDE YARD SETBACK (m)	1.20	1.92	
REAR YARD SETBACK (m)	6.00	9.17	
LOT COVERAGE (%)	40.00	30.87	
BUILDING HEIGHT (m)	11.00	8.70	
LANDSCAPED OPEN SPACE (%)	30.00	59.52	
FRONT YARD LANDSCAPED	40.00	56.90	

STRUCTU	RE	
MODEL NO.		BUCKHORN 1800B
HOUSE STYLE (i.e. walkout, bungalow	etc.)	2 STOREY
ADJACENT MODEL	EAST	MANITOU 2480B
	WEST	N/A
	NORTH	N/A
	SOUTH	N/A
FIREBREAK LOT		NO
LEGEND		

	· · · · · · · · · · · · · · · · · · ·
LEGE	ND
	SINGLE CATCHBASIN
	DOUBLE CATCHBASIN
-	SANITARY MH
	SANITARY SERVICE CONNECTION
	STORM SERVICE CONNECTION
	WATER SERVICE CONNECTION
	FLOW DIRECTION
ightharpoonup	ROOF DRAIN
*	ENGINEERED FILL
000.00	EXISTING ELEVATION
000.00	PROPOSED ELEVATION
FFF	FINISHED 1ST FLOOR
TW	TOP OF FOUNDATION WALL
FS	FINISHED SLAB
USF	U/S FOOTING
RUSF	REAR U/S FOOTING
TWG	TOP OF GARAGE FOUNDATION WALL
USFG	U/S FOOTING GARAGE
()>	
•	VALVE AND BOX
ϕ	HYDRANT AND VALVE
×	
Δ	
*	
	HYDRO TRANSFORMER
✡	STREETLIGHT
P	STREETLIGHT PEDESTAL
\longrightarrow H	HYDRO SERVICE CONNECTION
MB	SUPER MAILBOX
1234	MUNICIPAL ADDRESS
7777	SLOPE 3:1 MAXIMUM
AR ARE DRIVE DAY AND ARE DRIVE	FOOTINGS LOWERED TO MAINTAIN 1.22m FROST PROTECTION

GENERAL NOTES

E BUILDER SHALL BE RESPONSIBLE R THE VERIFICATION OF HOUSE PE AND ELEVATION, PRIOR TO MMENCEMENT OF CONSTRUCTION

BENCHMARK

ELEVATION: 286.399

LEVATION IS BASED ON BENCHMARK

0. 0011931U463S HAVING AN

LEVATION OF 286.399 METRES.

0CATION: TOWNSHIP OF CHURCHILL

NITED CHURCH, TABLET IN NORTH

TONE FOUNDATION WALL OF TOWER,

3cm FROM NORTHWEST CORNER


ND 1.62m BELOW BRICKWORK.


SERVICING CHECK BOX WATER SERVICE AT P/L SANITARY SERVICE AT P/L STORM SERVICE AT P/L INVERT DEPTH INVERT DEPTH

LEO ARIEMMA		
QUALIFICATION INFOR	RMATION	
FOR THE ARCHITECT	TURAL PORTION OF AND MEETS THE R	TAKES RESPONSIBILITY THIS PLAN AND HAS EQUIREMENTS SET OUT E A DESIGNER.





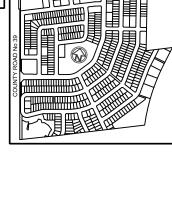

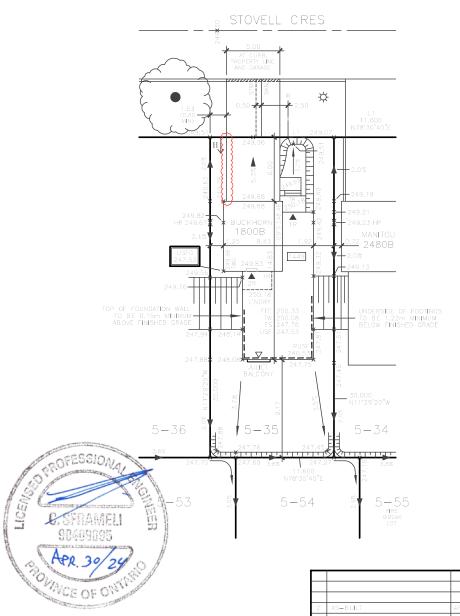

ARCHITECTURAL DESIGN INC.



56 PENNSYLVANIA AVE. UNIT 1 CONCORD, ONTARIO L4K 3V9

TEL 905 660-9393 FAX 905 660-9419 adcı@bellnet.ca



THE CONTRACTOR SHALL CHECK AND VI ALL DIMENSIONS ON THE SITE AND REPO ANY DISCREPANCIES TO THE ARCHITECT

DRAWINGS MUST NOT BE SCALED

BEING IN GENERAL CONFORMITY WITH THE OVERALL APPROVED GRADING PLAN FOR THIS SUBDIVISION. COMPANY NAME: HUSSON ENGINEERING APPROVED BY:

DATE:

THE PROPOSED LOT GRADING IS APPROVED AS

1425 STOVELL CRESCENT LOT 35, PLAN 51M-1169 PHASE 5, STAGE BELLAIRE PROPERTIES INC. PARCEL P1 - LEFROY TOWN OF INNISFIL

SCALE: DATE: DRAWN:

DESIGNED: T.P.

DRAWING No: A-1