# Consultants Final Lot Grading Certification Letter



April 30, 2024

File No. 231437

#### **Town of Innisfil**

2101 Innisfil Beach Road Innisfil, ON L9S 1A1

Attention: Fabian Van Romberg, Development Inspector:

Re: Municipal Address: 1583 Stovell Crescent

Lot or Block No.: Lot 61
Registered Plan No.: 2021-1212

Certification of building and final lot grading

Bellaire Properties Inc.

I have inspected the complete lot grading and building elevations on the above lot, and do hereby certify that:


- 1. The lot grading and building elevations on the above referenced lot are:
  - oxdot In conformity with the approved grading and site plans
  - □ Not in conformity with the approved plan, but have been constructed in accordance to sound engineering principles and vary from the approved plan as shown on the attached "as-built" plan, signed and stamped by the undersigned, subject to approval by the Town of Innisfil.
- 2. The water service "curb-stop" is located in the grassed portion of the front yard, is accessible, and is flush with finished grade.

HUSSON Limited

Name of Engineering Firm

Carmen Sframeli, P. Eng.

Professional Engineer's Name

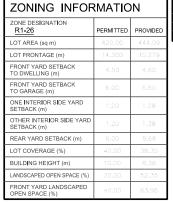

STRUCTURE		
MODEL NO.		NIPISSING 3210B
HOUSE STYLE (i.e. walkout, bungalow etc.)		2 STOREY WALK-UP
ADJACENT MODEL	EAST	N/A
	WEST	KAHSHE 3000A
	NORTH	N/A
	SOUTH	N/A
FIREBREAK LOT		ND

#### LEGEND

SINGLE CATCHBASIN DOUBLE CATCHBASIN SANITARY MH

O STORM MH

SANITARY SERVICE CONNECTION
STORM SERVICE CONNECTION
WATER SERVICE CONNECTION

ROOF DRAIN
ROOF BRAIN
ROOF BRAIN
000.00 PROPOSED ELEVATION

FFF FINISHED 1ST FLOOR
TW TOP OF FOUNDATION WALL

FS FINISHED SLAB

USF U/S FOOTING RUSF REAR U/S FOOTING TWG TOP OF GARAGE FOUNDATION WALL

U/S FOOTING GARAGE

SUMP PUMP
VALVE AND BOX
HYDRANT AND

△ CABLE PEDESTAL

\*\* UNDERGROUND PEDES

• HYDRO TRANSFORMER

. □ STREETLIGHT STREETLIGHT PEDESTAL

HYDRO SERVICE CONNECTION

SUPER MAILBOX

MUNICIPAL ADDRESS SLOPE 3:1 MAXIMUM FOOTINGS LOWERED TO MAINTAIN 1.22m FROST PROTECTION

#### **GENERAL NOTES**

HE BUILDER SHALL BE RESPONSIBLE OR THE VERIFICATION OF HOUSE YPE AND ELEVATION, PRIOR TO COMMENCEMENT OF CONSTRUCTION

### BENCHMARK

ELEVATION: 286.399

LEVATION, 200.000

LEVATION IS BASED ON BENCHMARK

LOOD 1931U463S HAVING AN

LEVATION OF 286,399 METRES,

OCATION: TOWNSHIP OF CHURCHILL

INITED CHURCH, TABLET IN NORTH

STORM FOUNDATION WALL OF TOWER,

1,55cm FROM NORTHWEST CORNER

IND 1.62m BELOW BRICKWORK.

# WALK-UP DETAIL

SERVICING CHECK BOX

QUALIFICATION INFORMATION

INVERT

WATER SERVICE AT P/L

SANITARY SERVICE AT P/L

INVERT


NDERSIGNED HAS REMEWED AND TAKES RESPONSIBILITY HE ARCHITECTURAL PORTION OF THIS PLAN AND HAS UALIFICATIONS AND MEETS THE REQUIREMENTS SET OUT ONTARIO BUILDING CODE TO BE A DESIGNER.

DEPTH

INVERT

DEPTH



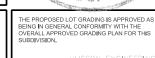




C. SFRAMELI

90409095





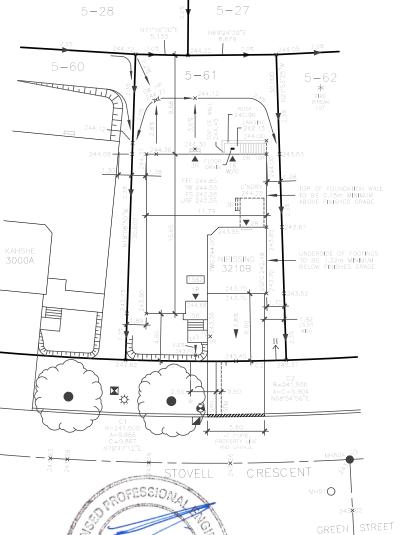

## ARCHITECTURAL DESIGN INC.



56 PENNSYLVANIA AVE. UNIT 1 CONCORD, ONTARIO L4K 3V9

TEL 905 660-9393 FAX 905 660-9419 adcı@bellnet.ca



RAWINGS AND SPECIFICATIONS ARE THE ERTY OF THE ARCHITECT AND CANNOT B OR REPRODUCED WITHOUT HIS APPROVA

THE CONTRACTOR SHALL CHECK AND VERIFY ALL DIMENSIONS ON THE SITE AND REPORT ANY DISCREPANCIES TO THE ARCHITECT

1583 STOVELL CRESCENT LOT 61, PLAN 51M-1169 PHASE 5, STAGE BELLAIRE PROPERTIES INC. PARCEL P1 - LEFROY TOWN OF INNISFIL

REVISIONS

SCALE:	1:250
DATE:	APR 2024
DRAWN:	T.P.
DESIGNED:	T.P.

AS-BUIL

DRAWING No: A-1