




LORMEL
KAZMIR
215 - 1B + DEN (701 SF)

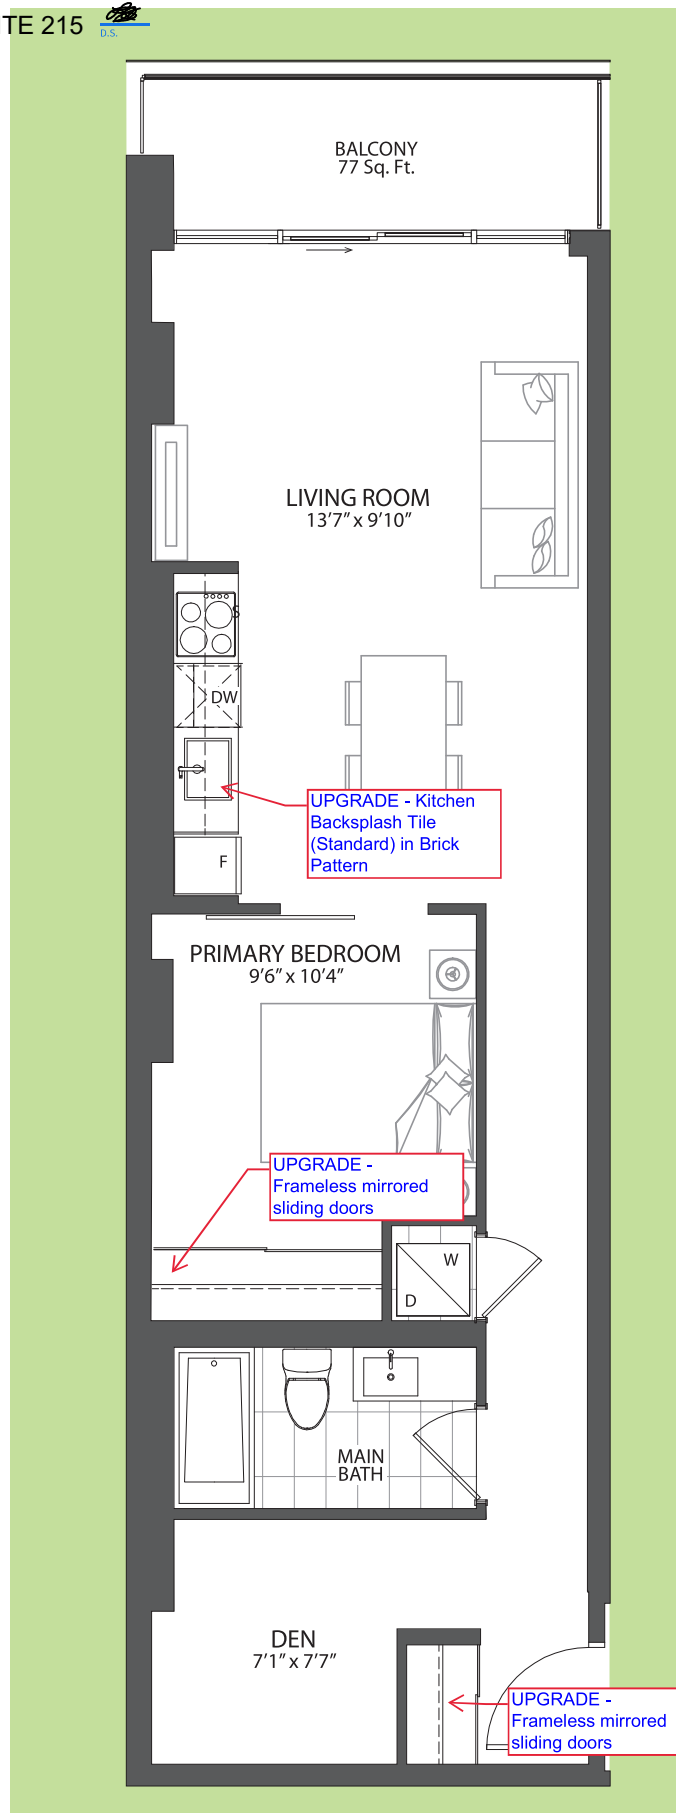