




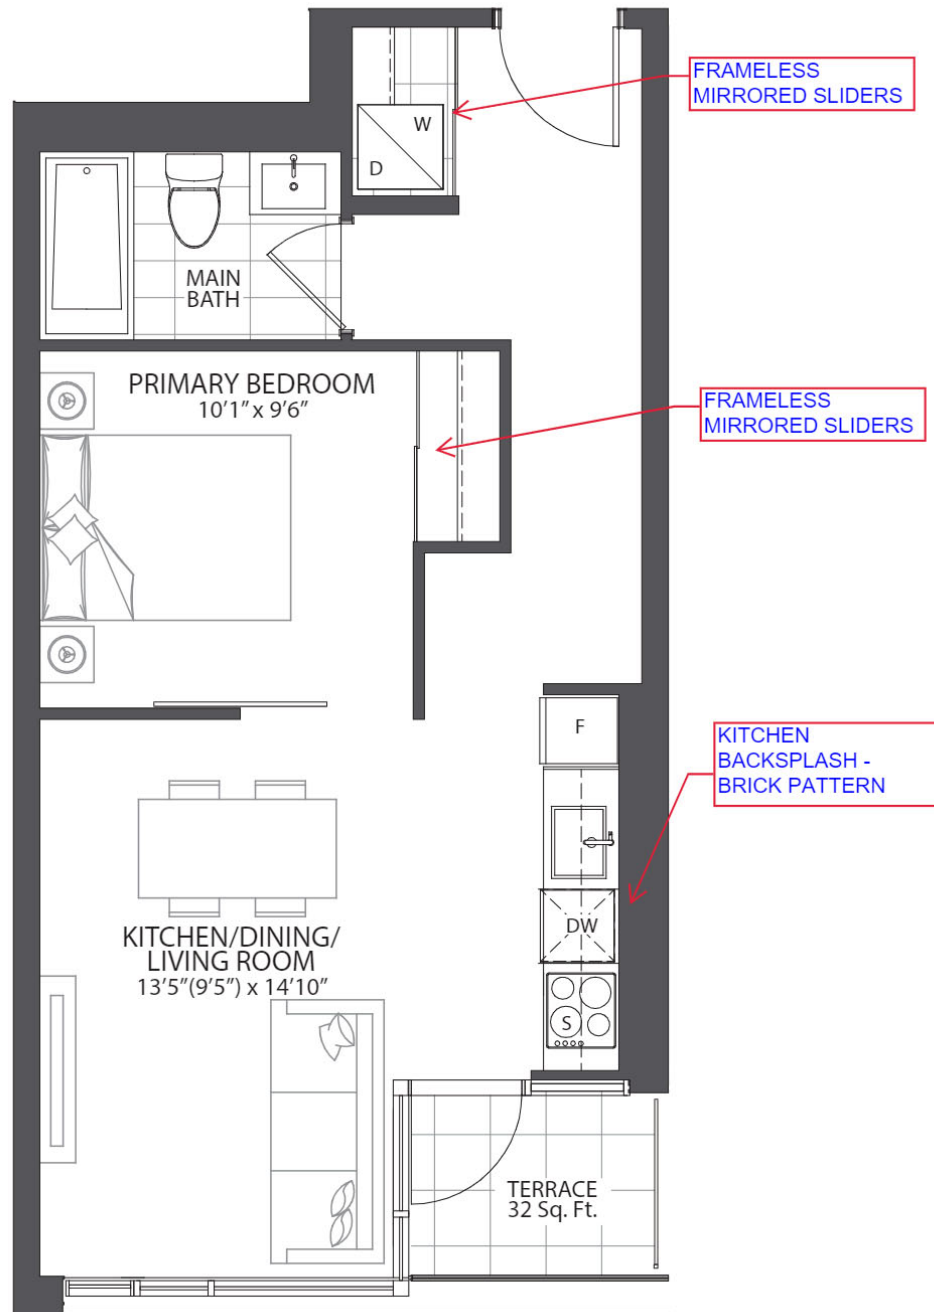


FLOOR 6

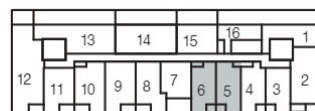


FLOOR 5

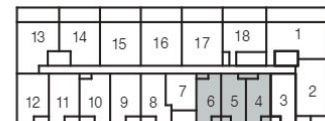

FLOOR 4

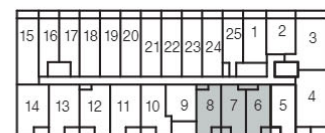

FLOOR 3

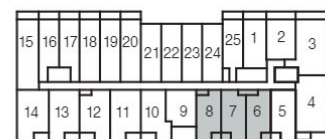

FLOOR 2

LORMEL

KAZMIR

206, 207, 208, 306, 307, 308, 404, 405, 406,
505, 506, 604, 605 -1B (528 SF)