




KITCHEN
BACKSPLASH -
BRICK PATTERN

FRAMELESS
MIRRORED SLIDERS

FRAMELESS
MIRRORED SLIDERS

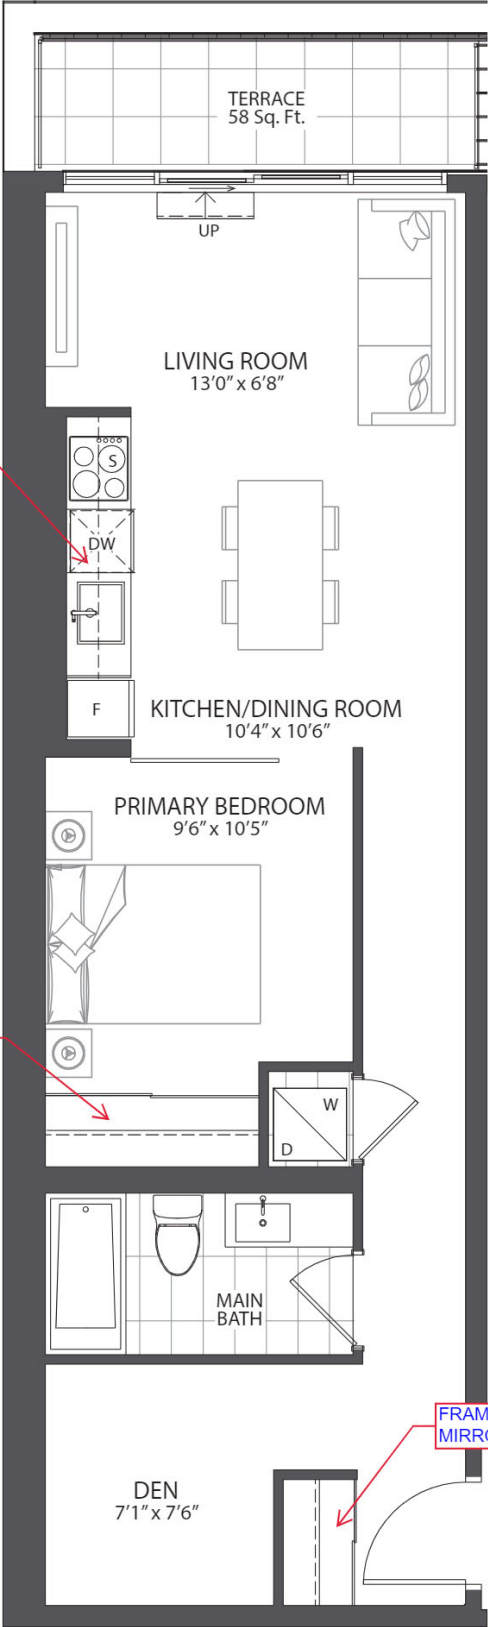

LORMEL
KAZMIR
315 - 1B + DEN (658 SF)

