


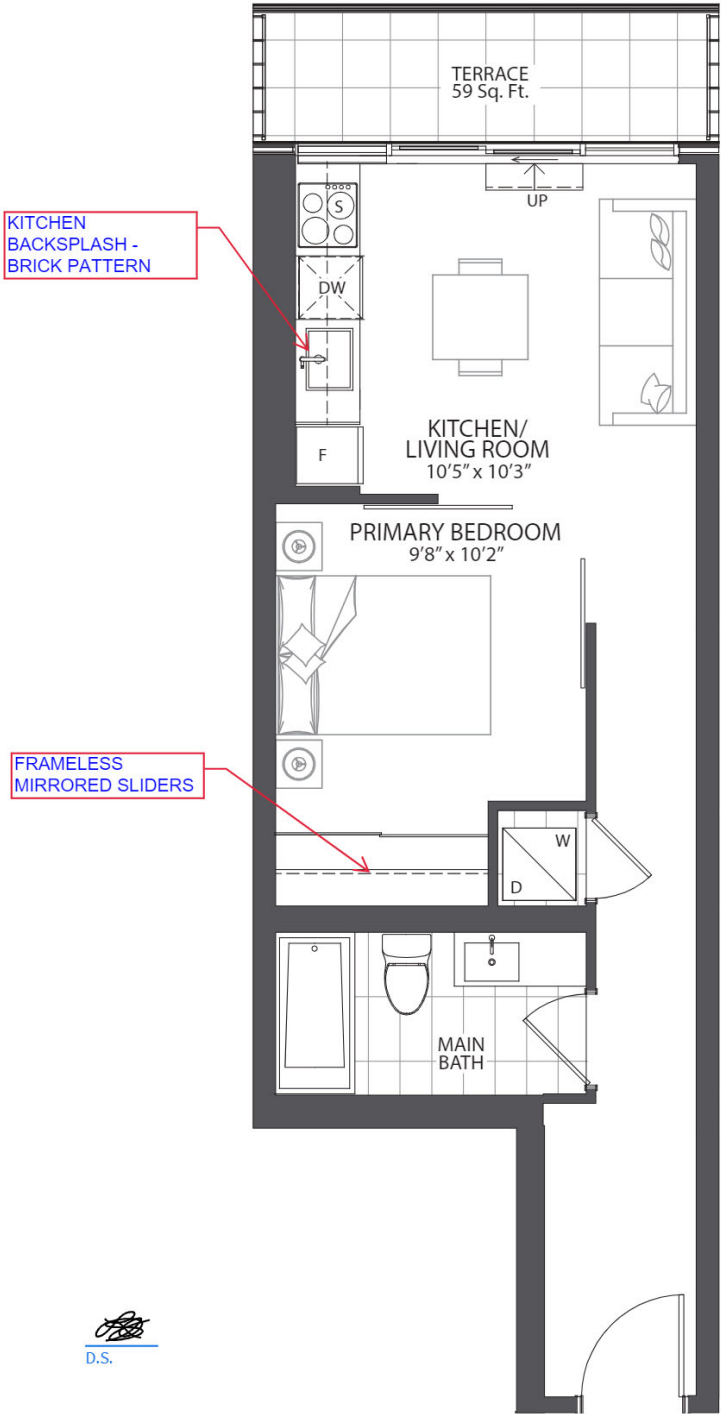


D.S.

LORMEL
KAZMIR
317 - 1B (473 SF)

