




LORMEL  
KAZMIR  
401 - 3B (1001 SF)

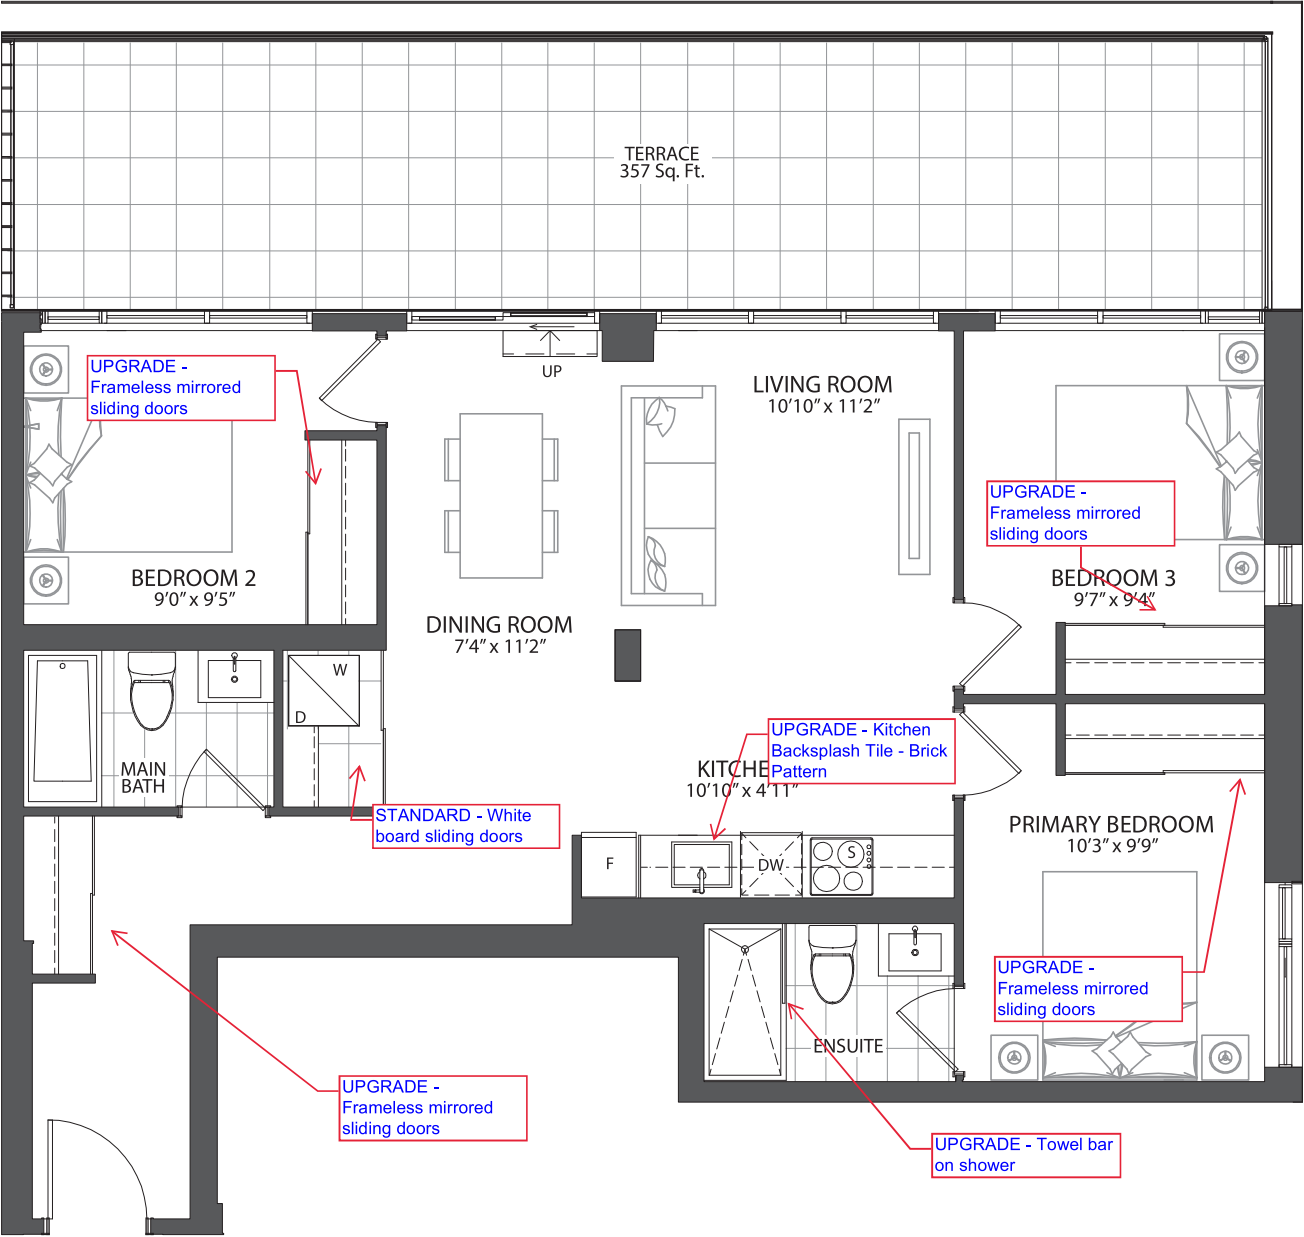