
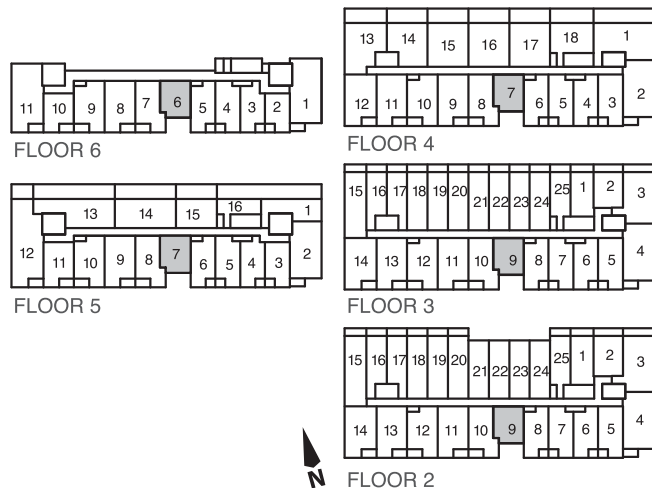


SUITE 407

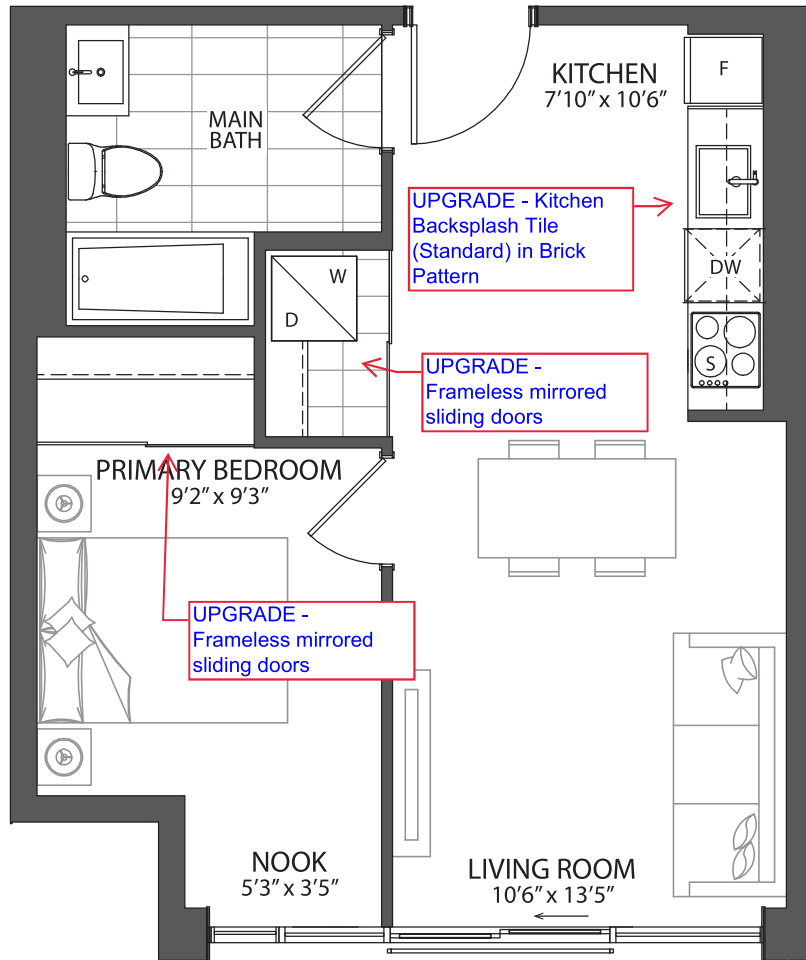

LORMEL
KAZMIR
209-309-407
507-606 - 1B (501 SF)