




LORMEL
KAZMIR
413 - 2B + DEN (859 SF)

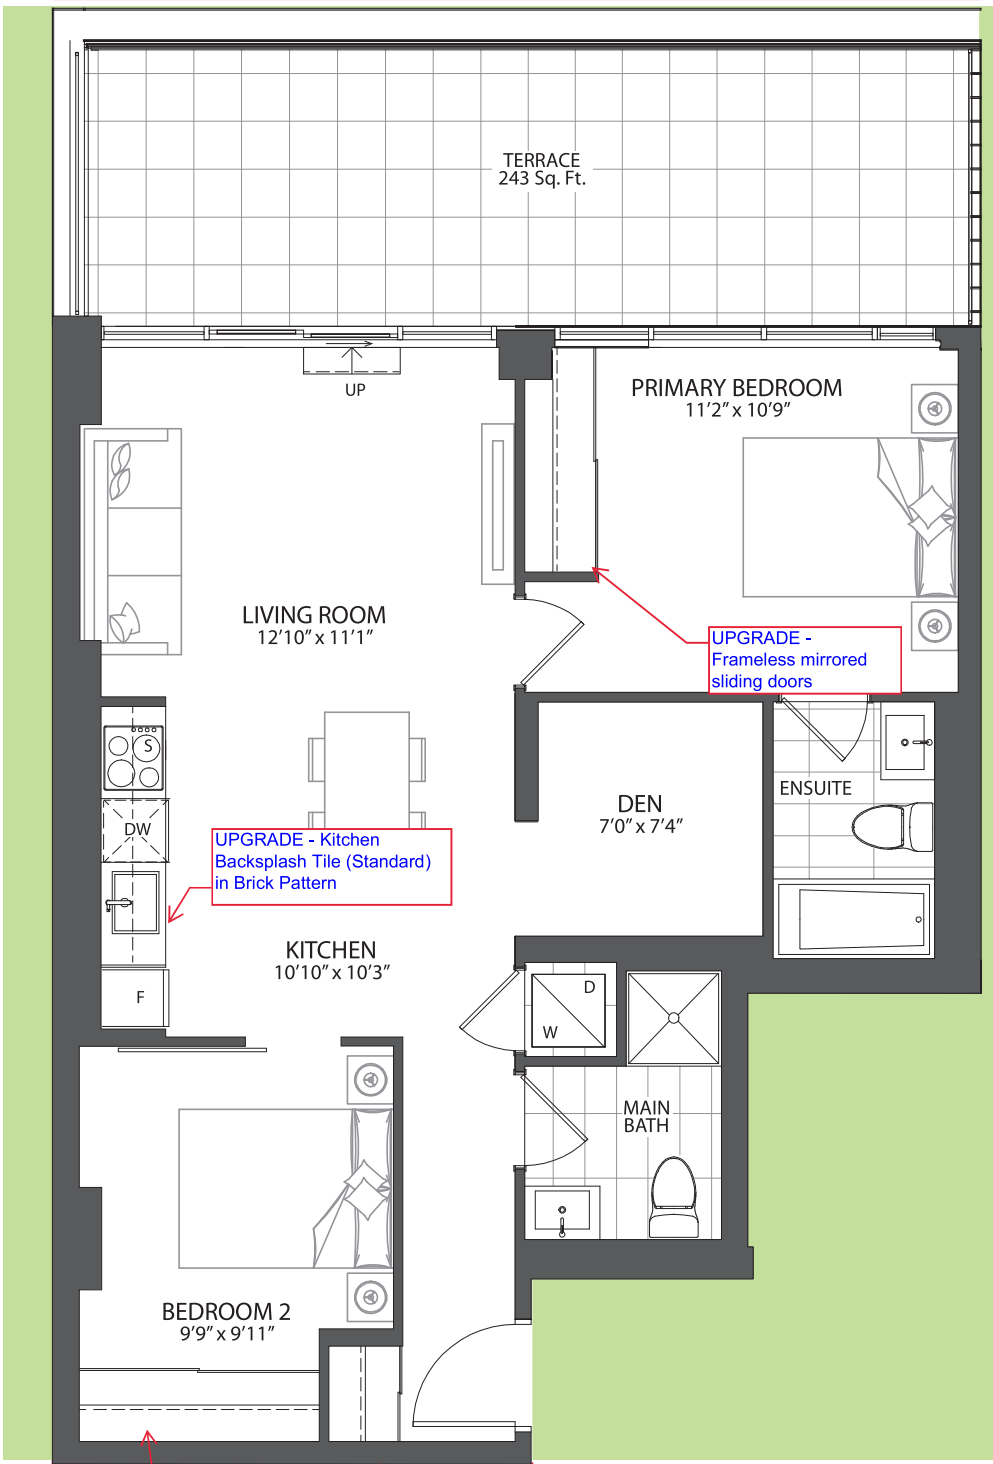