




LORMEL
KAZMIR
418 - 2B (687 SF)

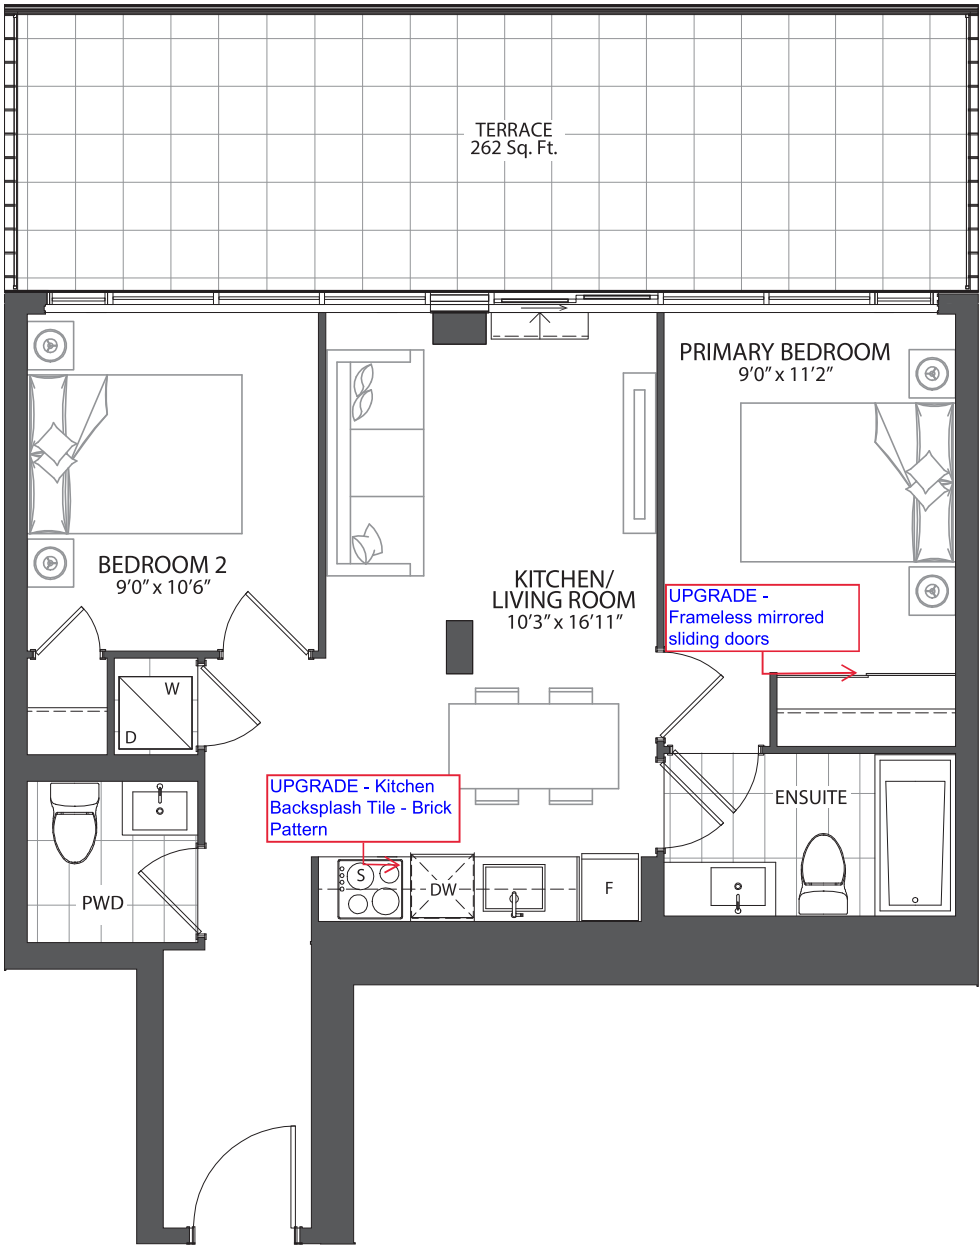