


# SUITE 703

05.10.24

KAZ-PH-3

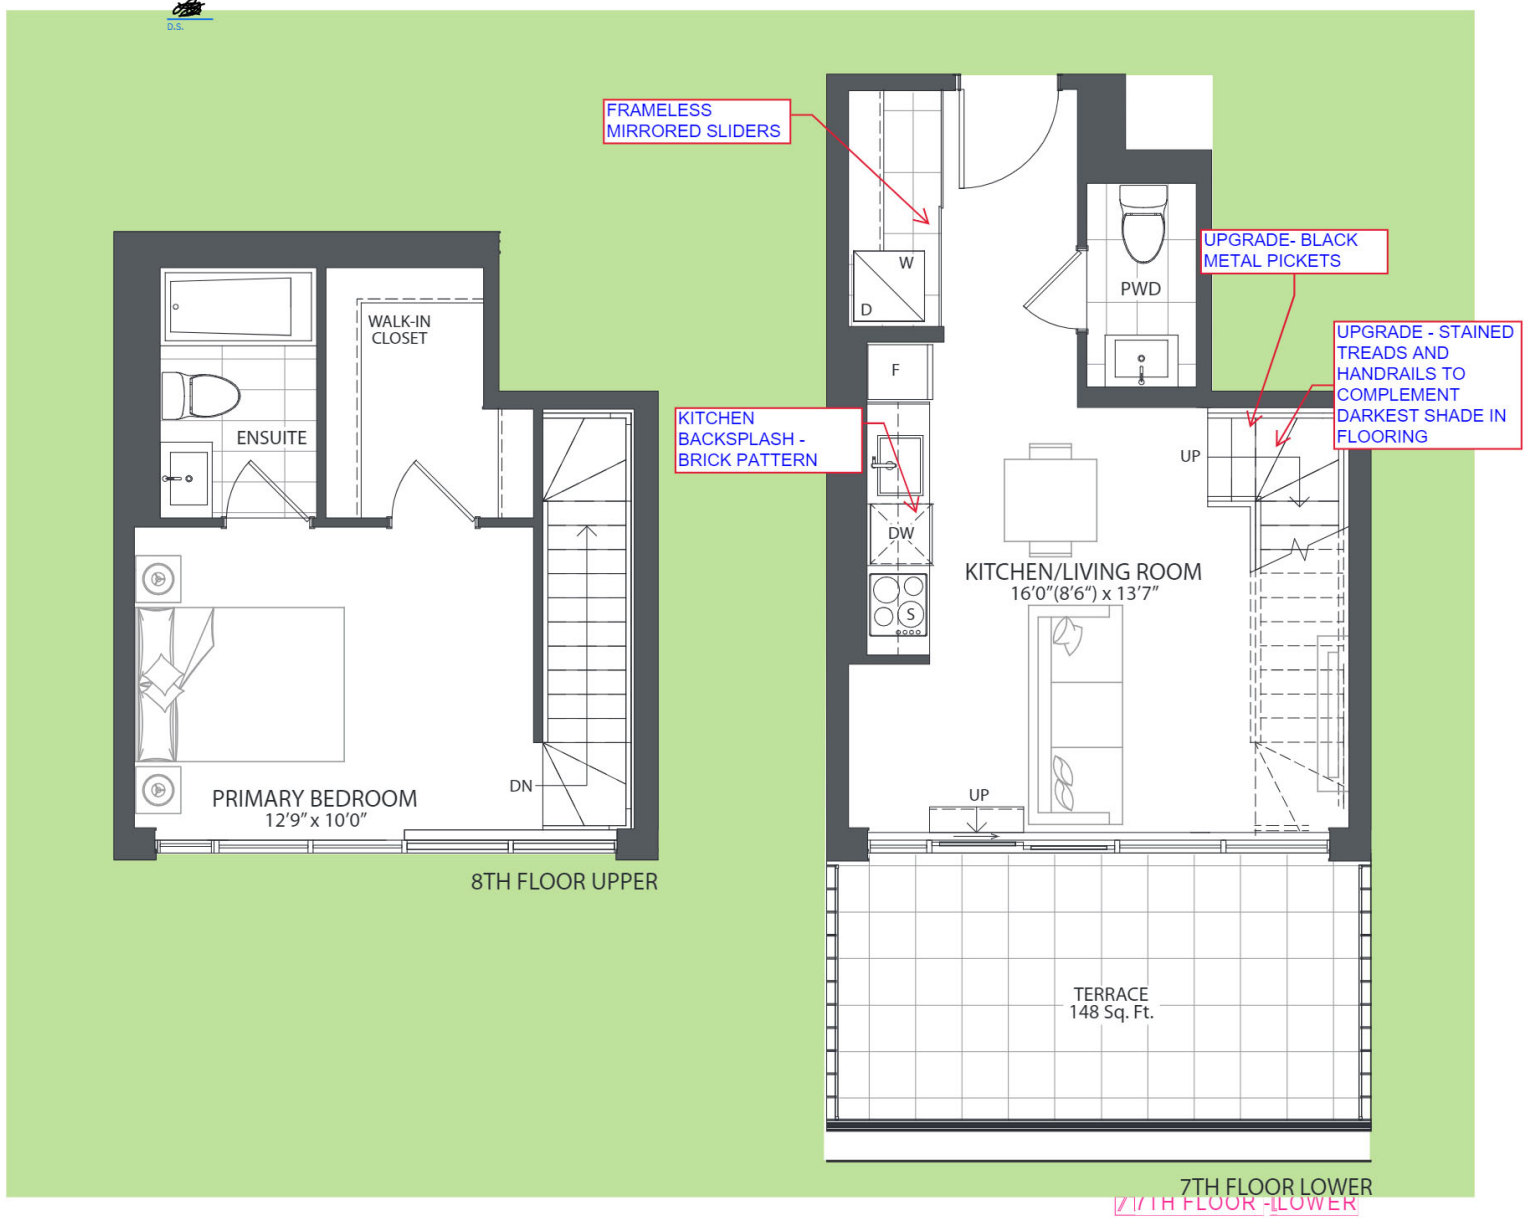

LORMEL  
KAZMIR  
703 - 1B (676 SF)

