

DCR PHOENIX HOMES

LINE: 1 AND 2

HARDWARE: STD & 1ST UPGRADE

STD WHITE INTERIORS

METAL DRWR BOX

4 PCS - 5/8" KICK

2 PCS LOOSE FILLER

2 PCS C MOULD


1 PC T MOULD

HAMILTON 43-7

KITCHEN & VANITIES


MOUNTING HT: 84

LOT 77 FC

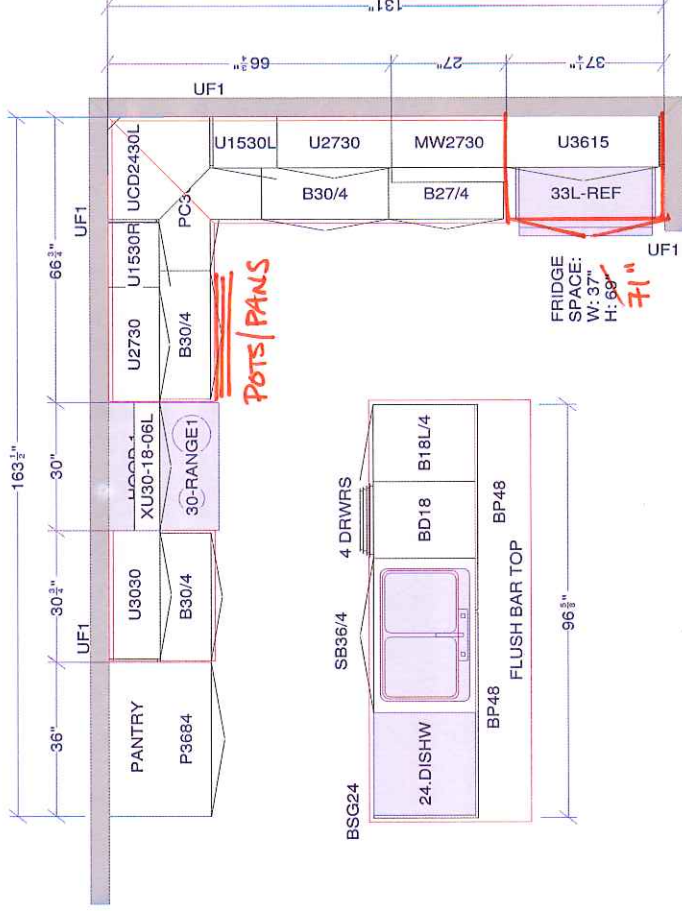


24" D FRIDGE
UPPER

POTS/PANS

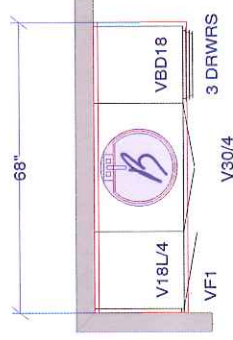

ENSUITE BATHROOM

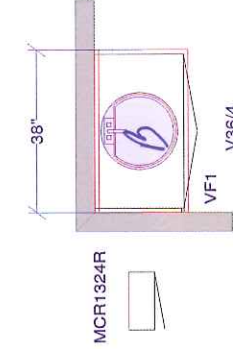

MAIN BATHROOM

All dimensions size designations given are subject to verification on job site and adjustment to fit job conditions.

Cartier Kitchens Ottawa

43-7 Hamilton.kit



This is an original design and must not be released or copied unless applicable fee has been paid or job order placed.

Drawn by: Lori Di Saverio, B.I.D.
Cartier Kitchens Ottawa

All

Drawing #: 1 No Scale

Nov. 17/15

Designed: 24/08/2011

Printed: 24/08/2014

