

DCR PHOENIX HOMES

FERNBANK CROSSING

LOT #103

YARMOUTH (511)

KITCHEN

MOUNTING HT: 84

LINE -

HARDWARE -

STD WHITE INTERIORS

METAL DRWR BOX

3 PCS - 5/8" KICK

2 PCS - LOOSE FILLER - 6 x 96

2 PCS - CORNER MOUL

1 PC - T MOULD

CUSTOMER APPROVAL

I have reviewed these drawings and understand the details of the layout and the Cartier Kitchens specifications.


Signature

Date

Aug. 20/14

SPACE FOR STOVE
RELOCATED TO
OUTSIDE WALL

SPACE
FOR
MICROWAVE
W: 25.5"
H: 13.5"
D: 16.5"

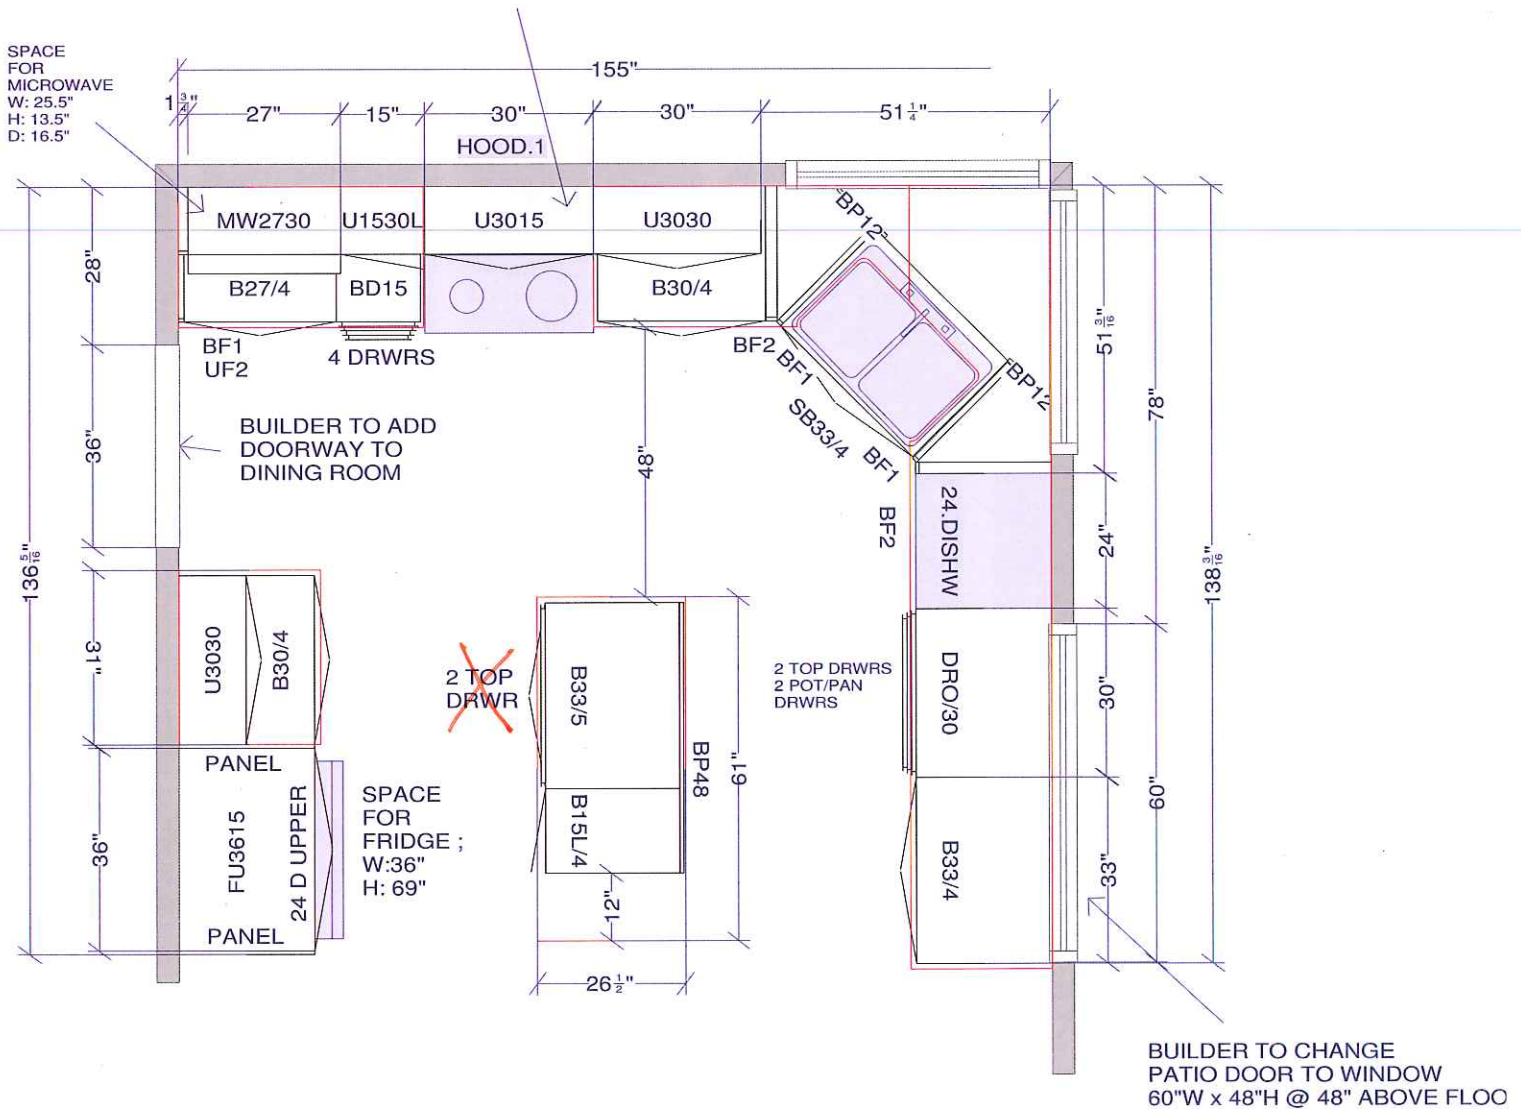


All dimensions size designations given are subject to verification on job site and adjustment to fit job conditions.



This is an original design and must not be released or copied unless applicable fee has been paid or job order placed.

Designed: 2014-06-
Printed: 2014-06-24

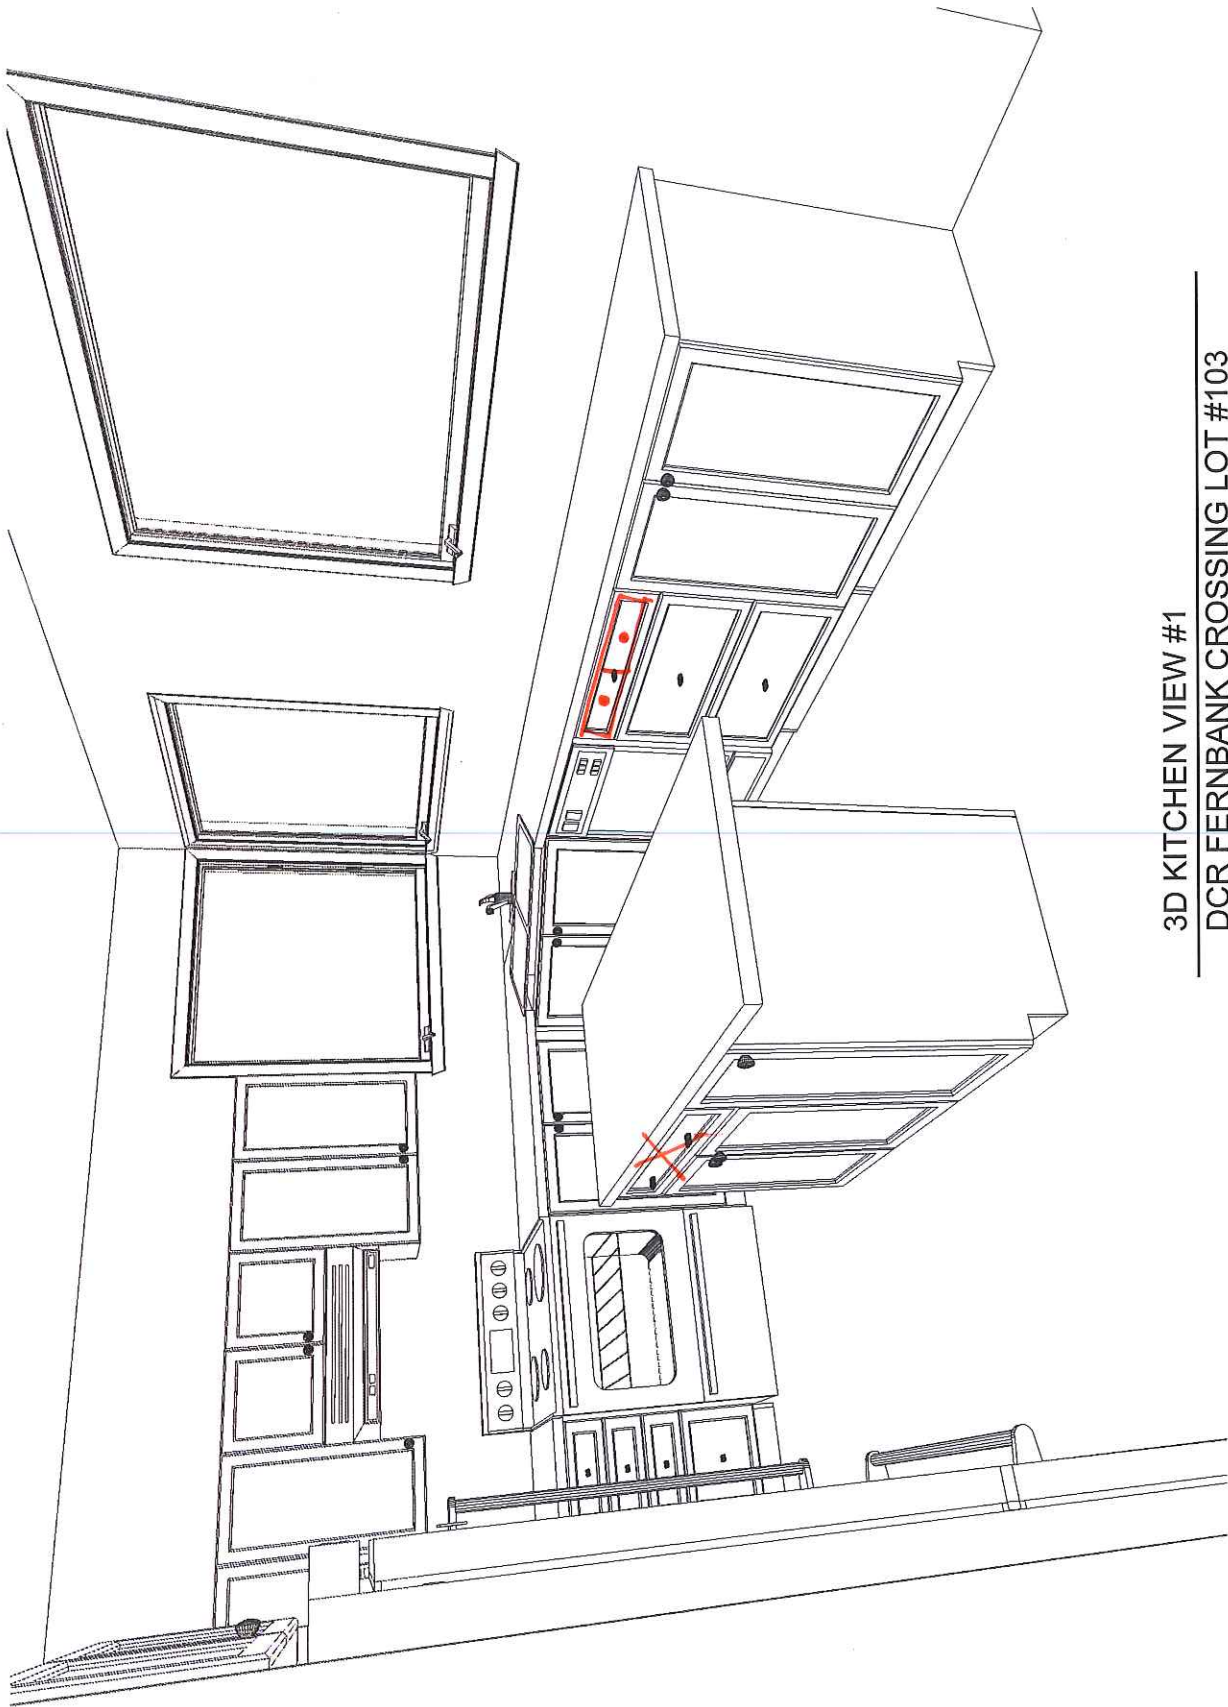

3D KITCHEN VIEW #1
DCR FERNBANK CROSSING LOT #103

CUSTOMER APPROVAL

I have reviewed these drawings and understand the details of the layout and the Cartier Kitchens specifications.

Signature

KHu


Date

Aug. 20/14

Note: This drawing is an artistic interpretation of the general appearance of the design. It is not meant to be an exact rendition.



Designed: 2014-06-23
Printed: 2014-06-23

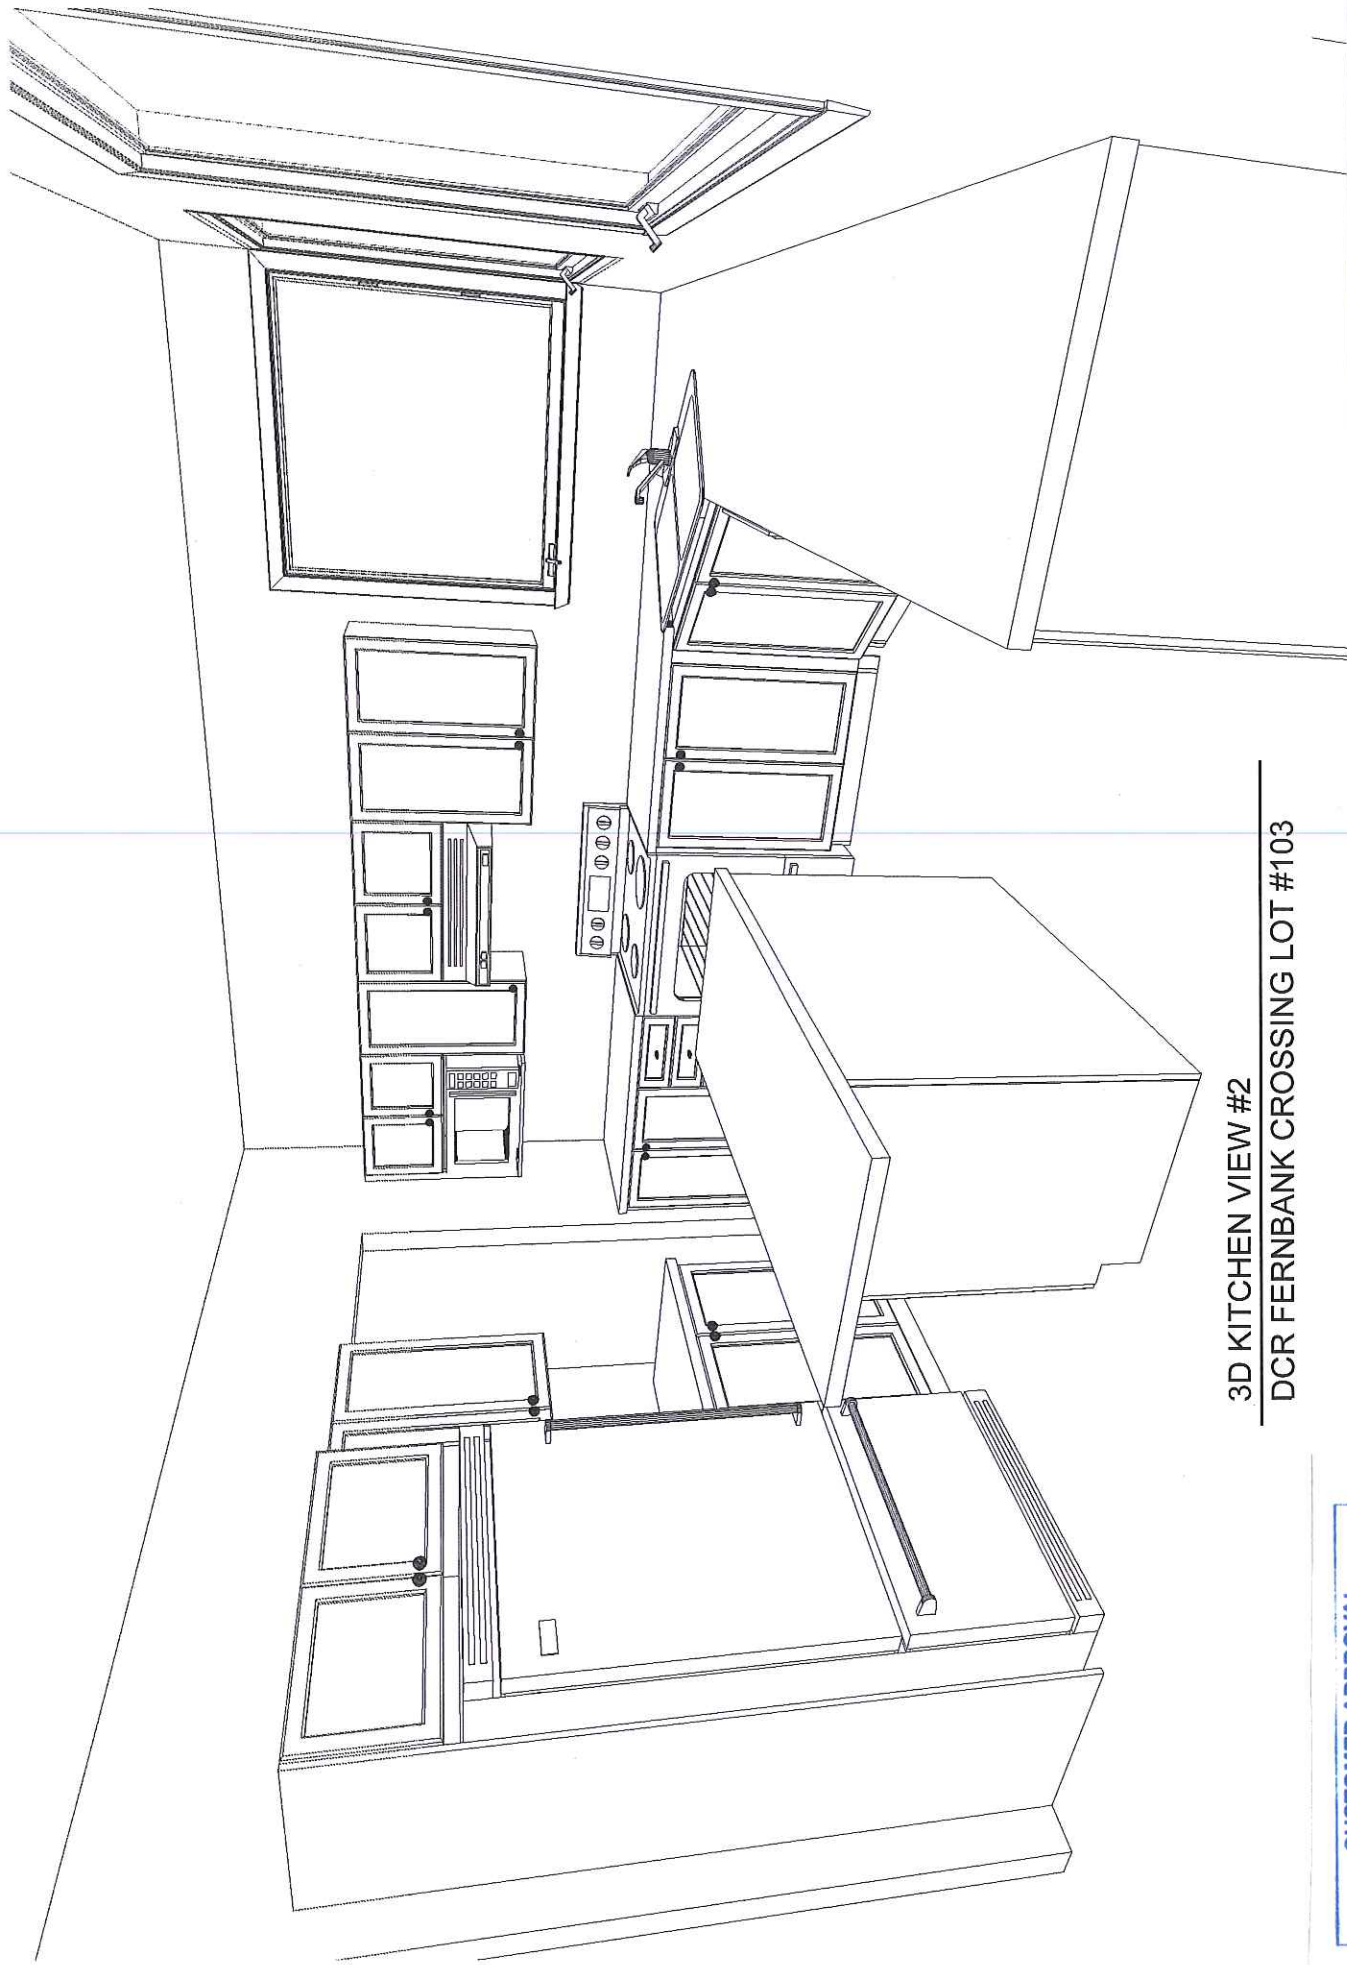

3D KITCHEN VIEW #2
DCR FERNBANK CROSSING LOT #103

CUSTOMER APPROVAL

I have reviewed these drawings and understand the details of the layout and the Cartier Kitchens specifications.

Signature


Date

KTH 
Aug. 20/14

Note: This drawing is an artistic interpretation of the general appearance of the design. It is not meant to be an exact rendition.



Designed: 2014-06-23
Printed: 2014-06-23

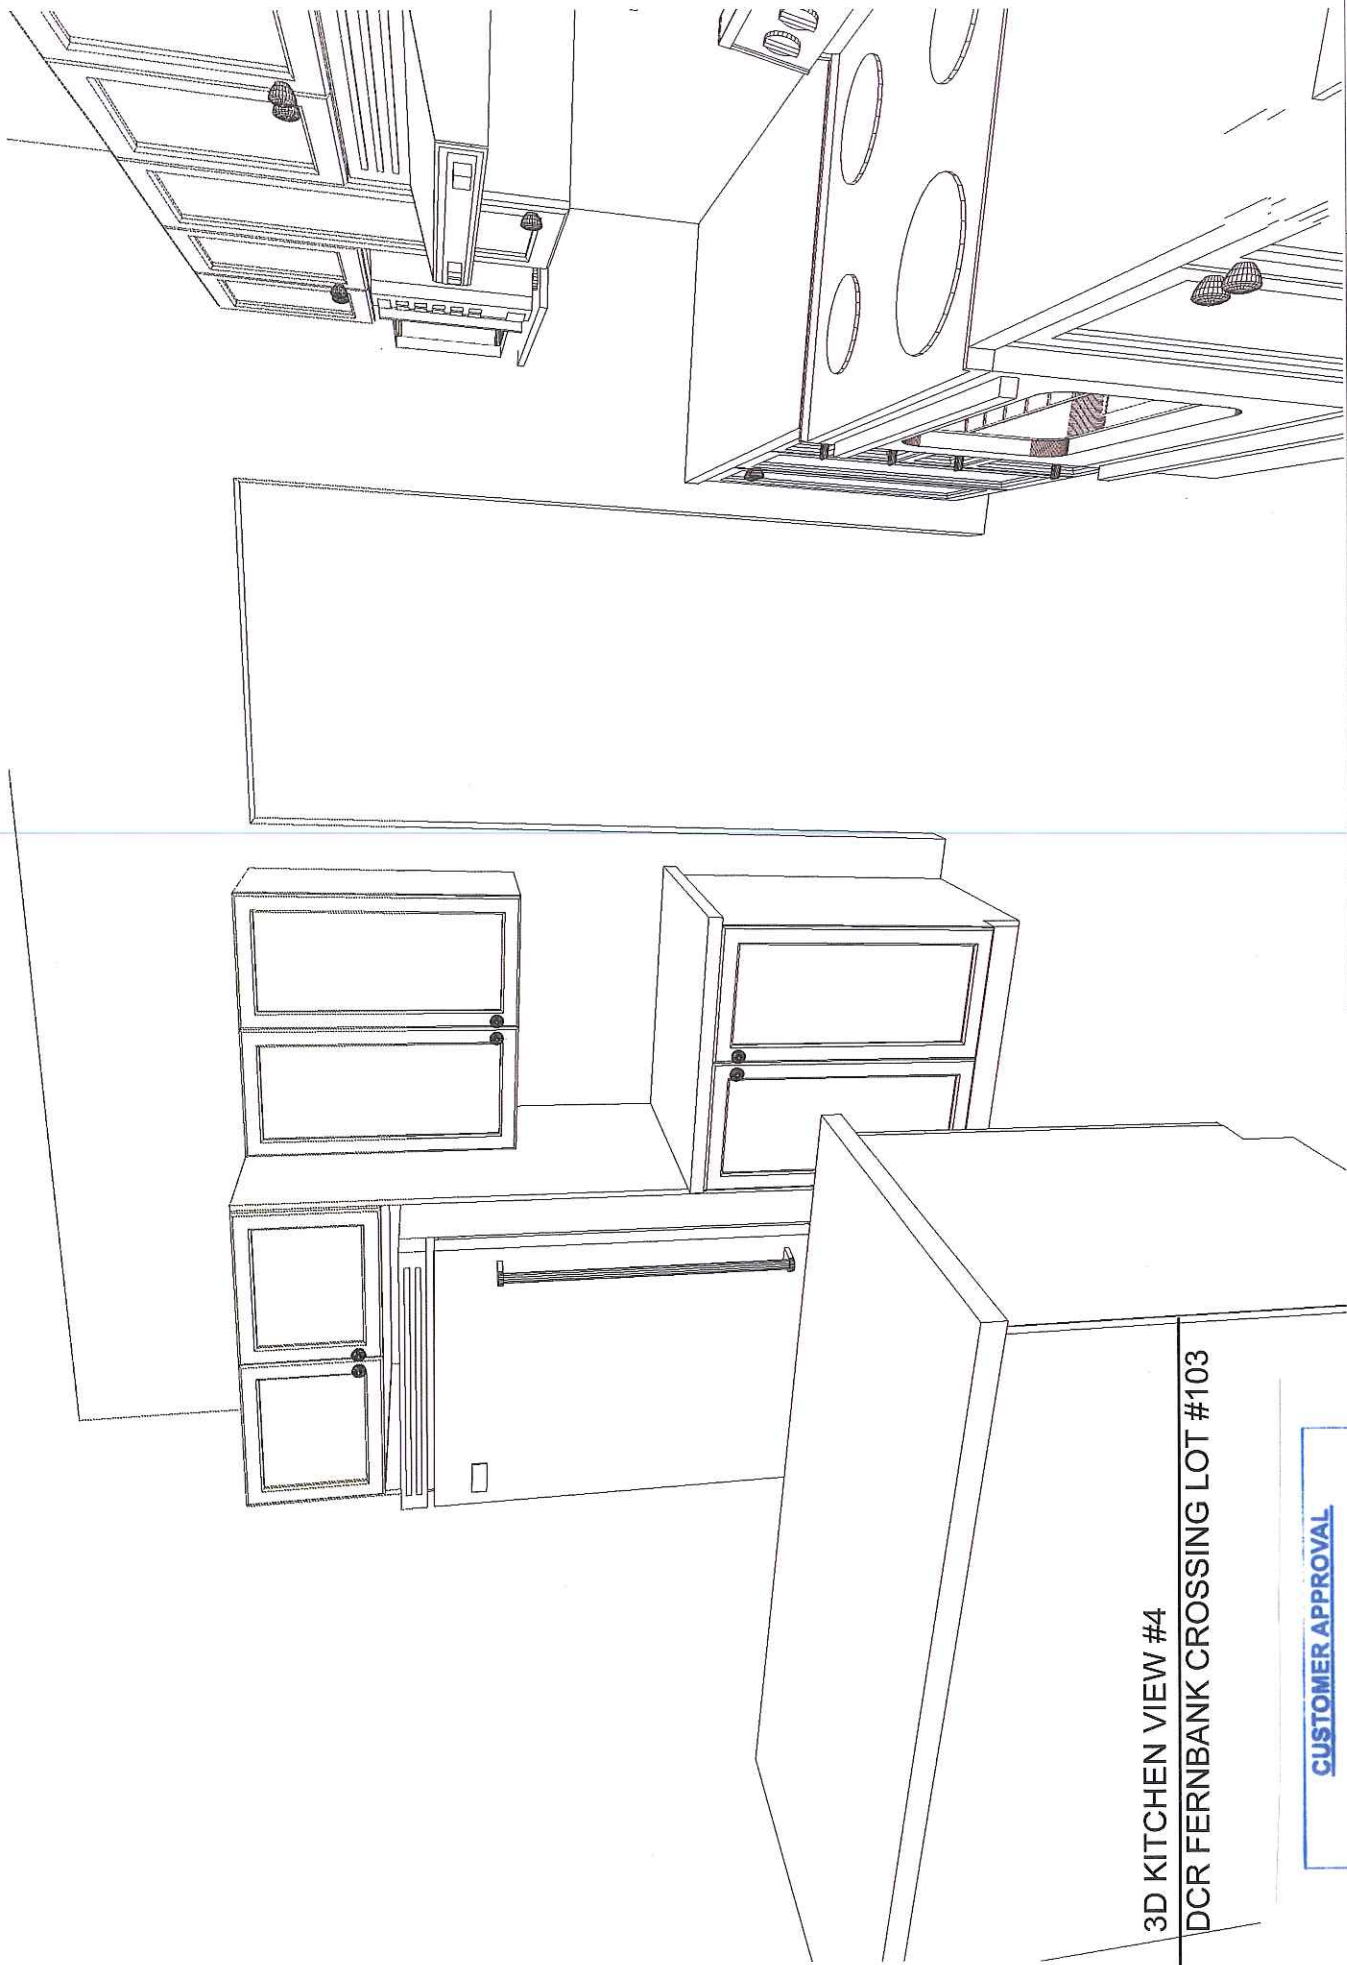

3D KITCHEN VIEW #4
DCR FERNBANK CROSSING LOT #103

Designed: 2014-06-23
Printed: 2014-06-23



Note: This drawing is an artistic interpretation of the general appearance of the design. It is not meant to be an exact rendition.


CUSTOMER APPROVAL

I have reviewed these drawings and understand the details of the layout and the Cartier Kitchens specifications.

K Hu

Signature

Date Aug. 20/14

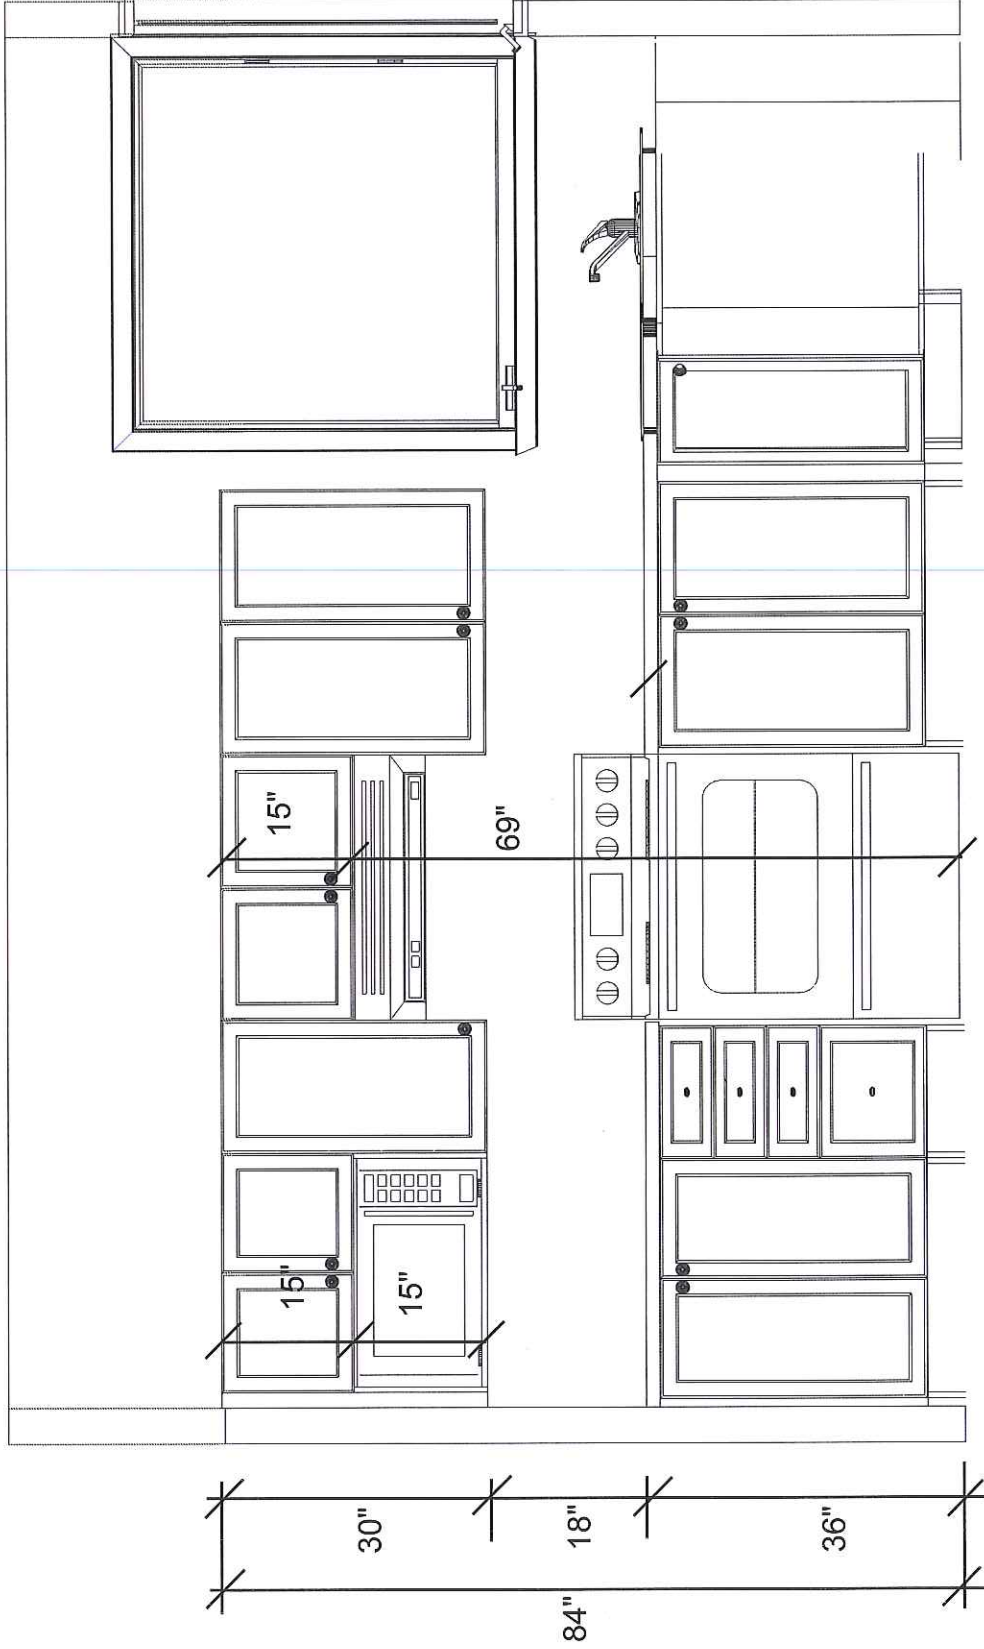

STOVE WALL ELEVATION
LOT 103 FERNBANK CROSSING

CUSTOMER APPROVAL

I have reviewed these drawings and understand the details of the layout and the Carrier Kitchens specifications.


Signature KRM 

Date Aug. 20/14

Note: This drawing is an artistic interpretation of the general appearance of the design. It is not meant to be an exact rendition.



Designed: 2014-06-23
 Printed: 2014-06-23

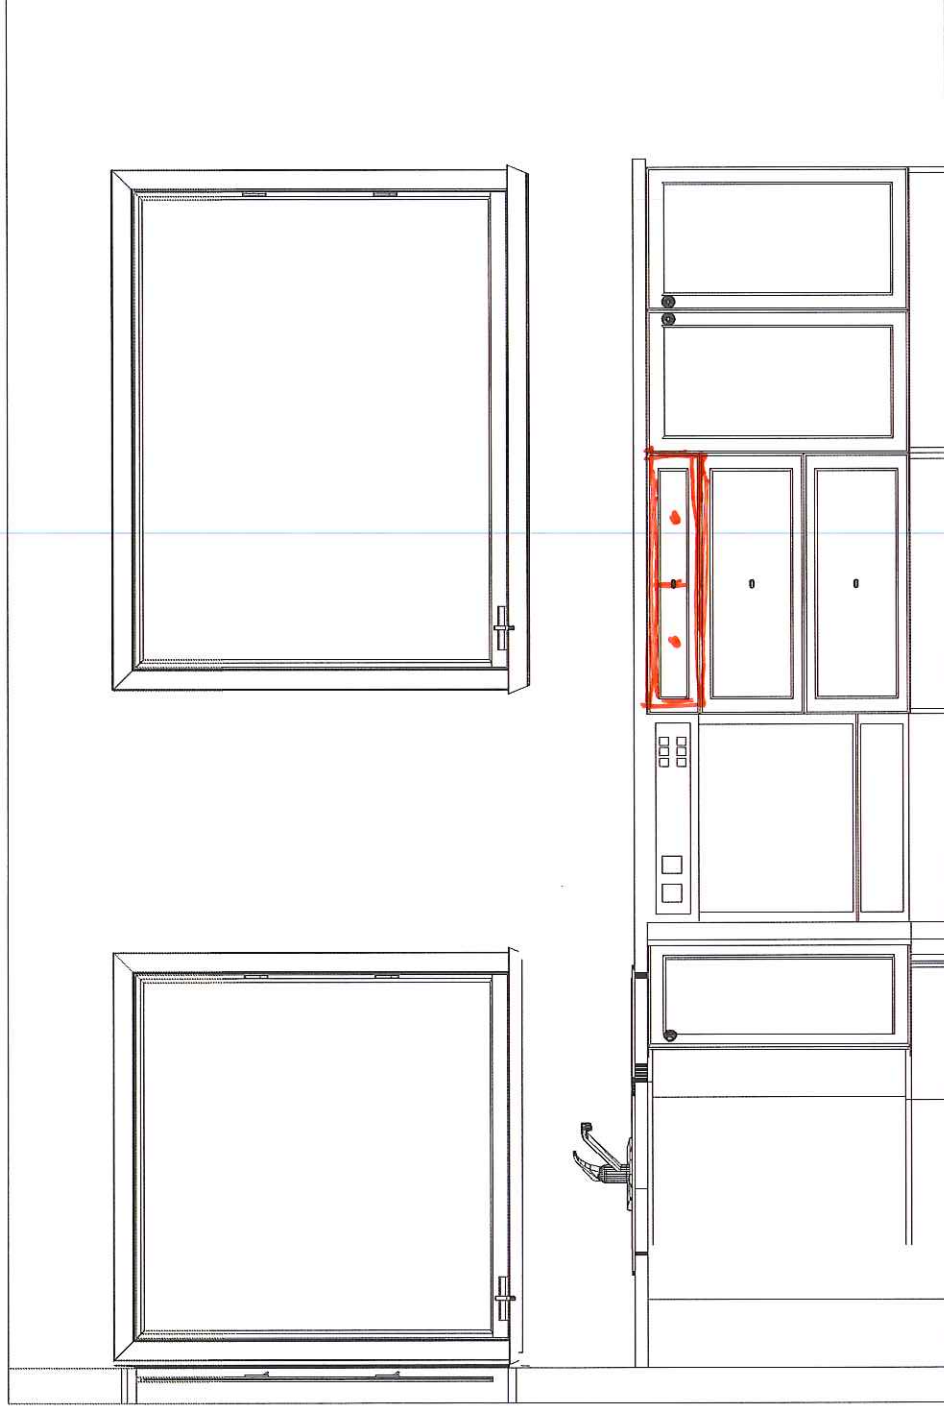

DISHWASHER WALL ELEVATION
DCR FERNBANK CROSSING LOT #103

CUSTOMER APPROVAL

I have reviewed these drawings and understand the details of the layout and the Carrier Kitchens specifications.

Signature

KTH


Date

Aug. 20/17

Note: This drawing is an artistic interpretation of the general appearance of the design. It is not meant to be an exact rendition.



Designed: 2014-06-23
 Printed: 2014-06-23

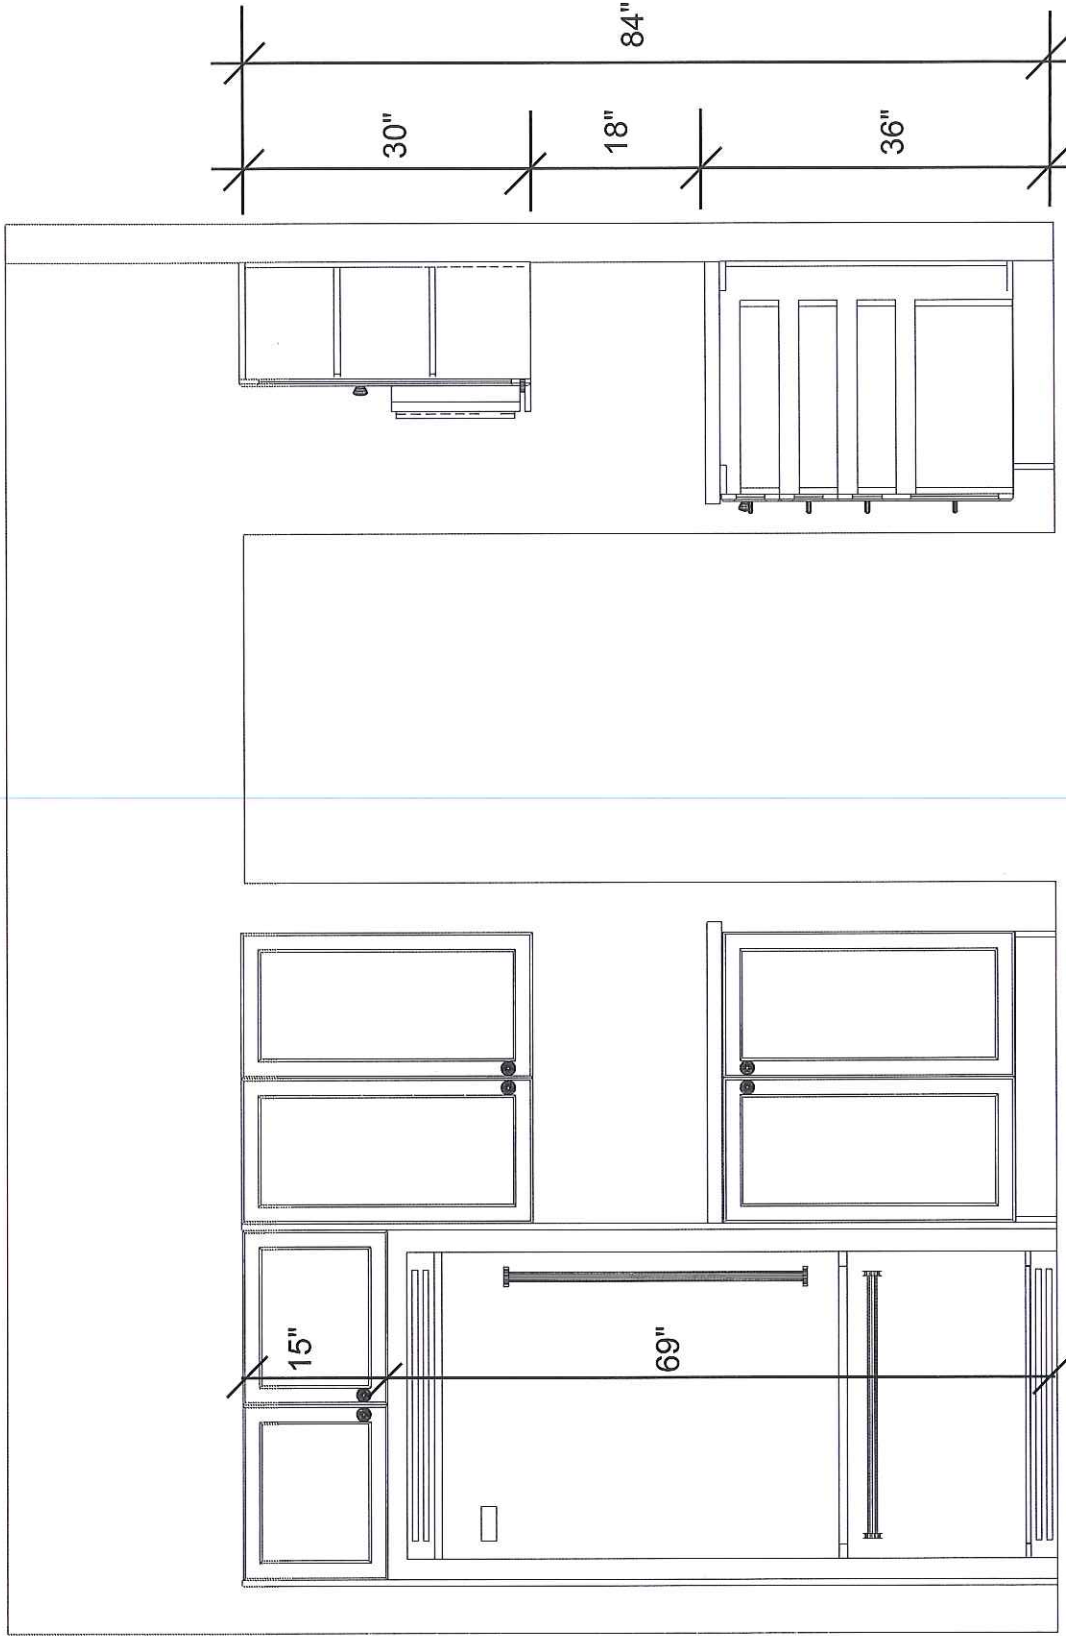

FRIDGE WALL ELEVATION
DCR FERNBANK CROSSING LOT #103

CUSTOMER APPROVAL

I have reviewed these drawings and understand the details of the layout and the Carrier Kitchens specifications.

KAR

Signature

Date

Aug. 20/14

Note: This drawing is an artistic interpretation of the general appearance of the design. It is not meant to be an exact rendition.



Designed: 2014-06-23
Printed: 2014-06-23