


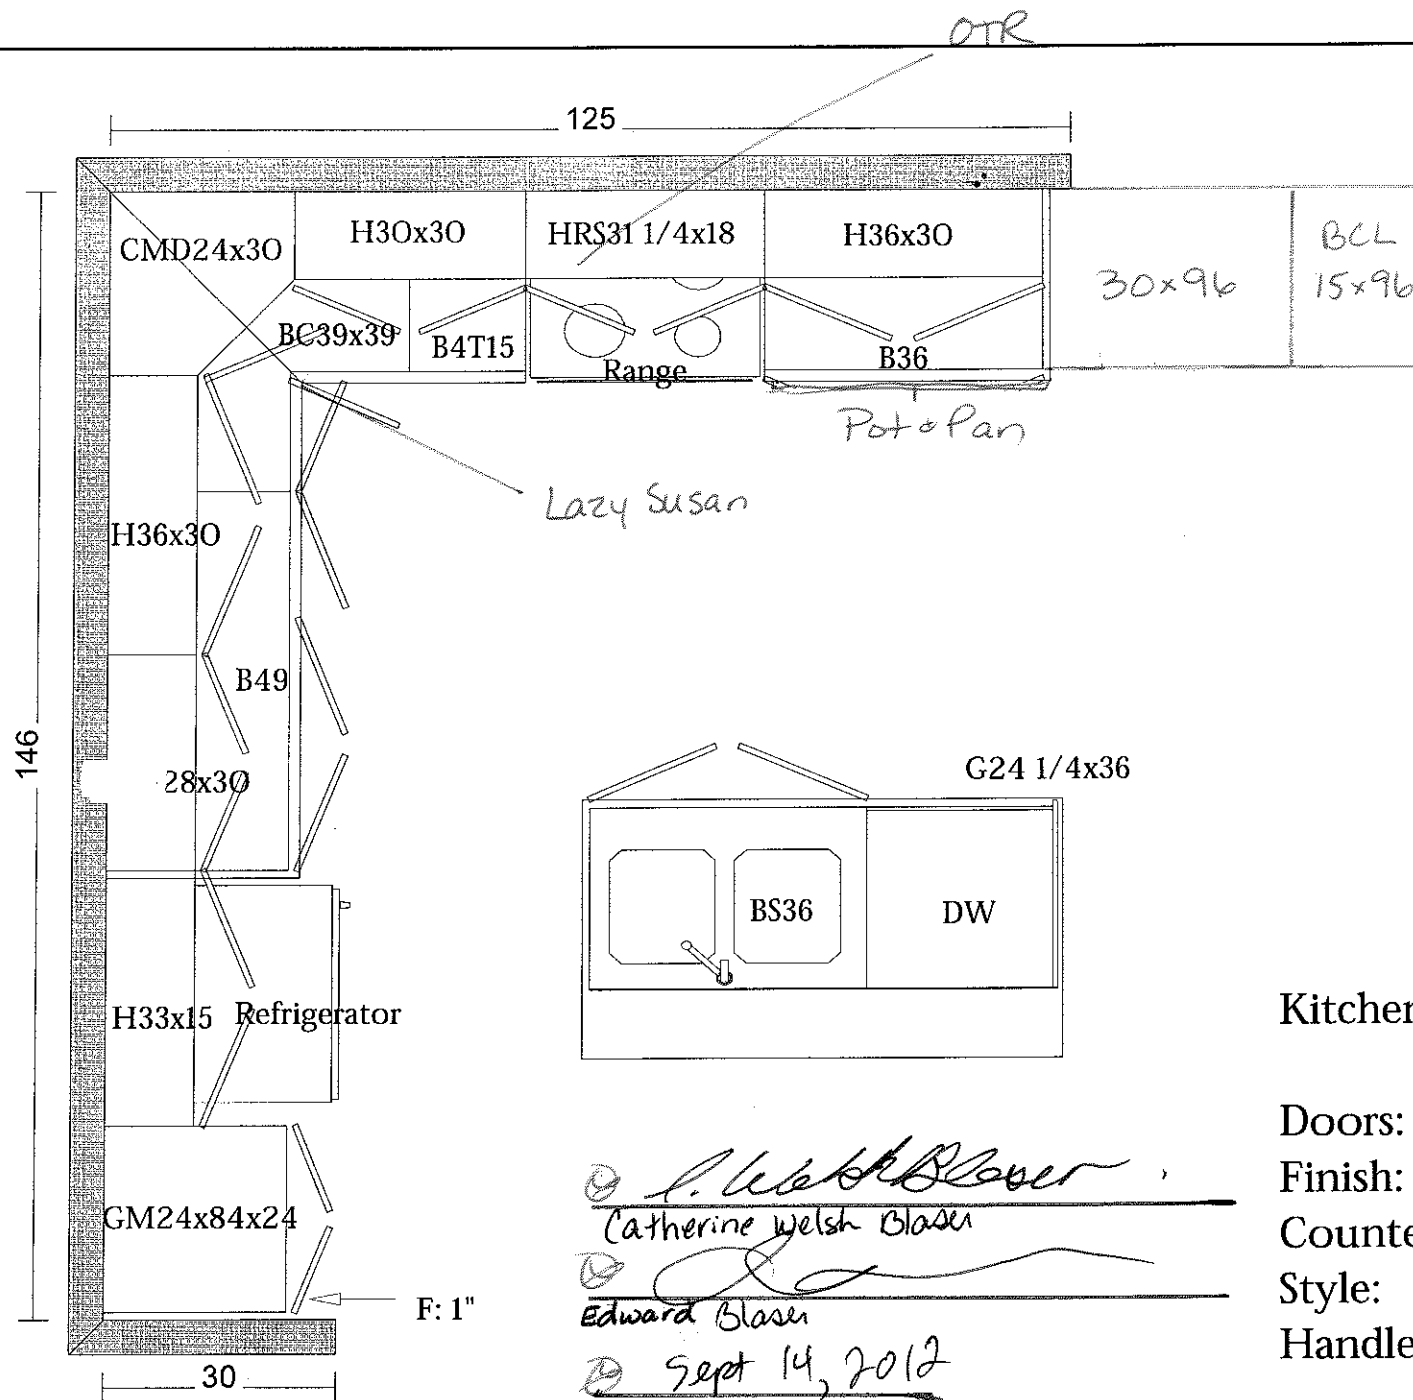

- 42" h uppers
- Small crown moulding
- OTR micro/hood fan

Kitchen:

Doors:

Finish:

Counter:

Style:

Handles:

Catherine Welsh Blasen
Edward Blasen
 Sept 14, 2012
 DATE

MR kitchens

296 Entreprise, Vars, ON
 K0A 3H0
 T:613.443.3399
 F:613.443.3406

Contractor:

Phoenix Homes

Designer:

Job Number:

Date:

07/19/12

Notes:

Gosford 35-6

Heritage Hills

Lot # 53

Welsh/Blasen

Scale:

1/2" = 1'

Page:

1 of 7