


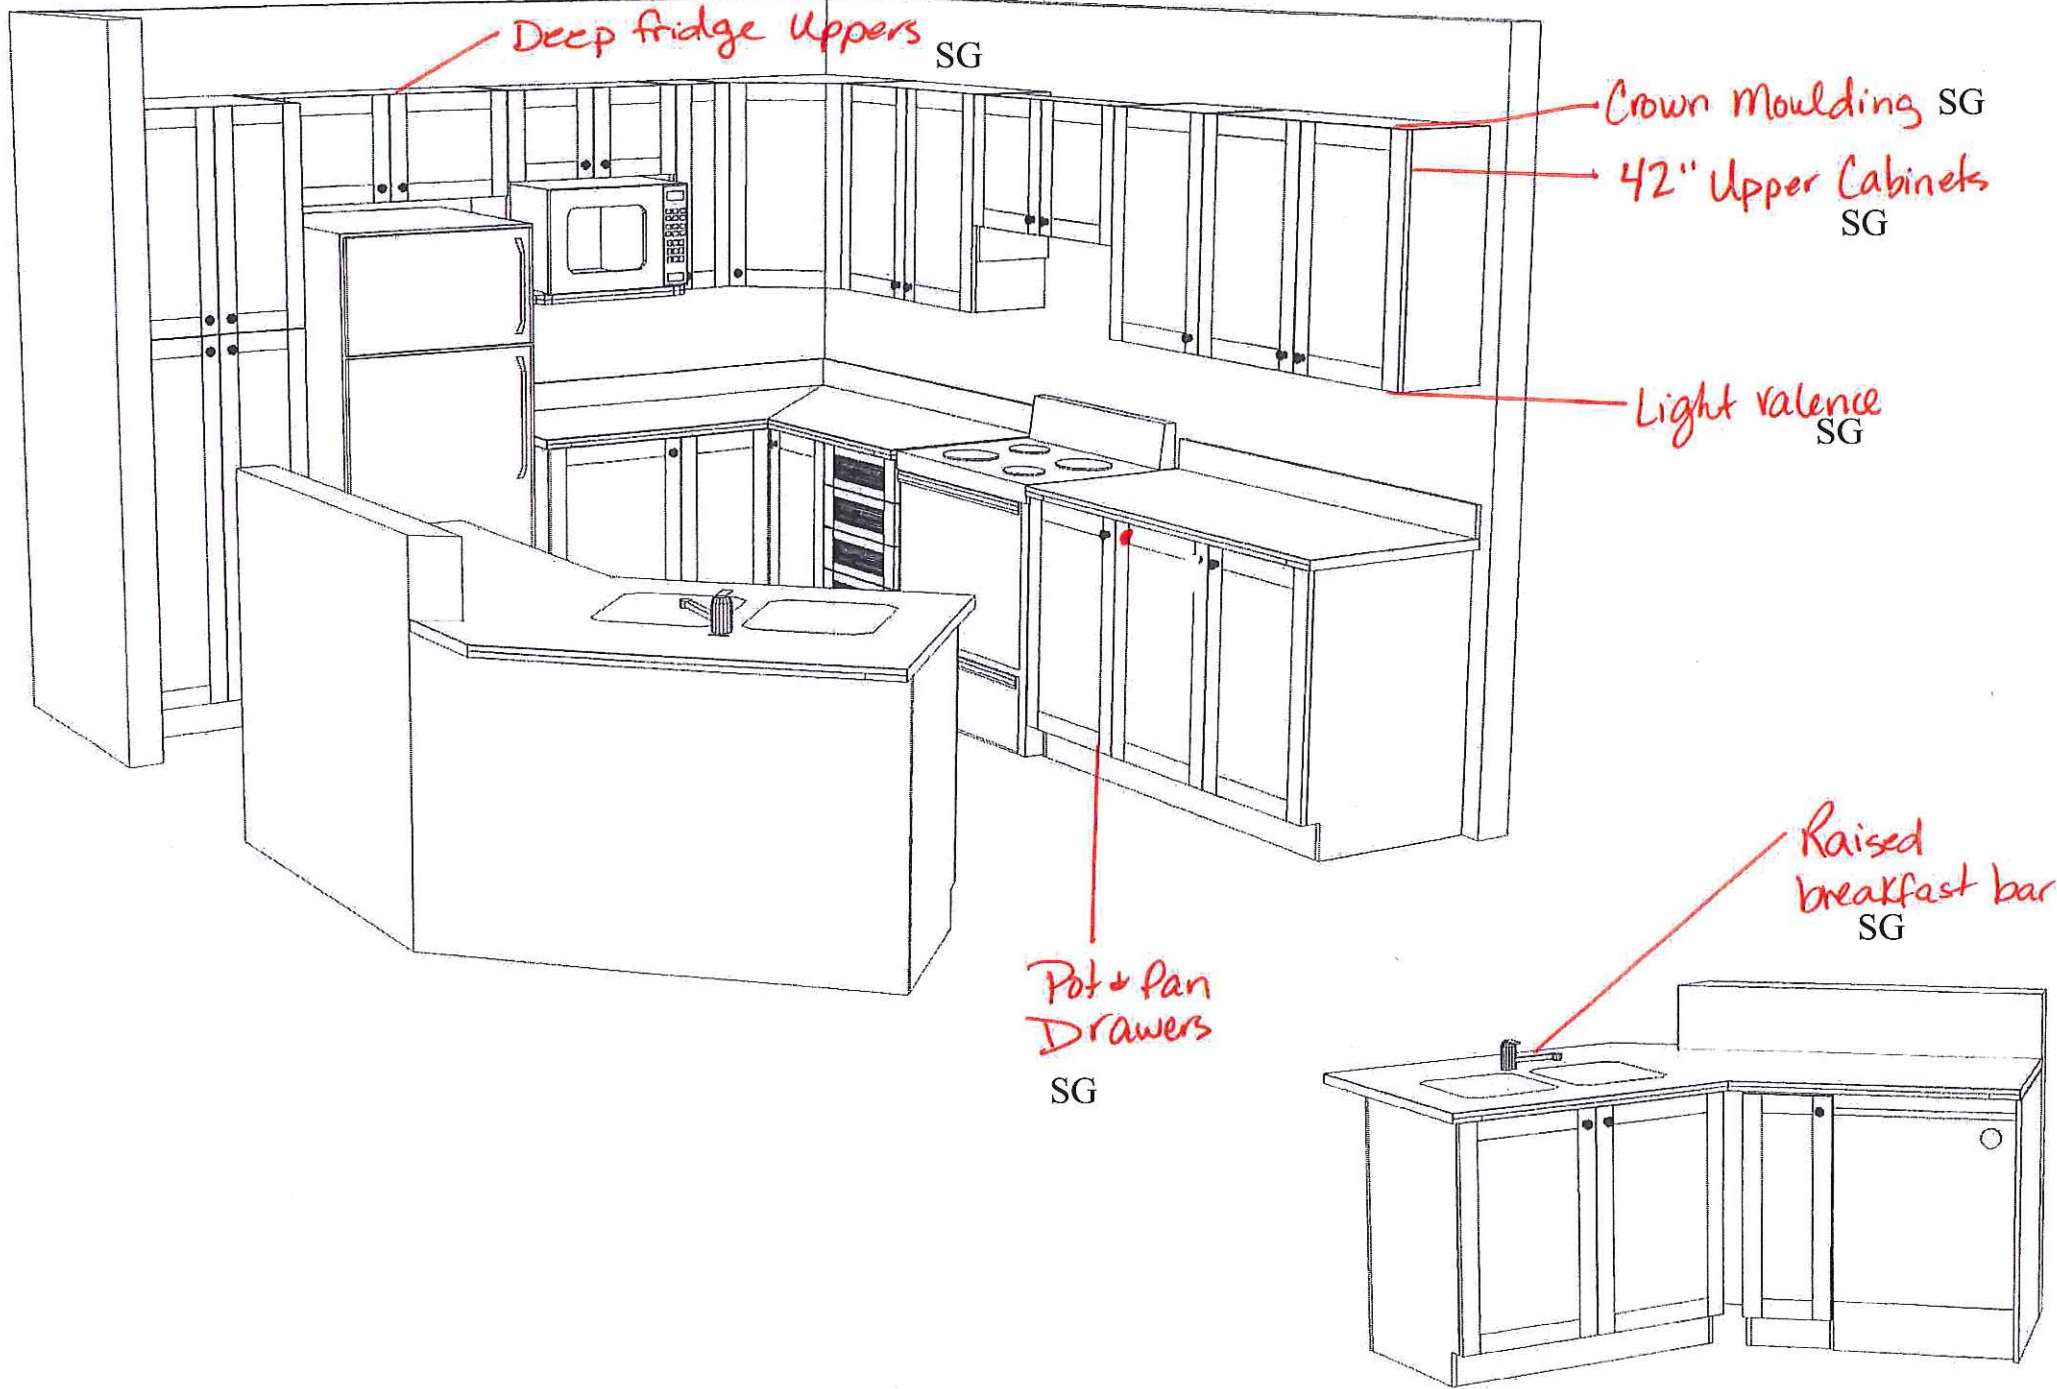

MR kitchens

Contractor:

Phoenix Homes

Designer:

G.B.

Job Number:

Date:

06/25/10

Notes:

Forbes 35-3

Heritage Hills


Lot 6
Sergey Gurnin

Scale:


1" = 1'

Page:

2 of 6

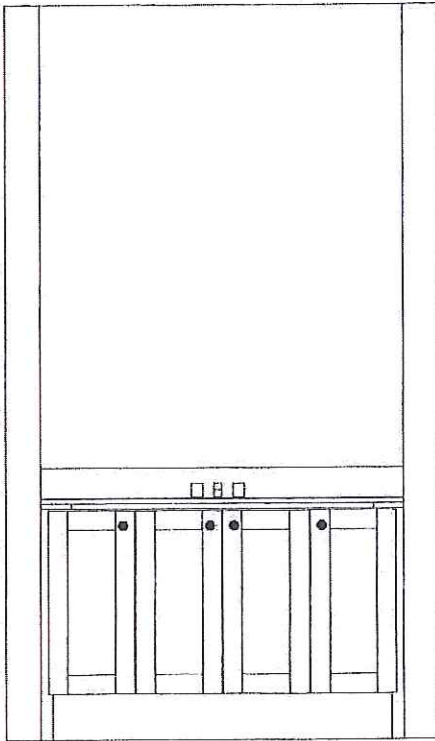

Main Bathroom

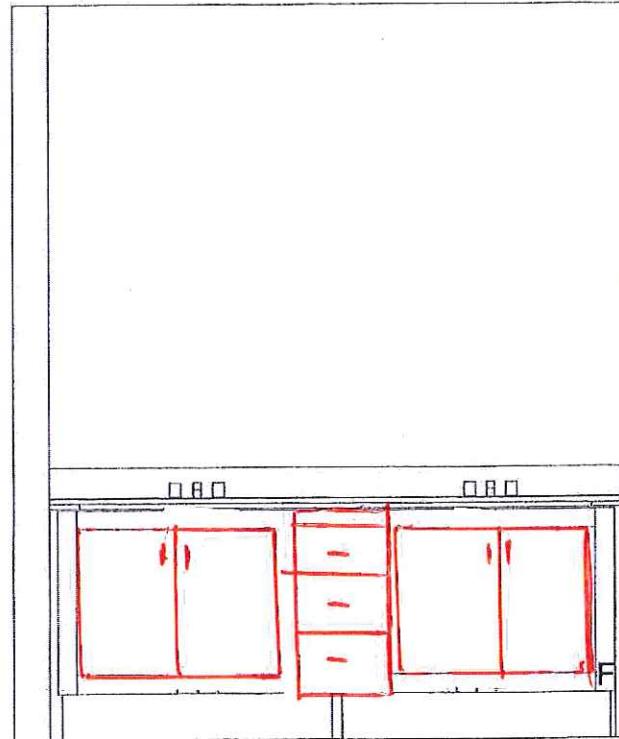

Ensuite

SG

MR kitchens

Contractor:

Phoenix Homes

Designer:

G.B.

Job Number:

Date:

06/25/10

Notes:

Forbes 35-3

Heritage Hills

Lot 6

Sergey Gurin

Scale:

1/2 " = 1 '

Page:

6 of 6


- Crown Moulding


→ 42" Upper Cabinets

- Light valence


Pot & Pan Drawers

✓ Raised breakfast bar

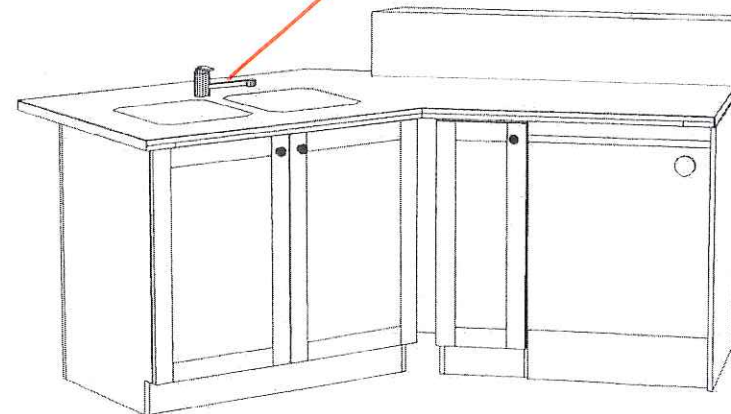

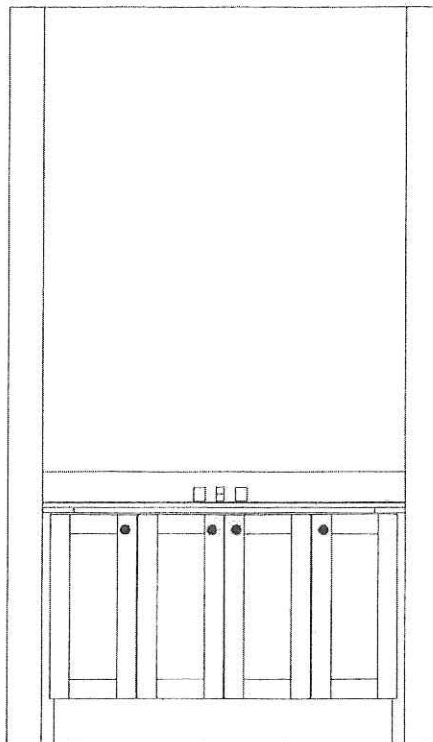

Main Bathroom

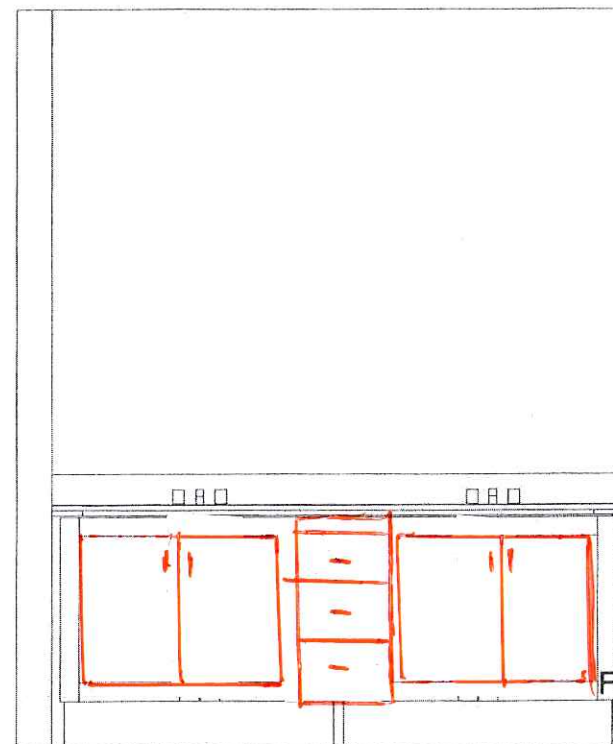

Ensuite

MR kitchens

Contractor:

Phoenix Homes

Designer:

G.B.

Job Number:

Date:

06/25/10

Notes:

Forbes 35-3

Heritage Hills

Lot 6

Sergey Gurin

Scale:

1/2 " = 1 '

Page:

6 of 6