



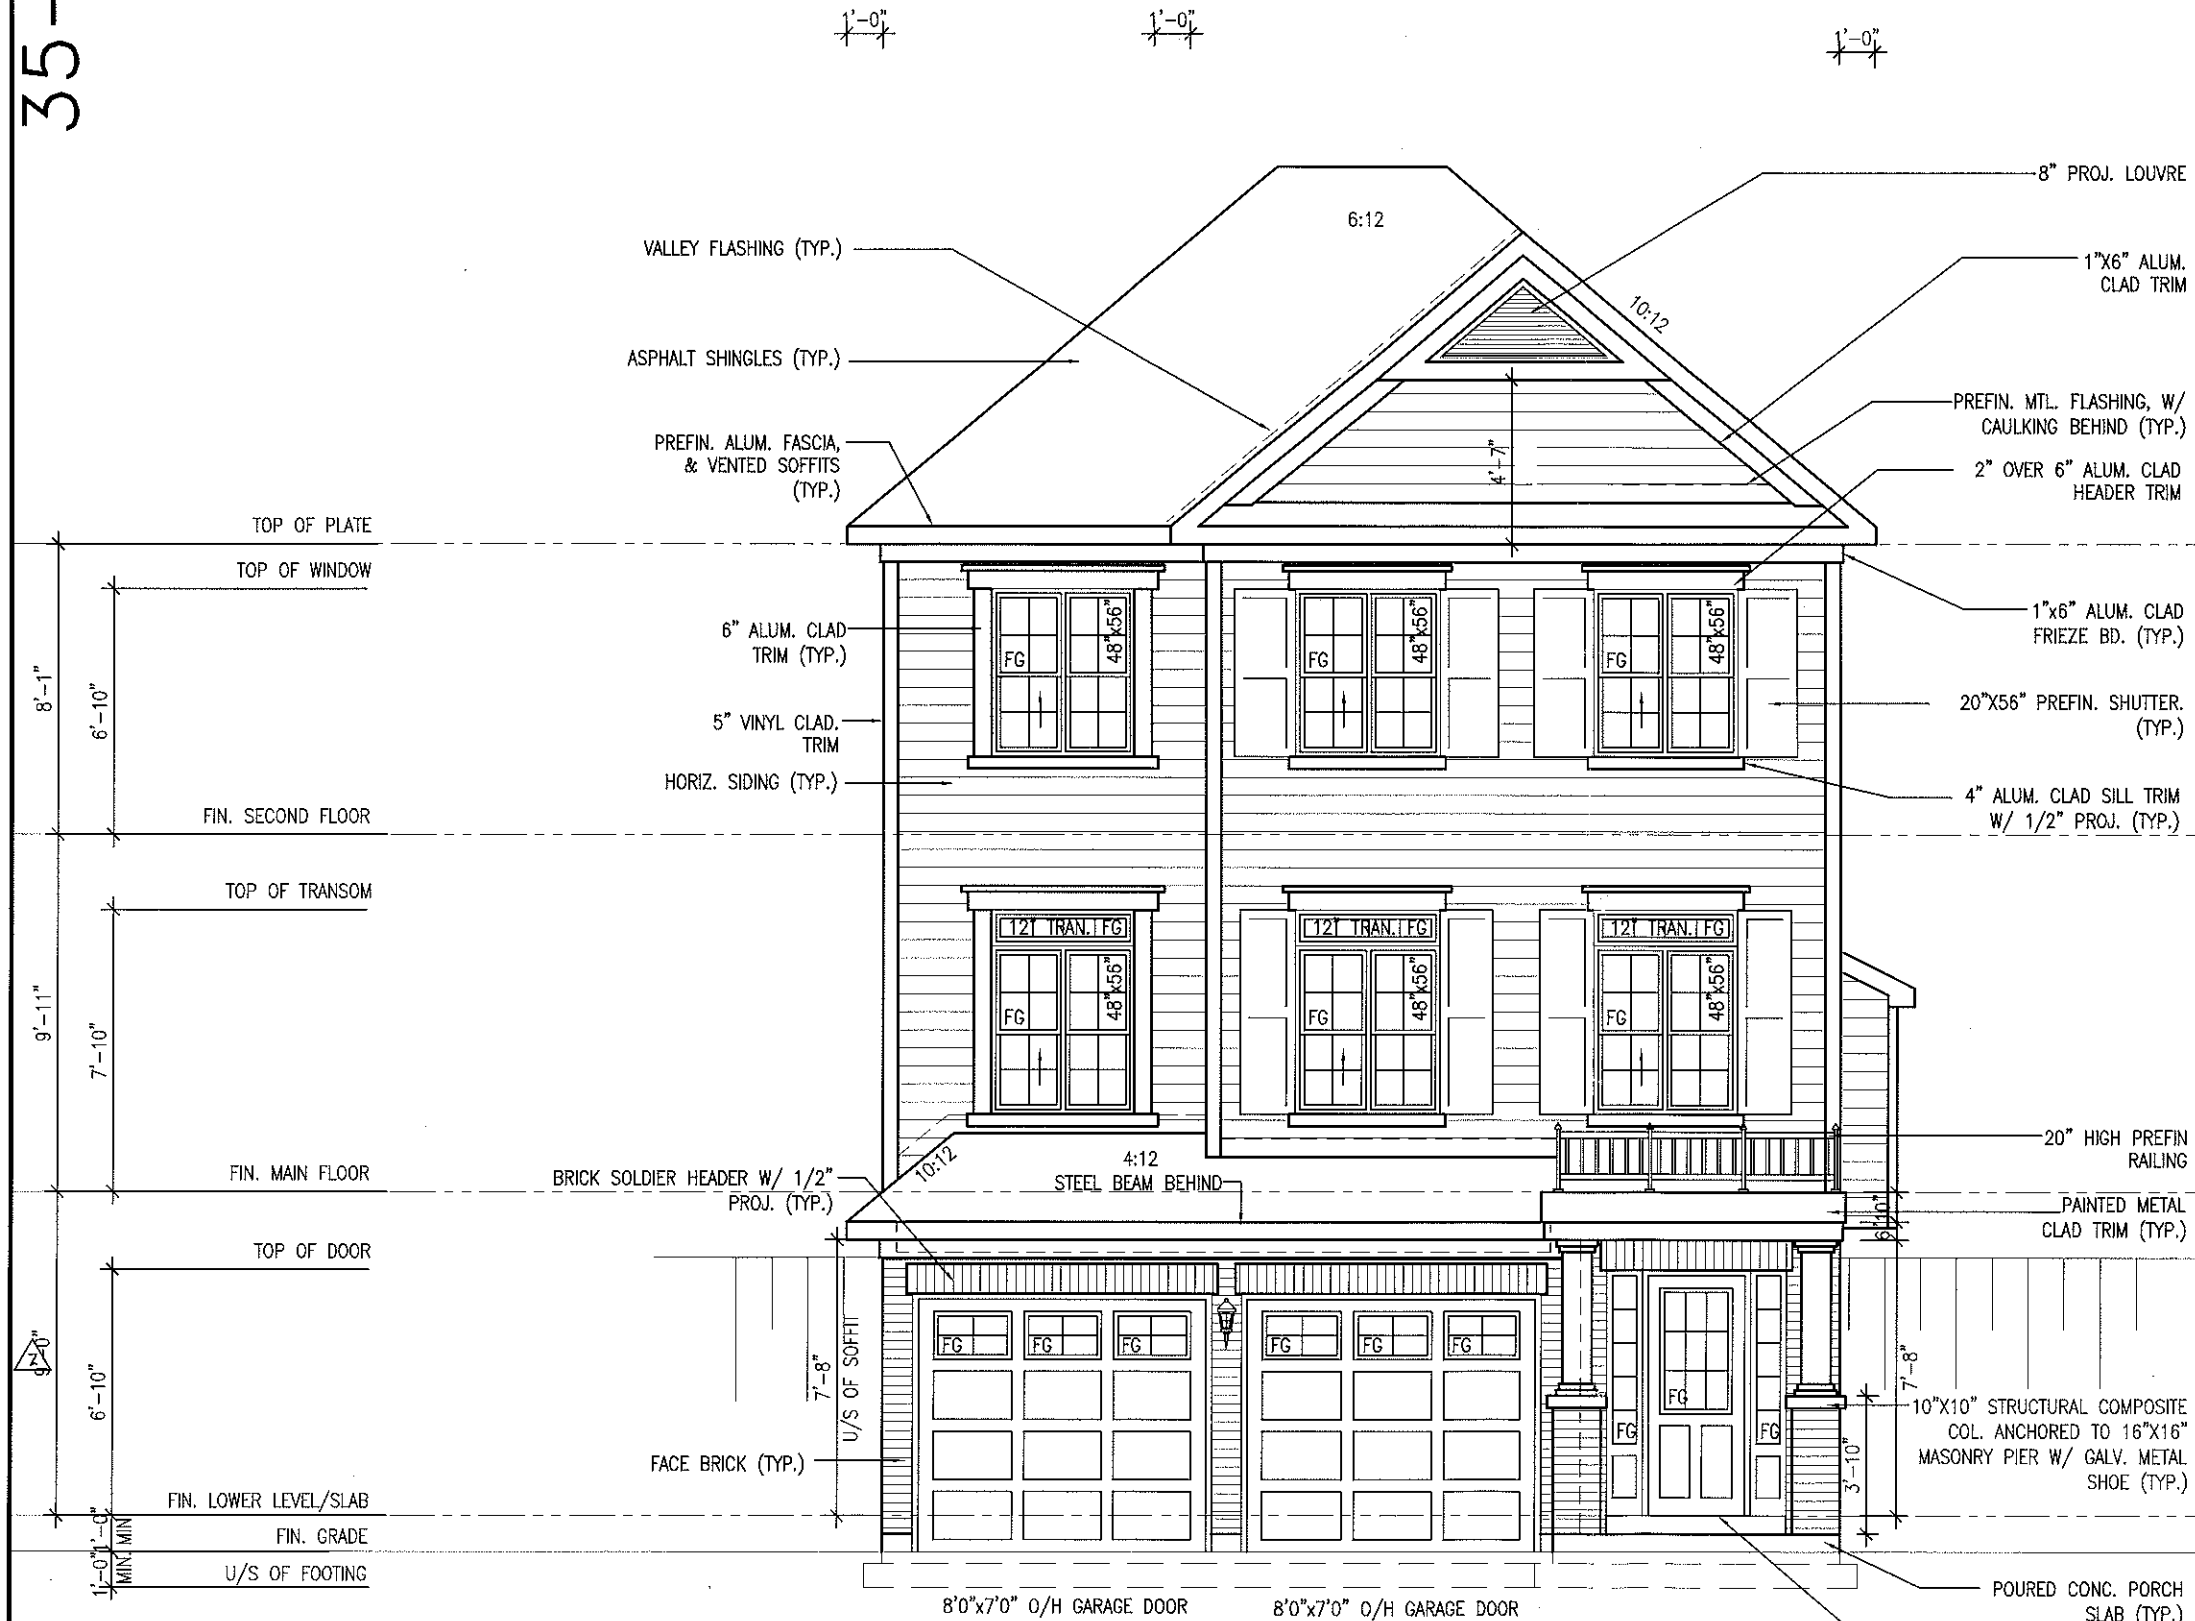

ROOF PLAN EL. 'A'

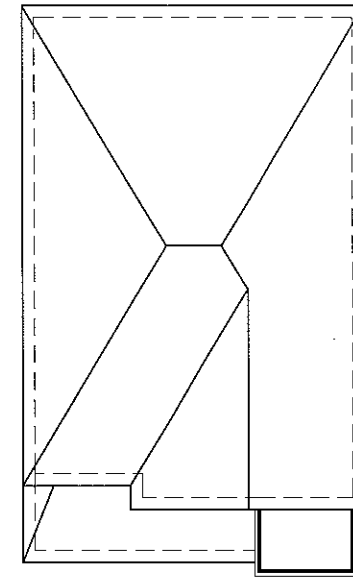

NOTE: SEE "APPROVED INDIVIDUAL SITE/GRADING PLAN" FOR ACTUAL LOCATION OF "PROPOSED FINISH GRADE LINE" RELATIVE TO USF OR TOP OF FOUNDATION. DIMENSIONS AND EXTENT OF CHECK-DOWN CONCRETE STEP FOOTING AND FOUNDATION SHOWN ON THIS PLAN ARE FOR REFERENCE ONLY AND MAY BE ADJUSTED ON SITE DUE TO GRADING CONDITIONS, STEP FOOTING TO CONFORM TO O.B.C. 9.15.3.9. DEPTH OF FOUNDATION TO MEET REQUIREMENTS OF O.B.C. 9.12.2.2

FRONT ELEVATION 'A'


footprint: 35-2	sheet title: FRONT ELEVATION-A	drawn by: RK McLEAN	checked by: JANUARY 2008	scale: 3/16"=1'	sheet no: 5A/9
-----------------	--------------------------------	---------------------	--------------------------	-----------------	----------------

No.	Description	By	Date
2	REV. AS PER CONST. SUMMARY	SEP10-12	5D
1	REV. AS PER CONST. SUMMARY	SEP6-12	5D

COLUMBIA-2008-A	SITE: HERITAGE HILLS	LOT NUMBER: 11	CIVIC ADDRESS: 233 HUNTSVILLE DR.
-----------------	----------------------	----------------	-----------------------------------

Viljoen Architect Inc.	300 A. Wilson Avenue North York, Ontario M3H 1S6 TEL: (416) 630-2255 FAX: (416) 630-4782
------------------------	--

PHOENIX HOMES

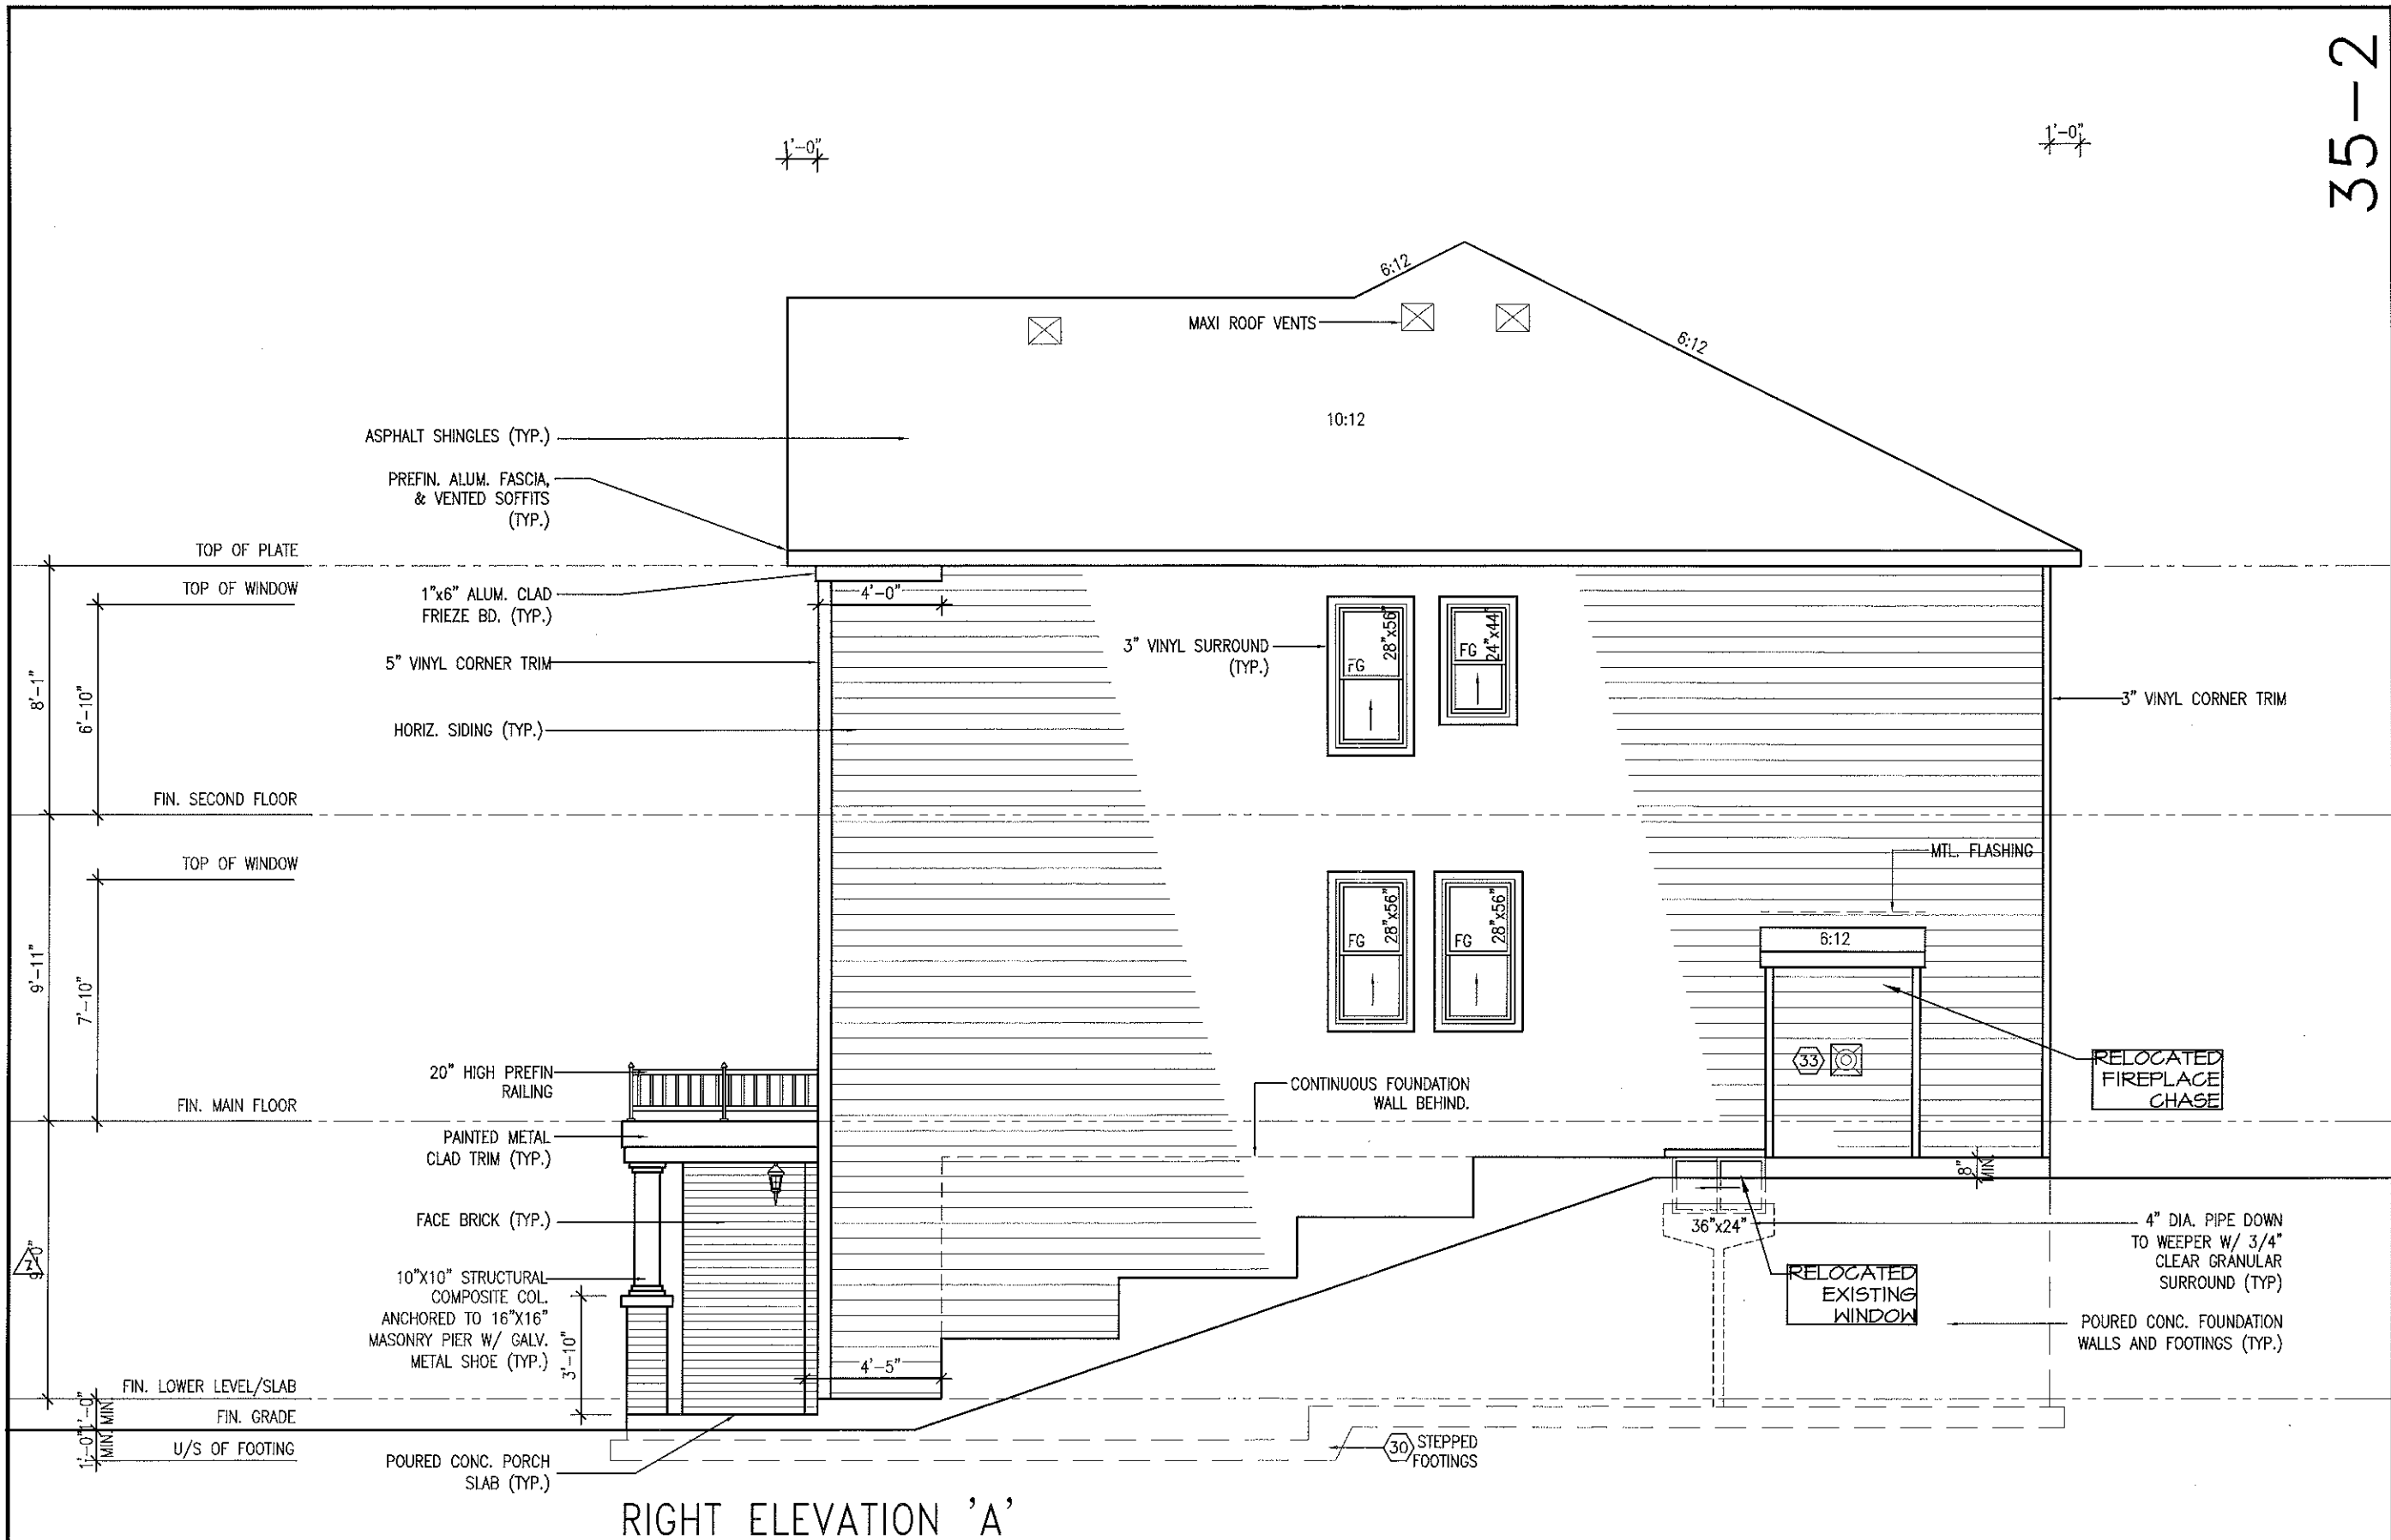

NOTE: SEE "APPROVED INDIVIDUAL SITE/GRADING PLAN" FOR ACTUAL LOCATION OF "PROPOSED FINISH GRADE LINE" RELATIVE TO USF OR TOP OF FOUNDATION. DIMENSIONS AND EXTENT OF CHECK-DOWN CONCRETE STEP FOOTING AND FOUNDATION SHOWN ON THIS PLAN ARE FOR REFERENCE ONLY AND MAY BE ADJUSTED ON SITE DUE TO GRADING CONDITIONS, STEP FOOTING TO CONFORM TO O.B.C. 9.15.3.9. DEPTH OF FOUNDATION TO MEET REQUIREMENTS OF O.B.C. 9.12.2.2

RIGHT ELEVATION 'A'

913 SQ. FT.	WALL AREA
1.2 M (7%)	LIMITING DISTANCE
63.91 SQ. FT.	OPENINGS ALLOWED
45.21 SQ. FT.	OPENINGS PROVIDED


35-2


footprint: 35-2	sh. title: SIDE ELEVATION-A	drawn by: RK McLEAN	checked by: JANUARY 2008	scale: 3/16"=1'	sheet no: 6A/9
-----------------	-----------------------------	---------------------	--------------------------	-----------------	----------------

No.	Description	By	Date
2	REV. AS PER CONST. SUMMARY	SEP10-12	SD
1	REV. AS PER CONST. SUMMARY	SEP6-12	SD

COLUMBIA-2008-A	SITE: HERITAGE HILLS	LOT NUMBER: 11	CIVIC ADDRESS: 233 HUNTSVILLE DR.
-----------------	----------------------	----------------	-----------------------------------

Viljoen Architect Inc.	300 A Wilson Avenue North York, Ontario M2H 1S8 TEL: (416) 630-2255 FAX: (416) 630-4782
------------------------	---

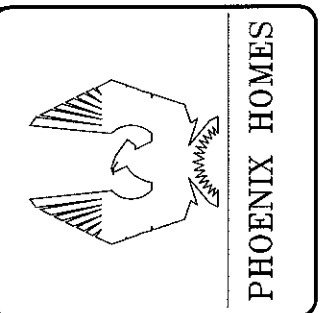

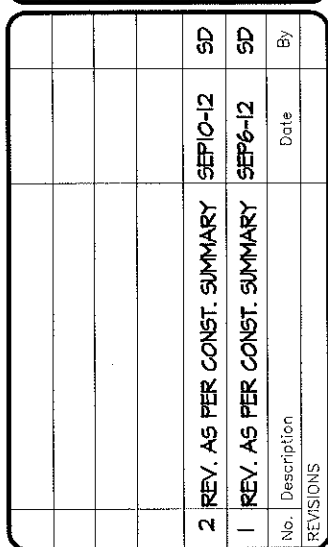


SITE: HERITAGE HILLS

LOT NUMBER: 11

CIVIC ADDRESS: 233 HUNTSVILLE DR.


**Viljoen
Architect
Inc.**

300 A Wilson Avenue
North York, Ontario
M3H 1S8
TEL: (416) 630-2255
FAX: (416) 630-4782

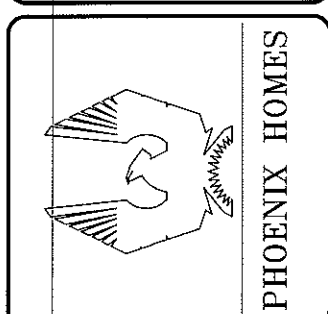


NOTE: SEE "APPROVED INDIVIDUAL SITE/GRADING PLAN" FOR ACTUAL LOCATION OF "PROPOSED FINISH GRADE LINE" RELATIVE TO USF OR TOP OF FOUNDATION. DIMENSIONS AND EXTENT OF CHECK-DOWN CONCRETE STEP FOOTING AND FOUNDATION SHOWN ON THIS PLAN ARE FOR REFERENCE ONLY AND MAY BE ADJUSTED ON SITE DUE TO GRADING CONDITIONS, STEP FOOTING TO CONFORM TO O.B.C. 9.15.3.9. DEPTH OF FOUNDATION TO MEET REQUIREMENTS OF O.B.C. 9.12.2.2

WALL AREA	909 SQ. FT.
LIMITING DISTANCE	1.2 M (7%)
OPENINGS ALLOWED	63.63 SQ. FT.
OPENINGS PROVIDED	51.21 SQ. FT.

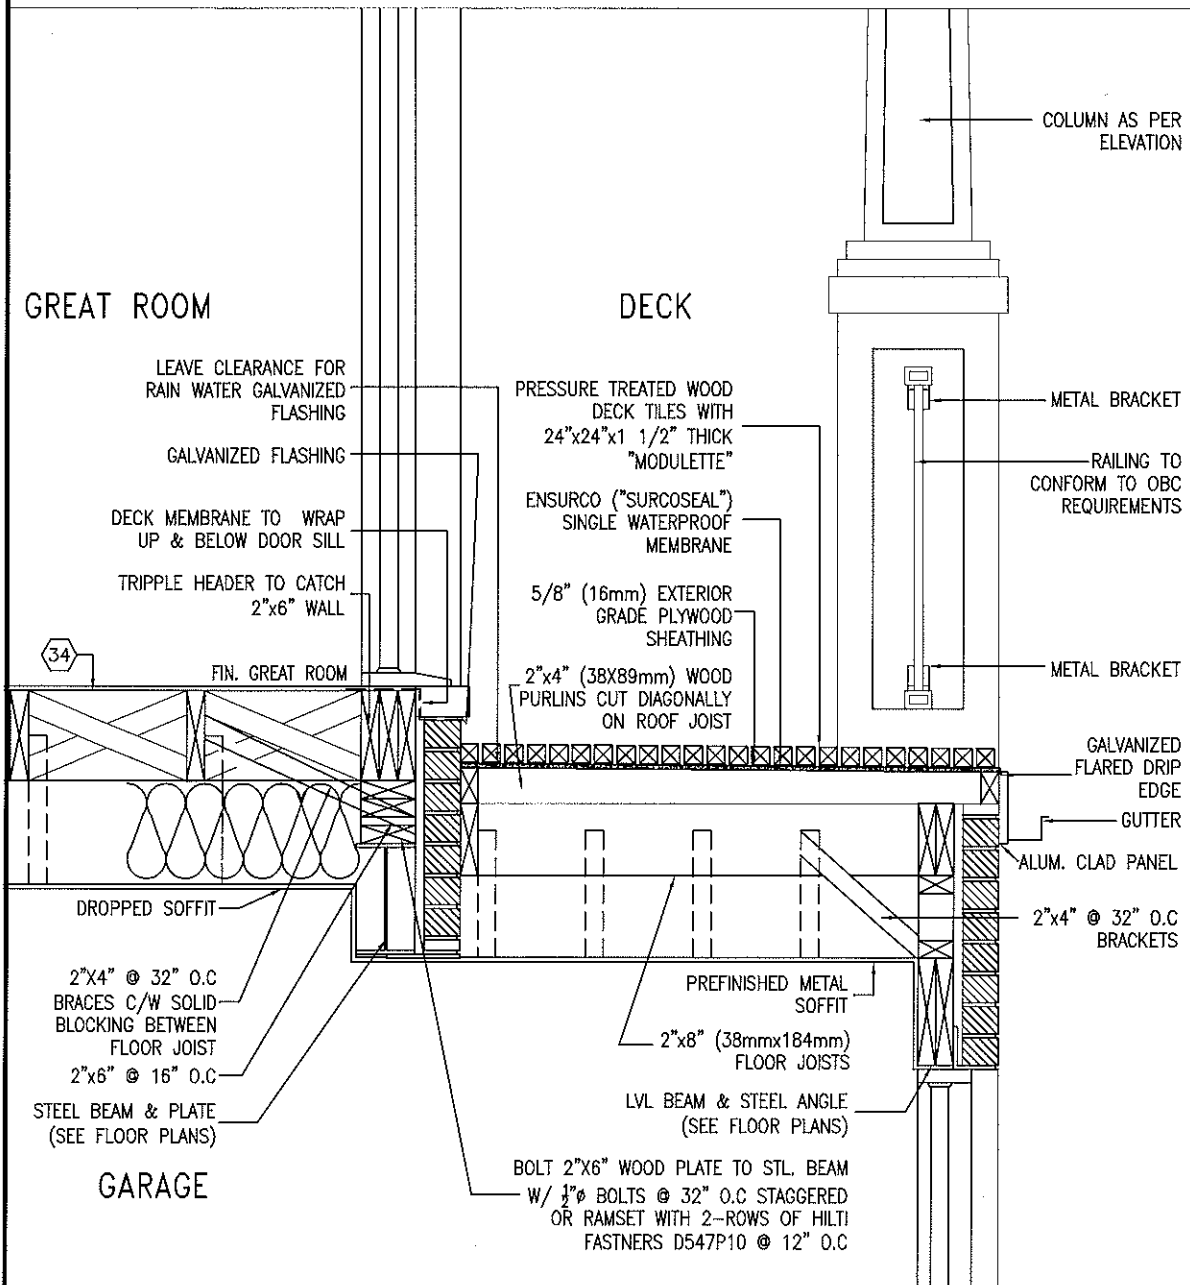

SECTION THRU DECK
NTS

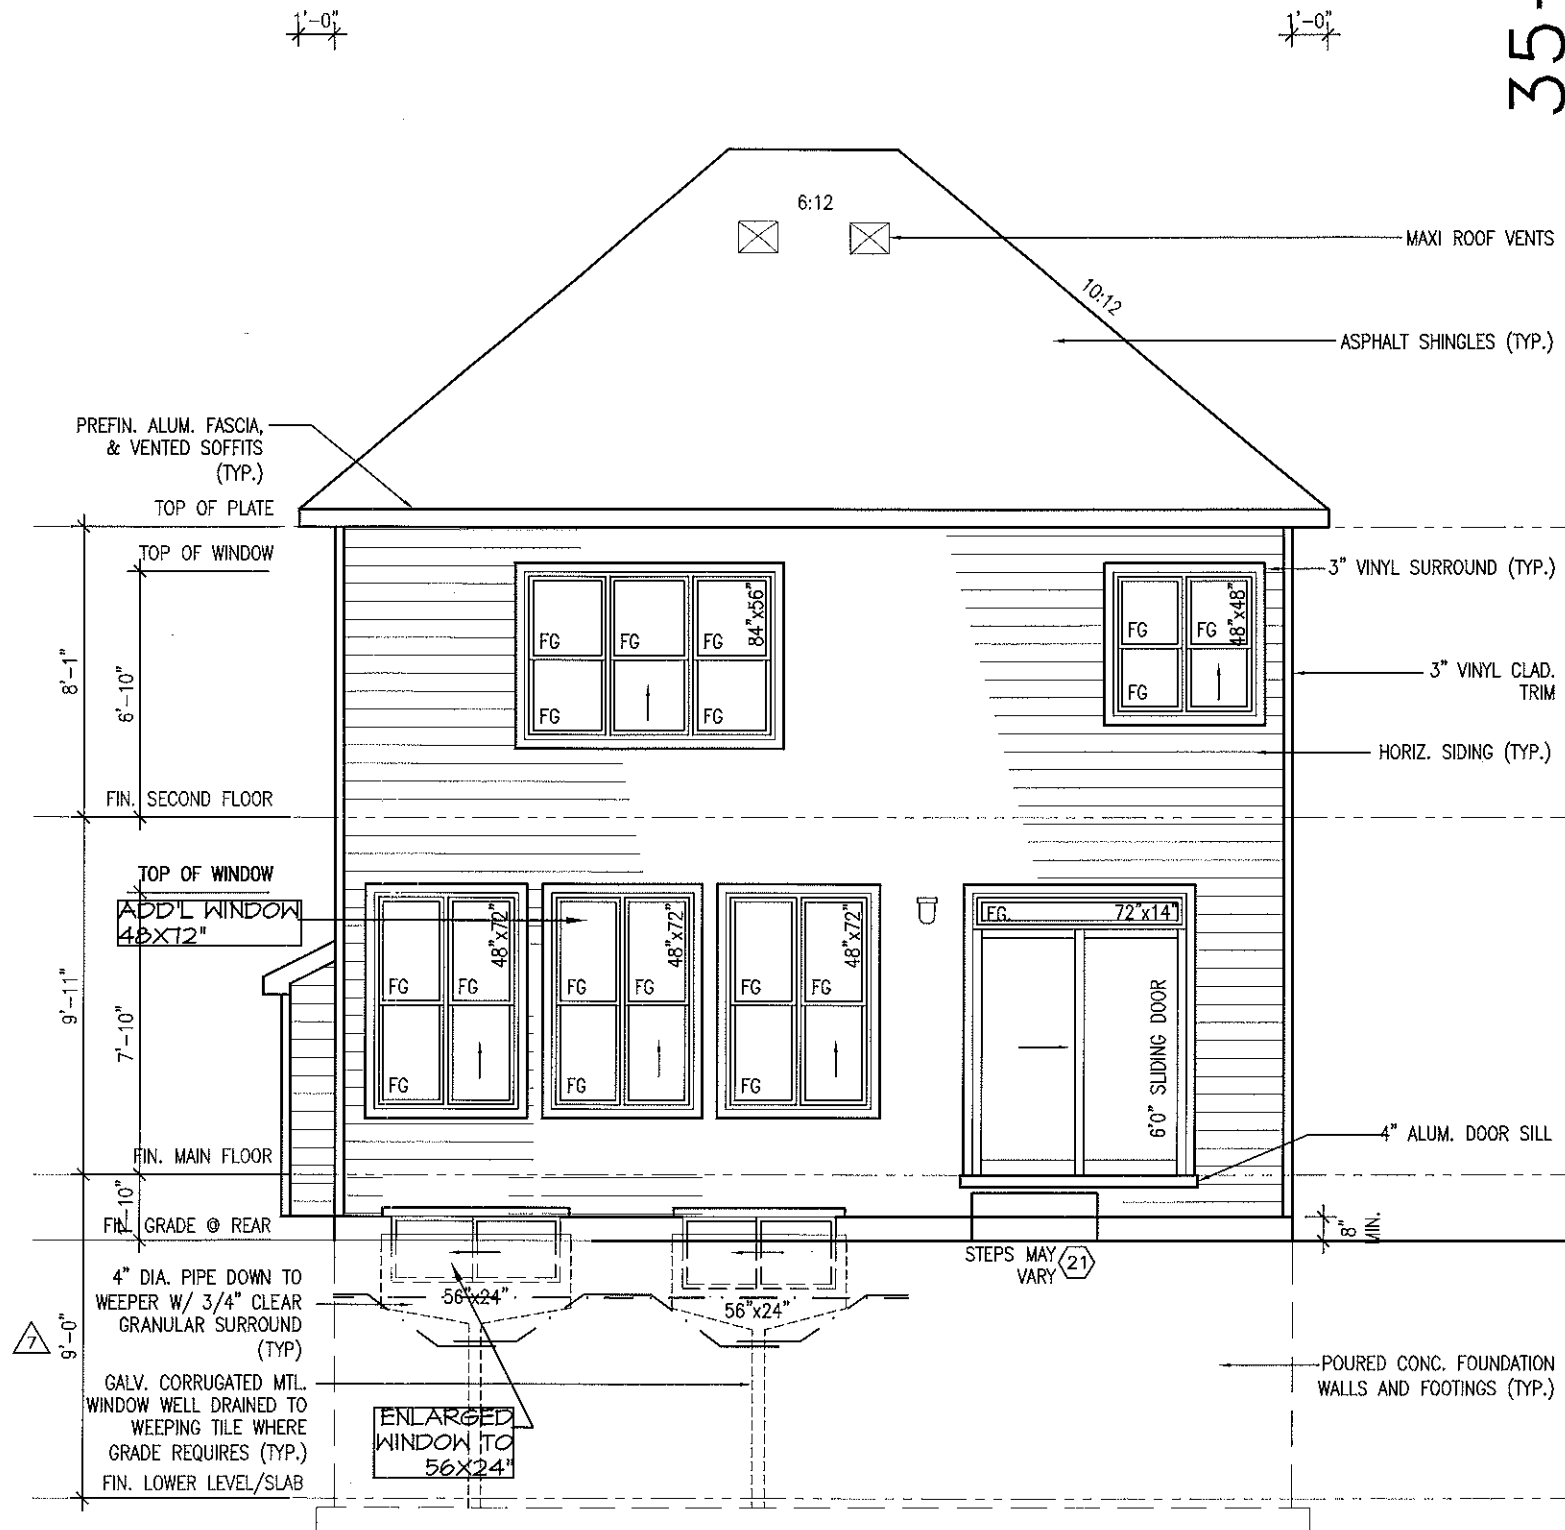

REAR ELEVATION

NOTE: SEE "APPROVED INDIVIDUAL SITE/GRADING PLAN" FOR ACTUAL LOCATION OF "PROPOSED FINISH GRADE LINE" RELATIVE TO USF OR TOP OF FOUNDATION. DIMENSIONS AND EXTENT OF CHECK-DOWN CONCRETE STEP FOOTING AND FOUNDATION SHOWN ON THIS PLAN ARE FOR REFERENCE ONLY AND MAY BE ADJUSTED ON SITE DUE TO GRADING CONDITIONS, STEP FOOTING TO CONFORM TO O.B.C. 9.15.3.9. DEPTH OF FOUNDATION TO MEET REQUIREMENTS OF O.B.C. 9.12.2.2

35-2


footprint: 35-2	sheet: REAR ELEVATION
drawn by: RK McLEAN	checked by: JANUARY 2008
date: 3/16	scale: 3/16"=1'
sheet no: 8	9

2 REV. AS PER CONST. SUMMARY	SEP10-12	SD
1 REV. AS PER CONST. SUMMARY	SEP6-12	SD
No. Description	Date	By
REVISIONS		

COLUMBIA-2008-A/B
SITE: HERITAGE HILLS
LOT NUMBER: 11
CIVIC ADDRESS: 233 HUNTSVILLE DR.

Viljoen Architect Inc.
300 A Wilson Avenue North York, Ontario M3H 1S6 TEL: (416) 630-2255 FAX: (416) 630-4782

PHOENIX HOMES

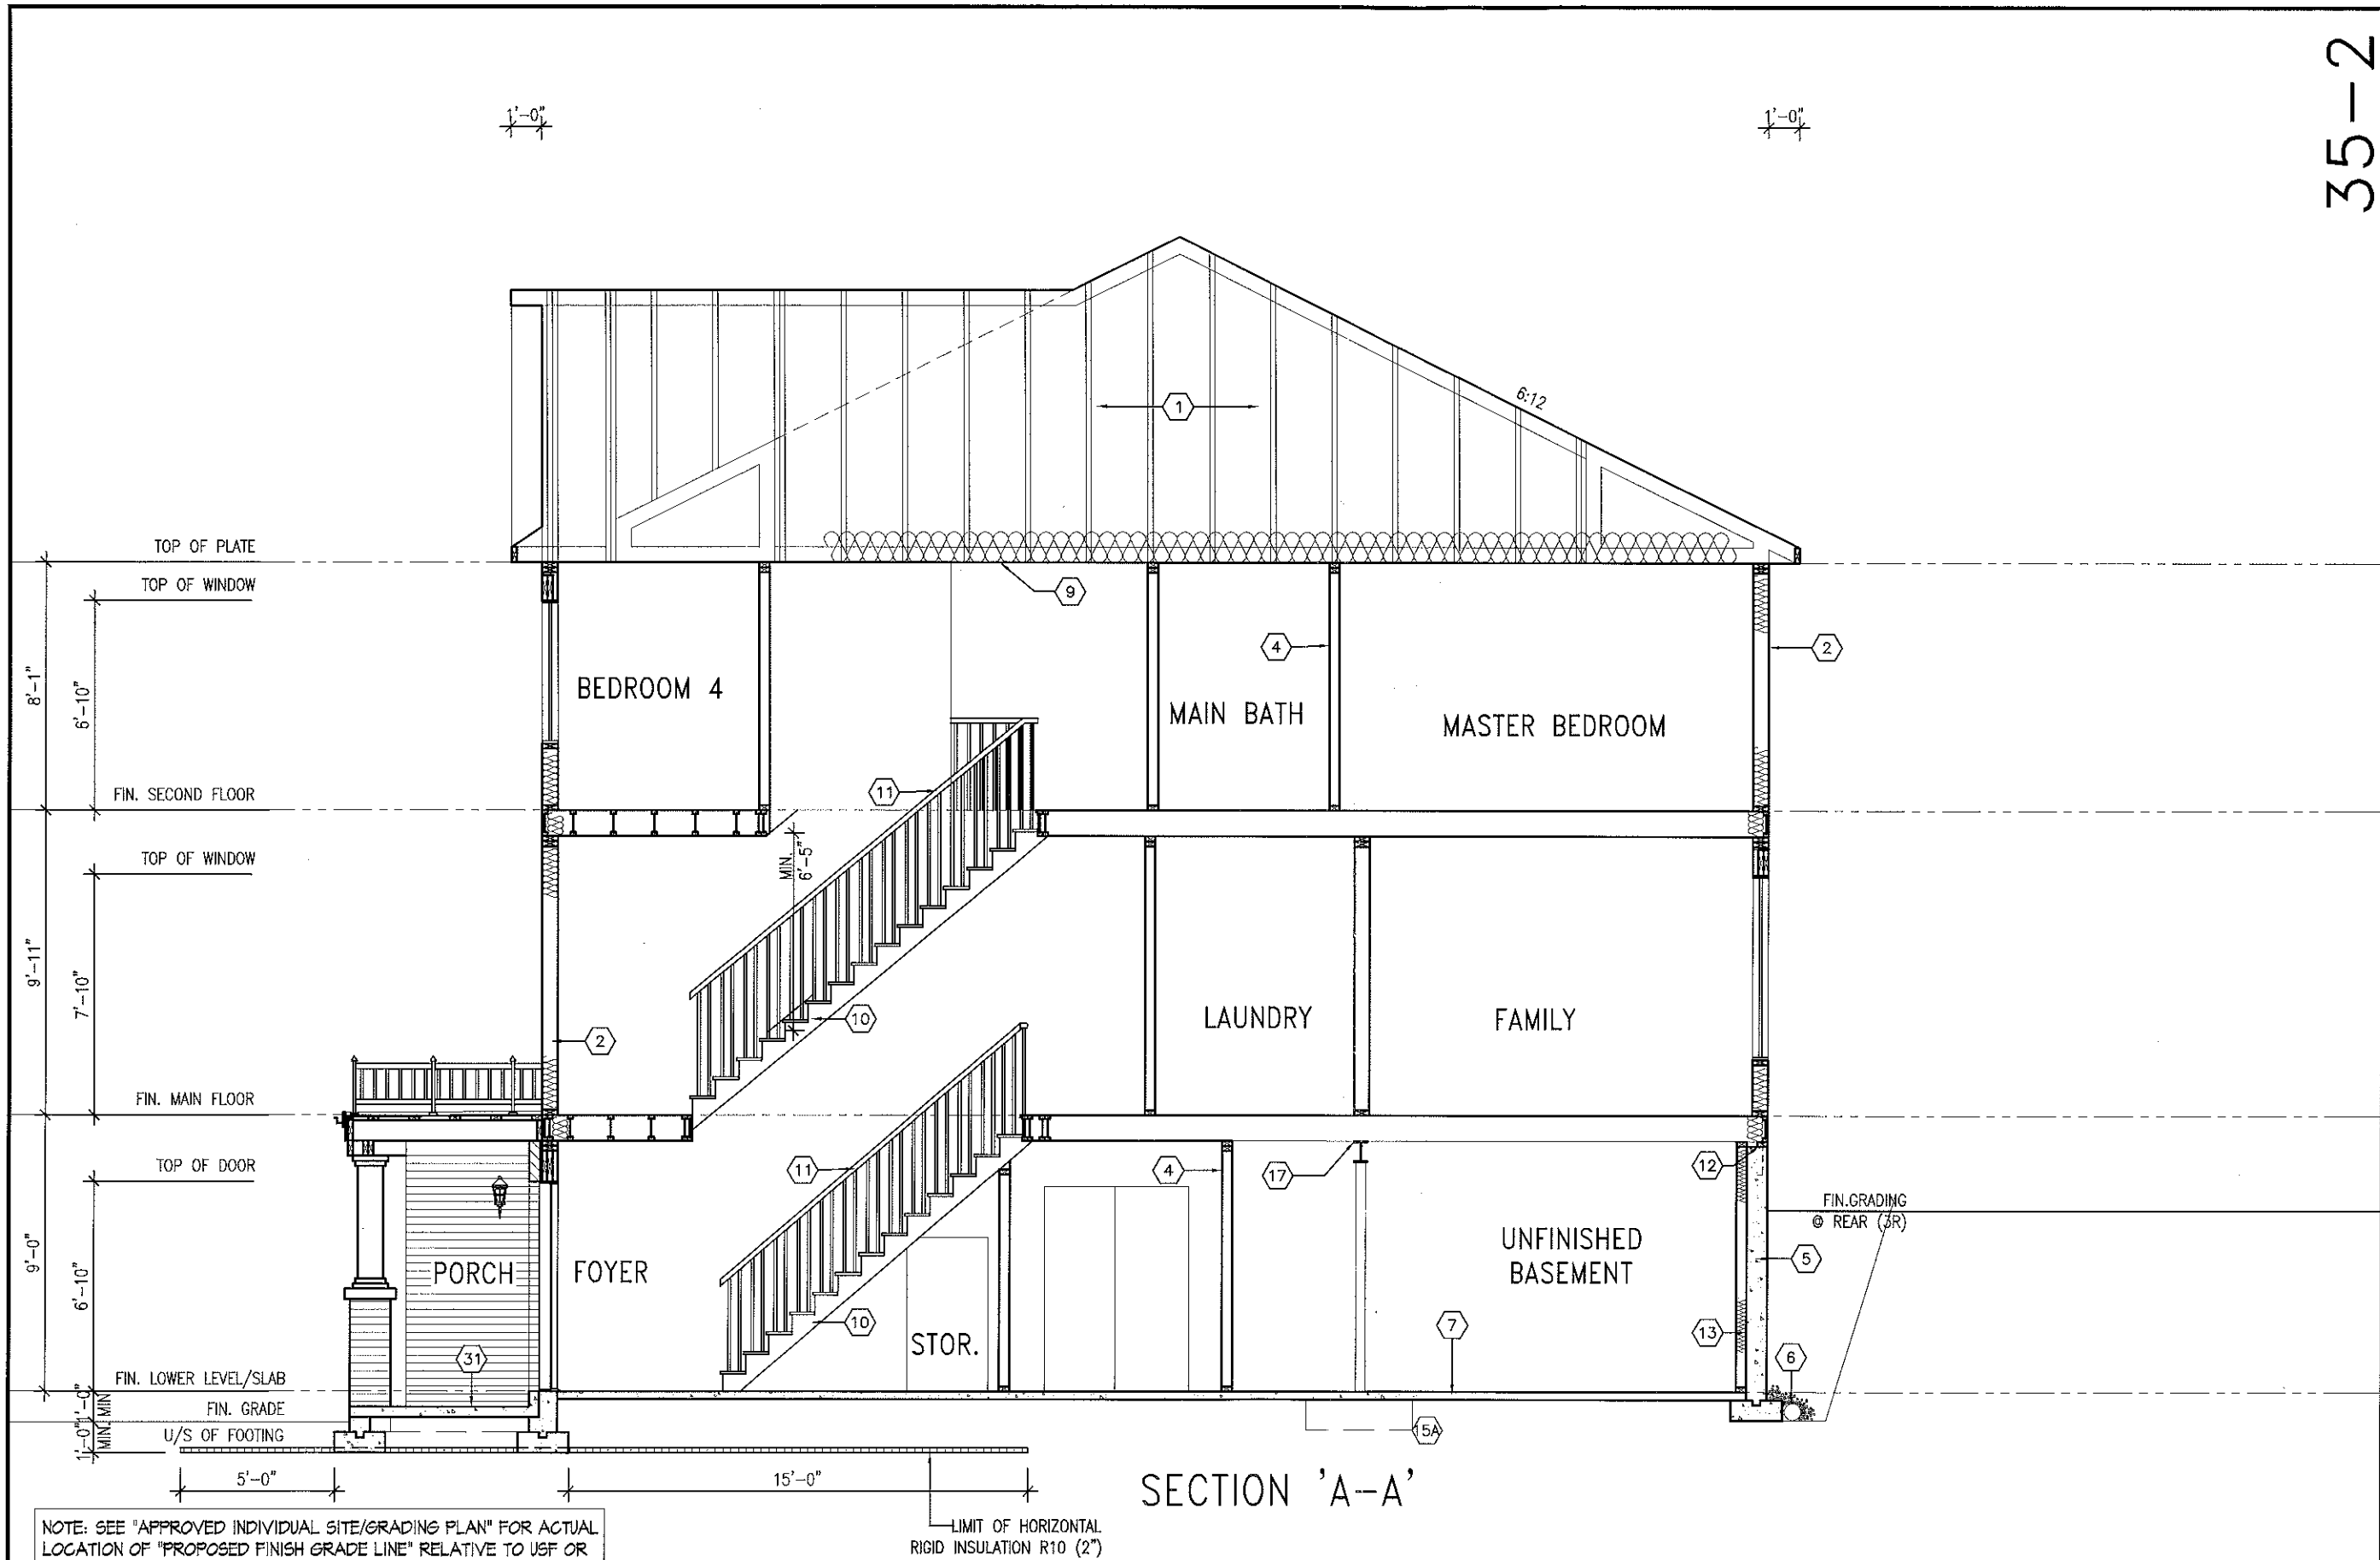

NOTE: SEE "APPROVED INDIVIDUAL SITE/GRADING PLAN" FOR ACTUAL LOCATION OF "PROPOSED FINISH GRADE LINE" RELATIVE TO USF OR TOP OF FOUNDATION. DIMENSIONS AND EXTENT OF CHECK-DOWN CONCRETE STEP FOOTING AND FOUNDATION SHOWN ON THIS PLAN ARE FOR REFERENCE ONLY AND MAY BE ADJUSTED ON SITE DUE TO GRADING CONDITIONS, STEP FOOTING TO CONFORM TO O.B.C. 9.15.3.1. DEPTH OF FOUNDATION TO MEET REQUIREMENTS OF O.B.C. 9.12.2.2

35-2

footprint:	35-2
ent. title:	SECTION-A
drawn by:	RK McLEAN
checked by:	
date:	JANUARY 2008
scale:	3/16"=1'
sheet no:	9A
	9

No.	Description	Date	By
2	REV. AS PER CONST. SUMMARY	SEP10-12	SD
1	REV. AS PER CONST. SUMMARY	SEP6-12	SD

COLUMBIA-2008-A

SITE: HERITAGE HILLS

LOT NUMBER: 11

CIVIC ADDRESS: 233 HUNTSVILLE DR.

Viljoen Architect Inc.

300 A. Wilson Avenue
North York, Ontario
M3H 1S8
TEL: (416) 630-2255
FAX: (416) 630-4782

PHOENIX HOMES