


REDUCED WINDOW
TO 36X24"




LOWER LEVEL PLAN ELEV. 'B' W/ LOFT
± 602 SQ.FT.

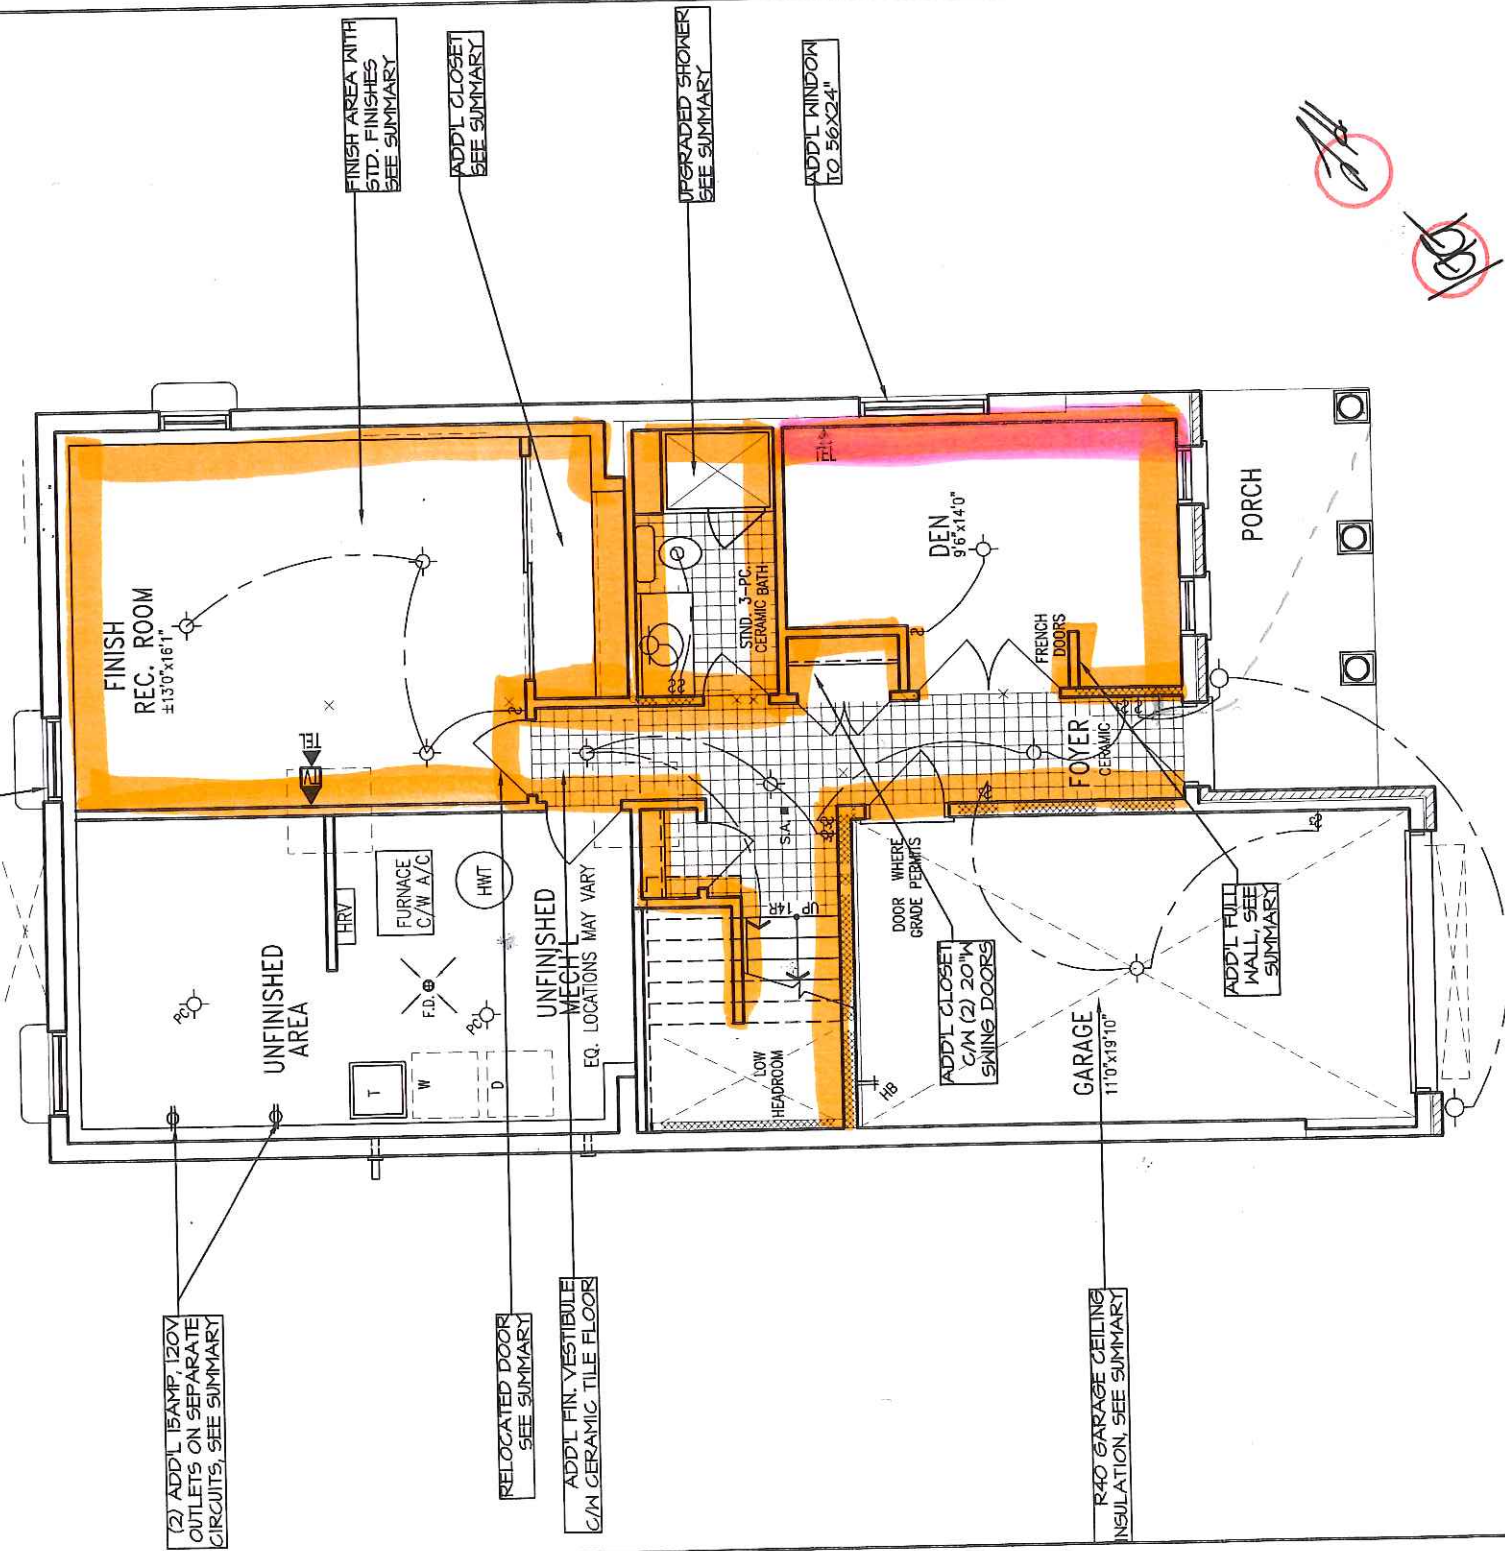

SW 7661 Reflection
SW 7658 Gray Clouds
SW 6949 Slick Blue

35-1

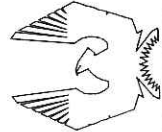

PHOENIX HOMES

Viljoen
Architect
Inc.

300 A. Wilcox Avenue
W311 158th, Ontario
TEL: (416) 630-2255
FAX: (416) 630-4782

BLACKCOMB-2008-B


SITE: HERITAGE HILLS

13

LOT NUMBER:
CIVIC ADDRESS:
231 HUNTSVILLE DR.

Footprint:	35-1
shl. title:	LOWER LEVEL-B W/LOFT
drawn by:	KMc
checked by:	JANUARY 2008
date:	3/16/11
scale:	3/16"=1'
sheet no.:	2B.1
	8

No.	Description	Date	By
2	REV. AS PER CONST. SUMMARY	APR23-13	SD
1	REV. AS PER CONST. SUMMARY	MAR5-13	SD
REVISIONS			

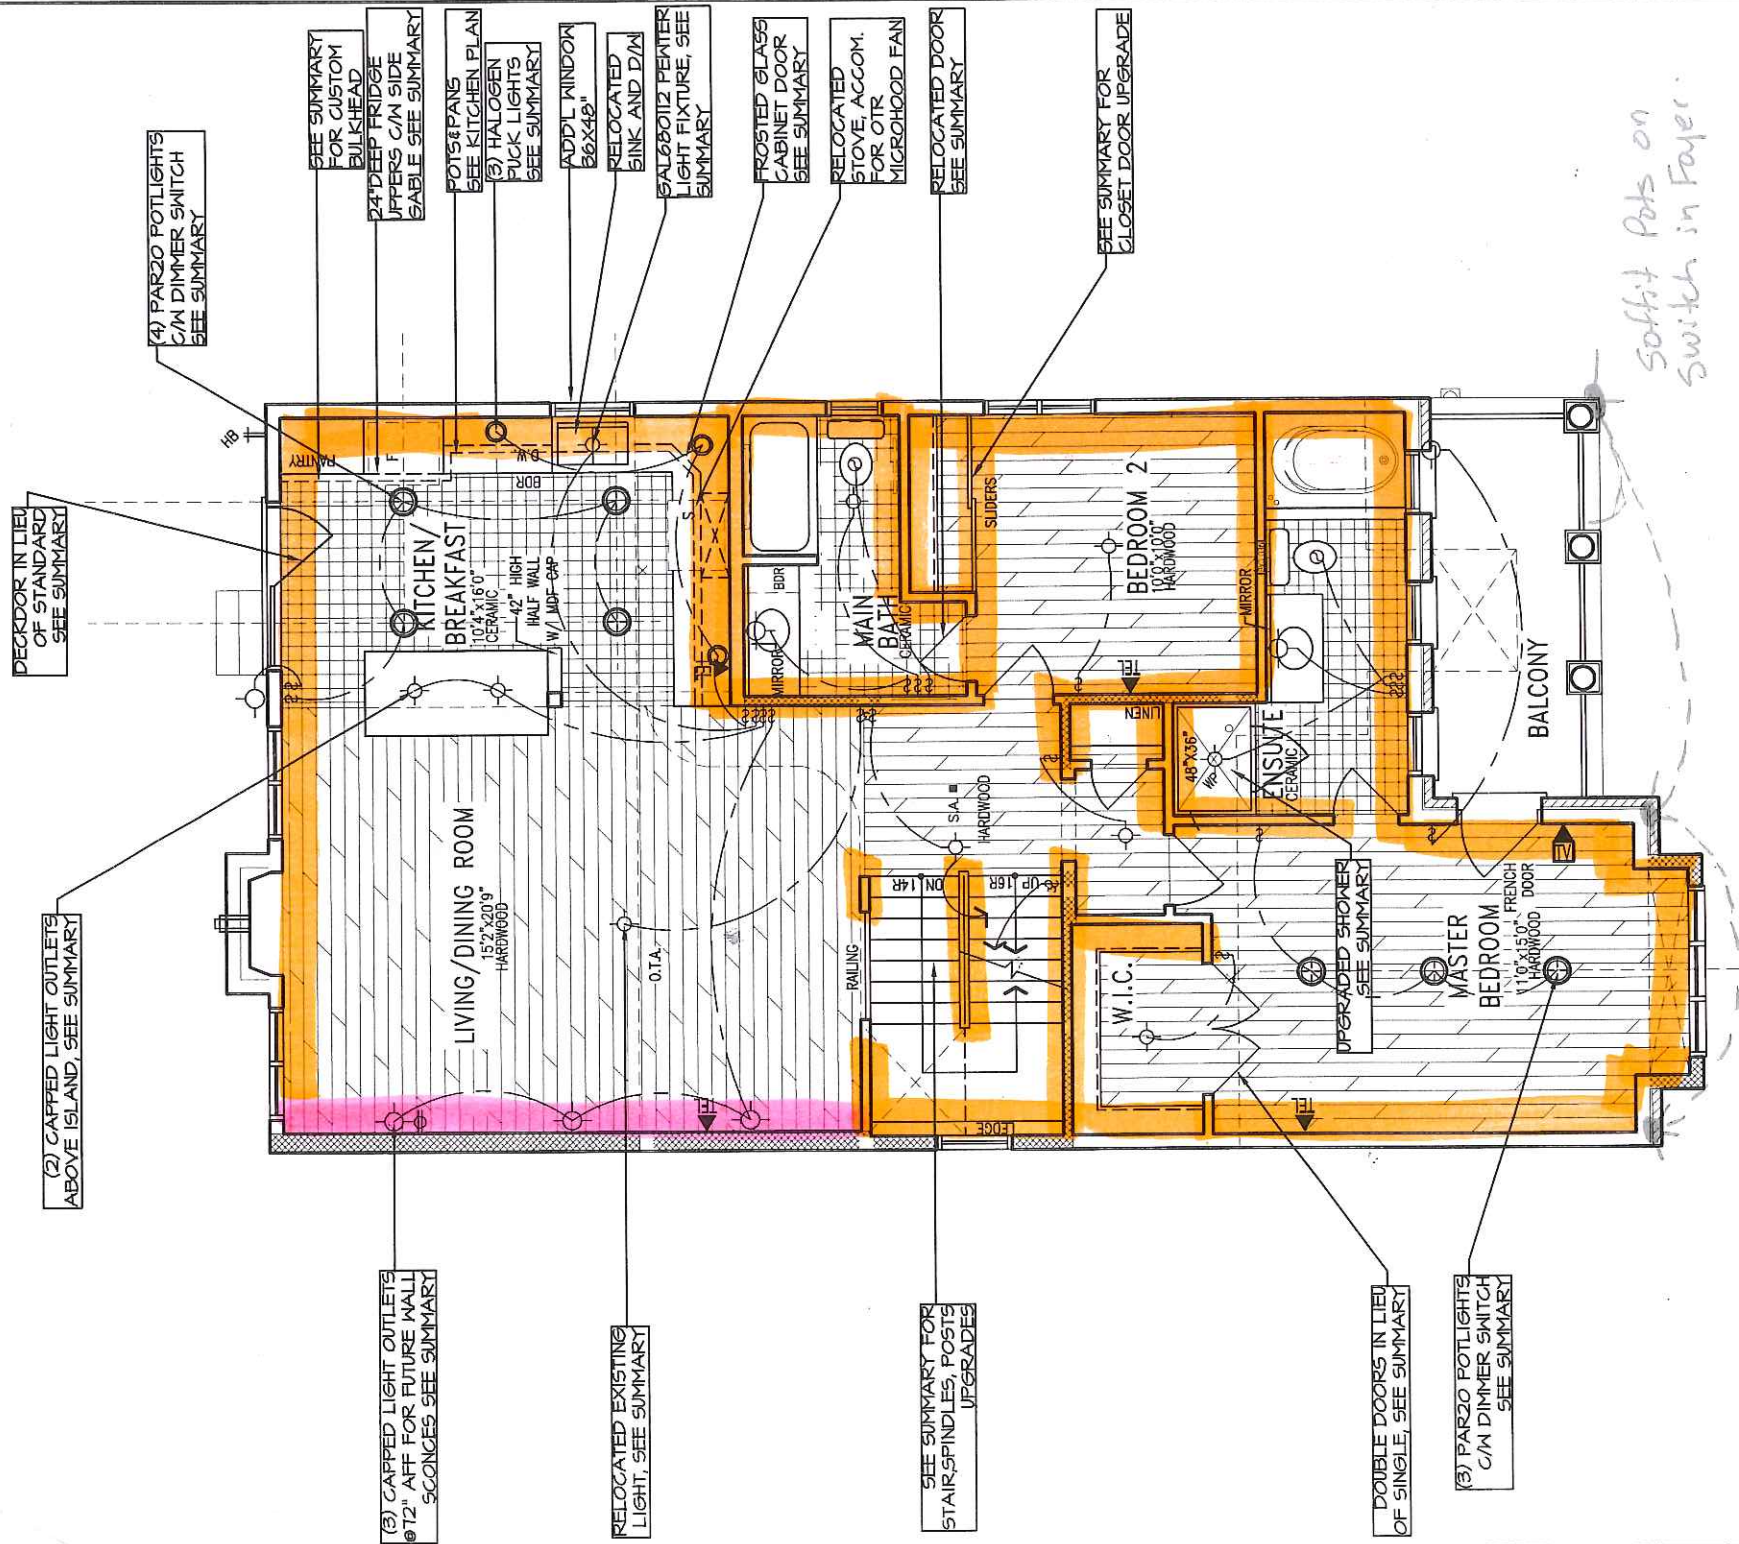

OPT. MAIN FLOOR PLAN ELEV. 'B' W/ LOFT

SW 7661 Reflection
 SW 7658 Gray Clouds
 SW 6949 Slick Blue

35-1

PHOENIX HOMES

Viljoen Architect Inc.

300 A. Wilson Avenue
 North York, Ontario
 M3H 1S8
 TEL: (416) 630-2255
 FAX: (416) 630-4782

BLACKCOMB-2008-B

SITE: **HERITAGE HILLS**

LOT NUMBER: **13**

CIVIC ADDRESS: 237 HUNTSVILLE DR.

No.	Description	Date	By
2	REV. AS PER CONST. SUMMARY	APR23-15	SD
1	REV. AS PER CONST. SUMMARY	MAR3-15	SD

footprint: 35-1

ent. title: MAIN FLOOR-B W/LOFT


drawn by: M NC

checked by: JANUARY 2008

date: 3/16/11

scale: 3/16"=1'


sheet no: 8

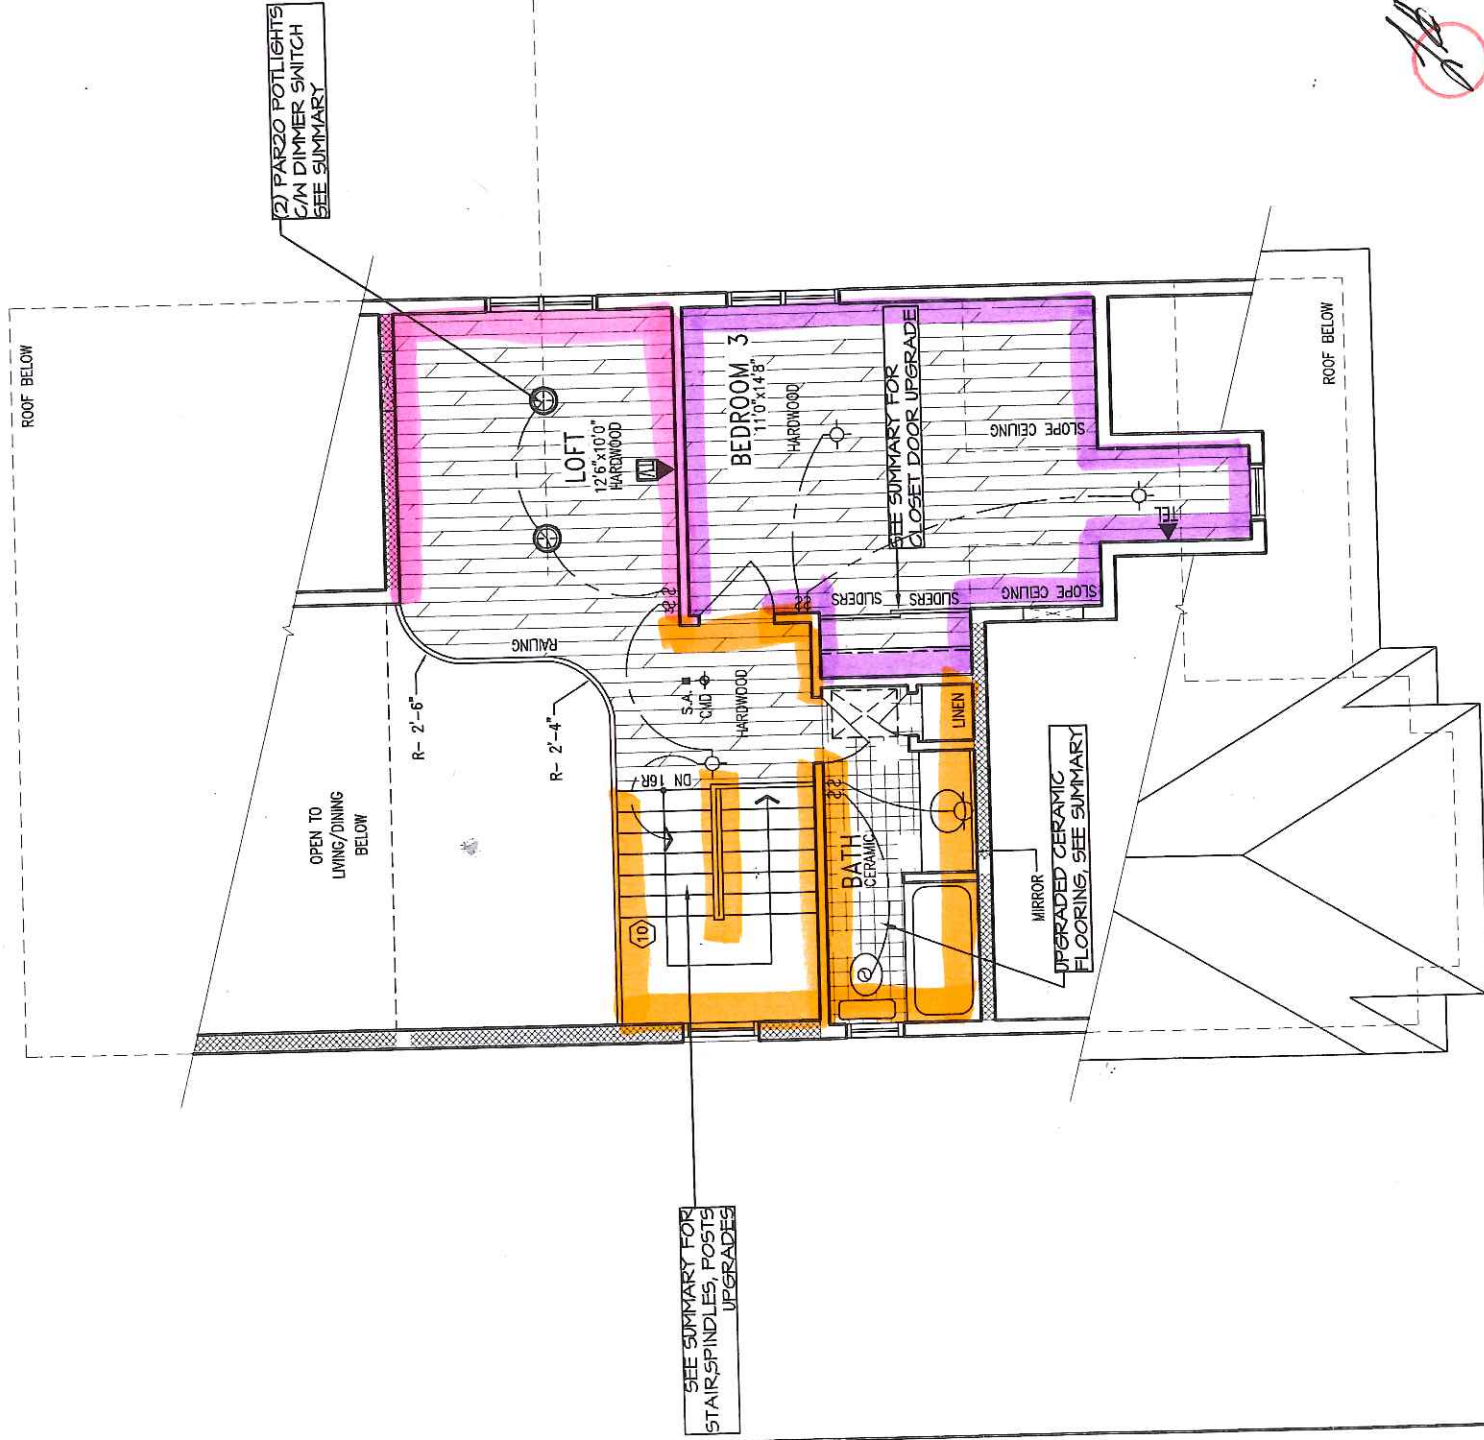

OPT. LOFT PLAN ELEV. 'B'

SW 7661 Reflection
 SW 7658 Gray Clouds
 SW 6949 Slick Blue

35-1

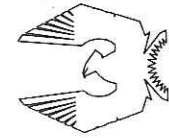

PHOENIX HOMES

**Viljoen
Architect
Inc.**

300 A. Wilson Avenue
 North York, Ontario
 M3H 1S8
 TEL: (416) 630-2255
 FAX: (416) 630-4782

BLACKCOMB-2008-B

SITE: HERITAGE HILLS

LOT NUMBER:

13

CIVIC ADDRESS:
 231 HUNTSVILLE DR.

No.	Description	Date	By
2	REV. AS PER CONST. SUMMARY	APR23-13	SD
1	REV. AS PER CONST. SUMMARY	MAR5-13	SD

Footprint:	35-1
Shr. Title:	LOFT PLAN B
Drawn By:	HMC
Checked By:	
Date:	JANUARY 2008
Scale:	3/16"=1'
Sheet No:	4B.1 8