



LOT 18 H.H. - LISTELLO INSTALLATION
IN ENSUITE

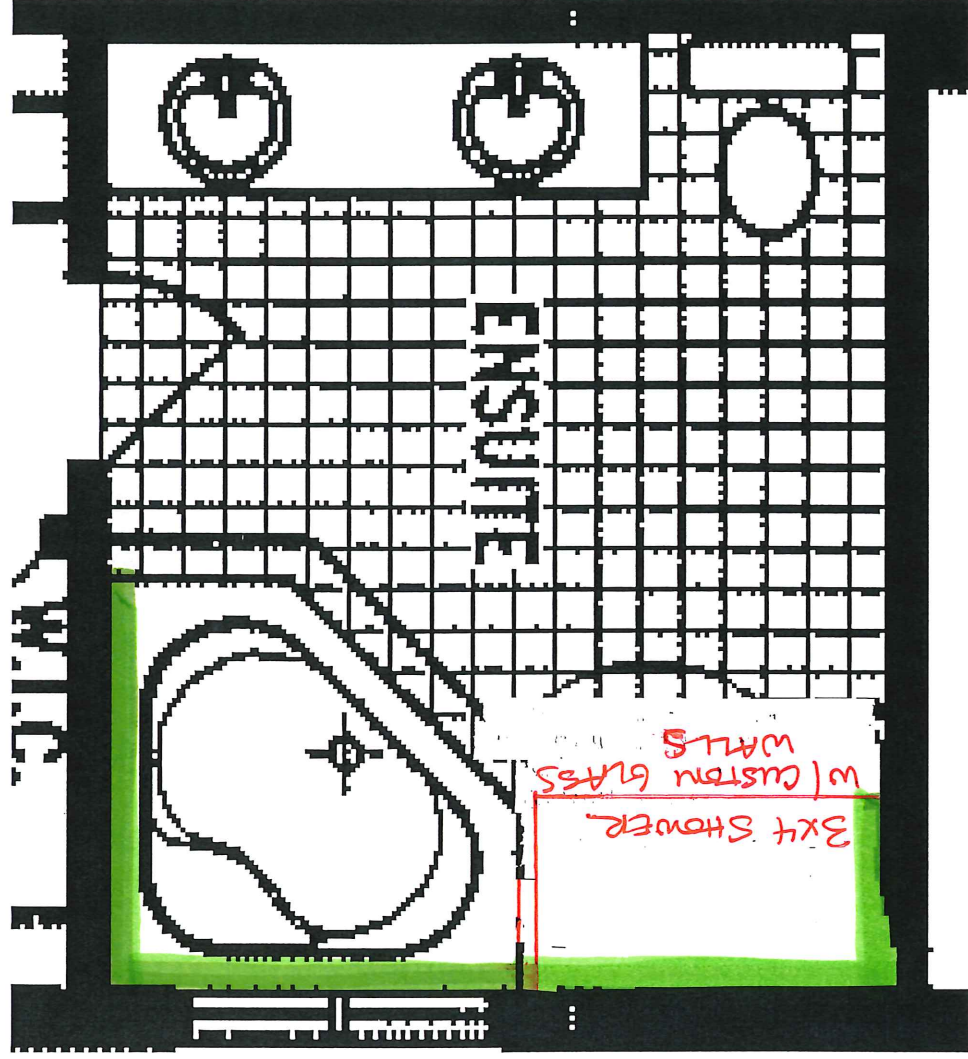

(1) LISTELLO BAND INSTALLED
2/3rd UP WALL

CUSTOM GLASS
WALL.

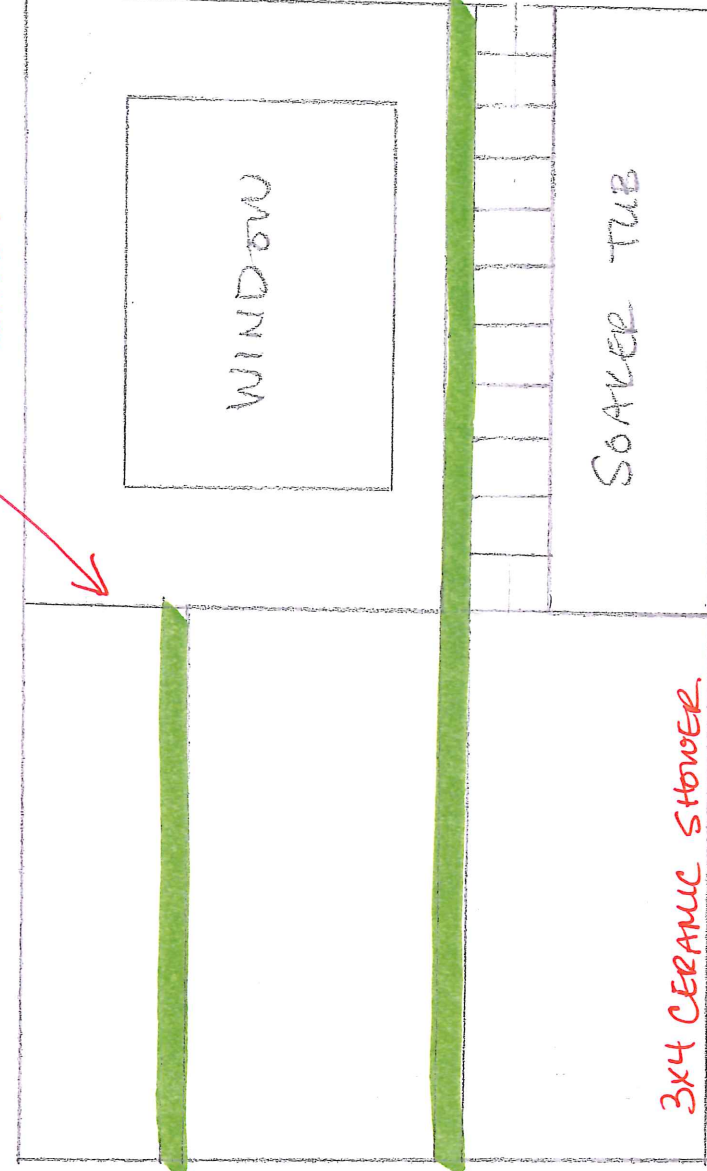

(1) LISTELLO
BAND THAT
STARTS @
TUB AND CONTINUES
INTO SHOWER

3x4 CERAMIC SHOWER