


MR KITCHENS LTD. of #19 HH Re-Design\WAPOLLO\Files\Cabinet Vision\Jobs\Contractors\Phoenix Homes\Drawings\Lot #19 HH Re-Design.cov

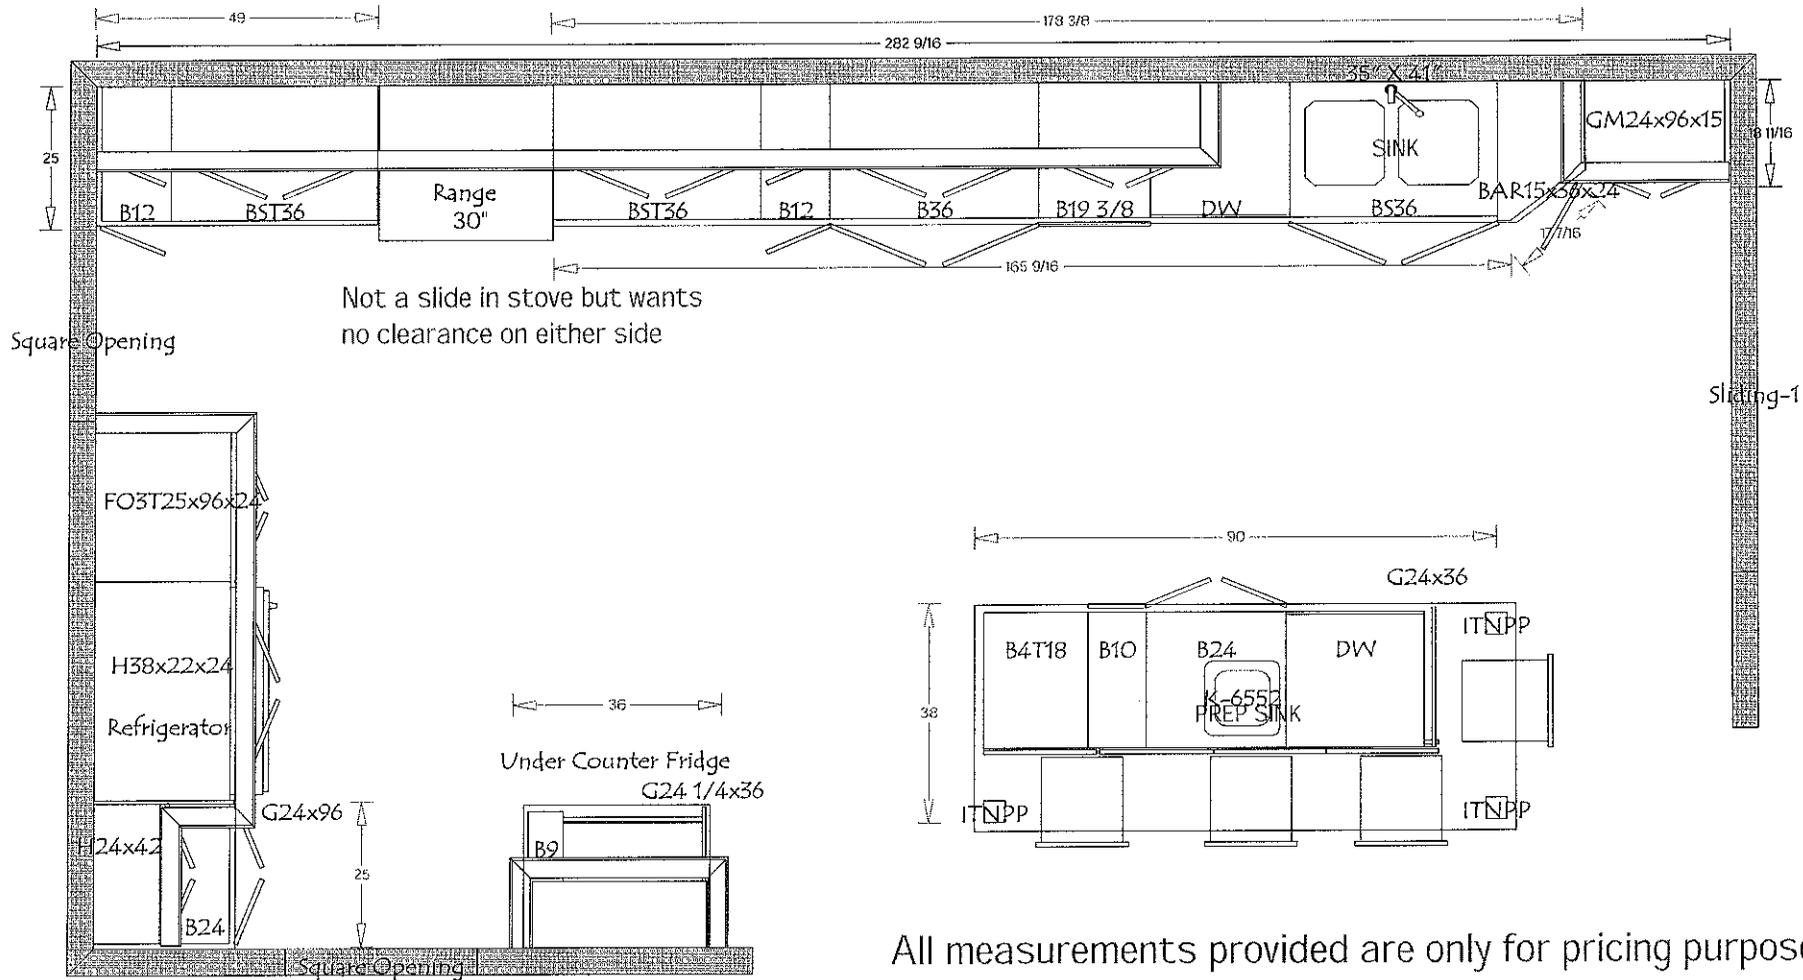

All measurements provided are only for pricing purposes. These measurement are approx. only. No final measurements have been made. MR Kitchens are not responsible for any granite templating or installation.

**MR kitchens**

296 Enterprise, Vars, ON  
K0A 3H0  
T:613.443.3399  
F:613.443.3406

Contractor:

Designer:

Job Number:

Date:  
05/15/12

Notes:  
**Robson 50-1**  
Lot #19 HH  
Re-Design

Scale:  
3/8" = 1'


Page:  
8 of 8

Crown W/12" Bulkhead Filler to Ceiling

42" Uppers

Pot & Pan Drawers

Pull Out Double Garbage

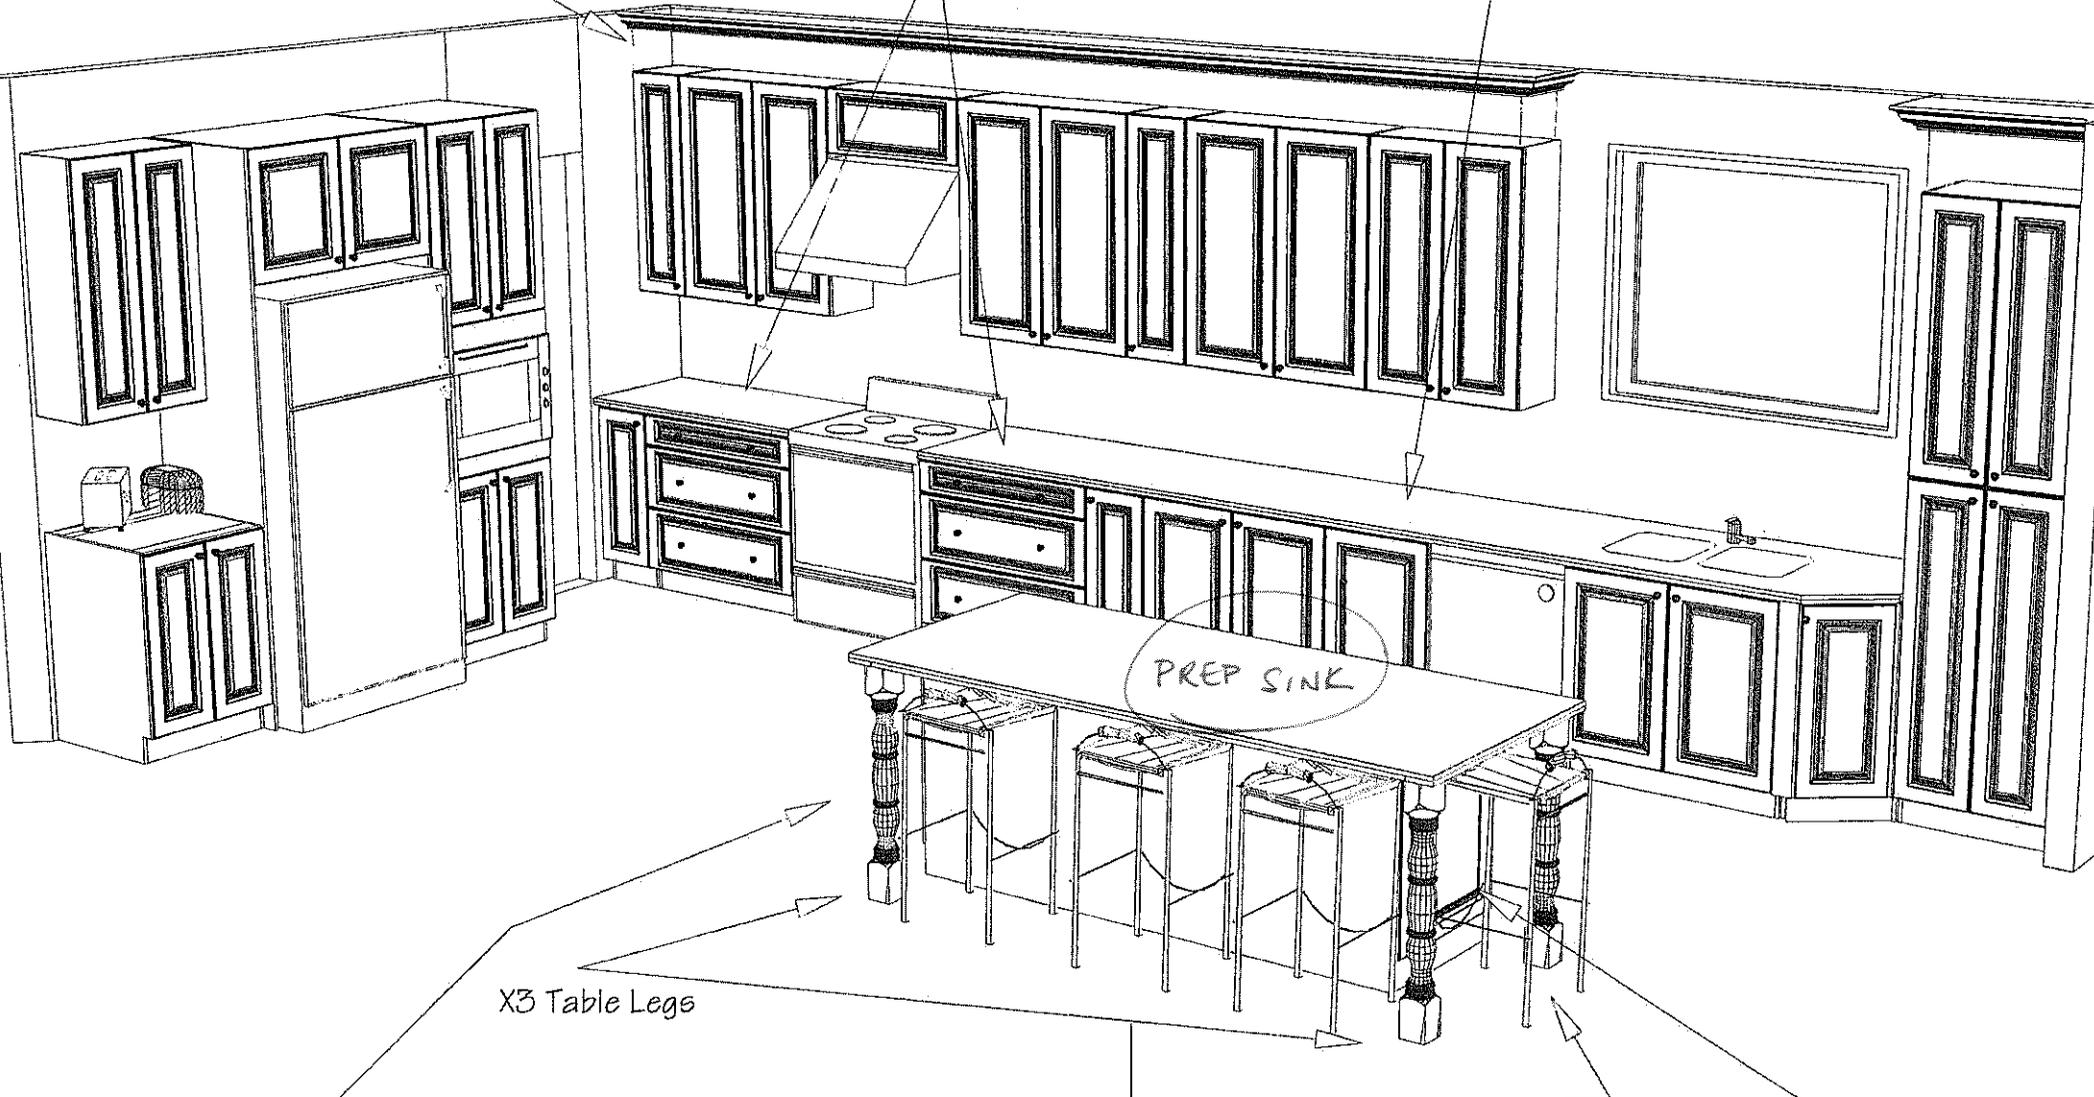

X3 Table Legs

Fake Doors on ends of Island

**MR** kitchēns

296 Enterprise, Vars. ON  
K0A 3H0  
T:613.443.3399  
F:613.443.3406

Contractor:

Designer: Julie

Job Number:

Date:  
06/15/12

Notes:  
  
Robson 50-1

Heritage Hills


Lot #19

Re-Design



Scale: 3/4" = 1'

Page:

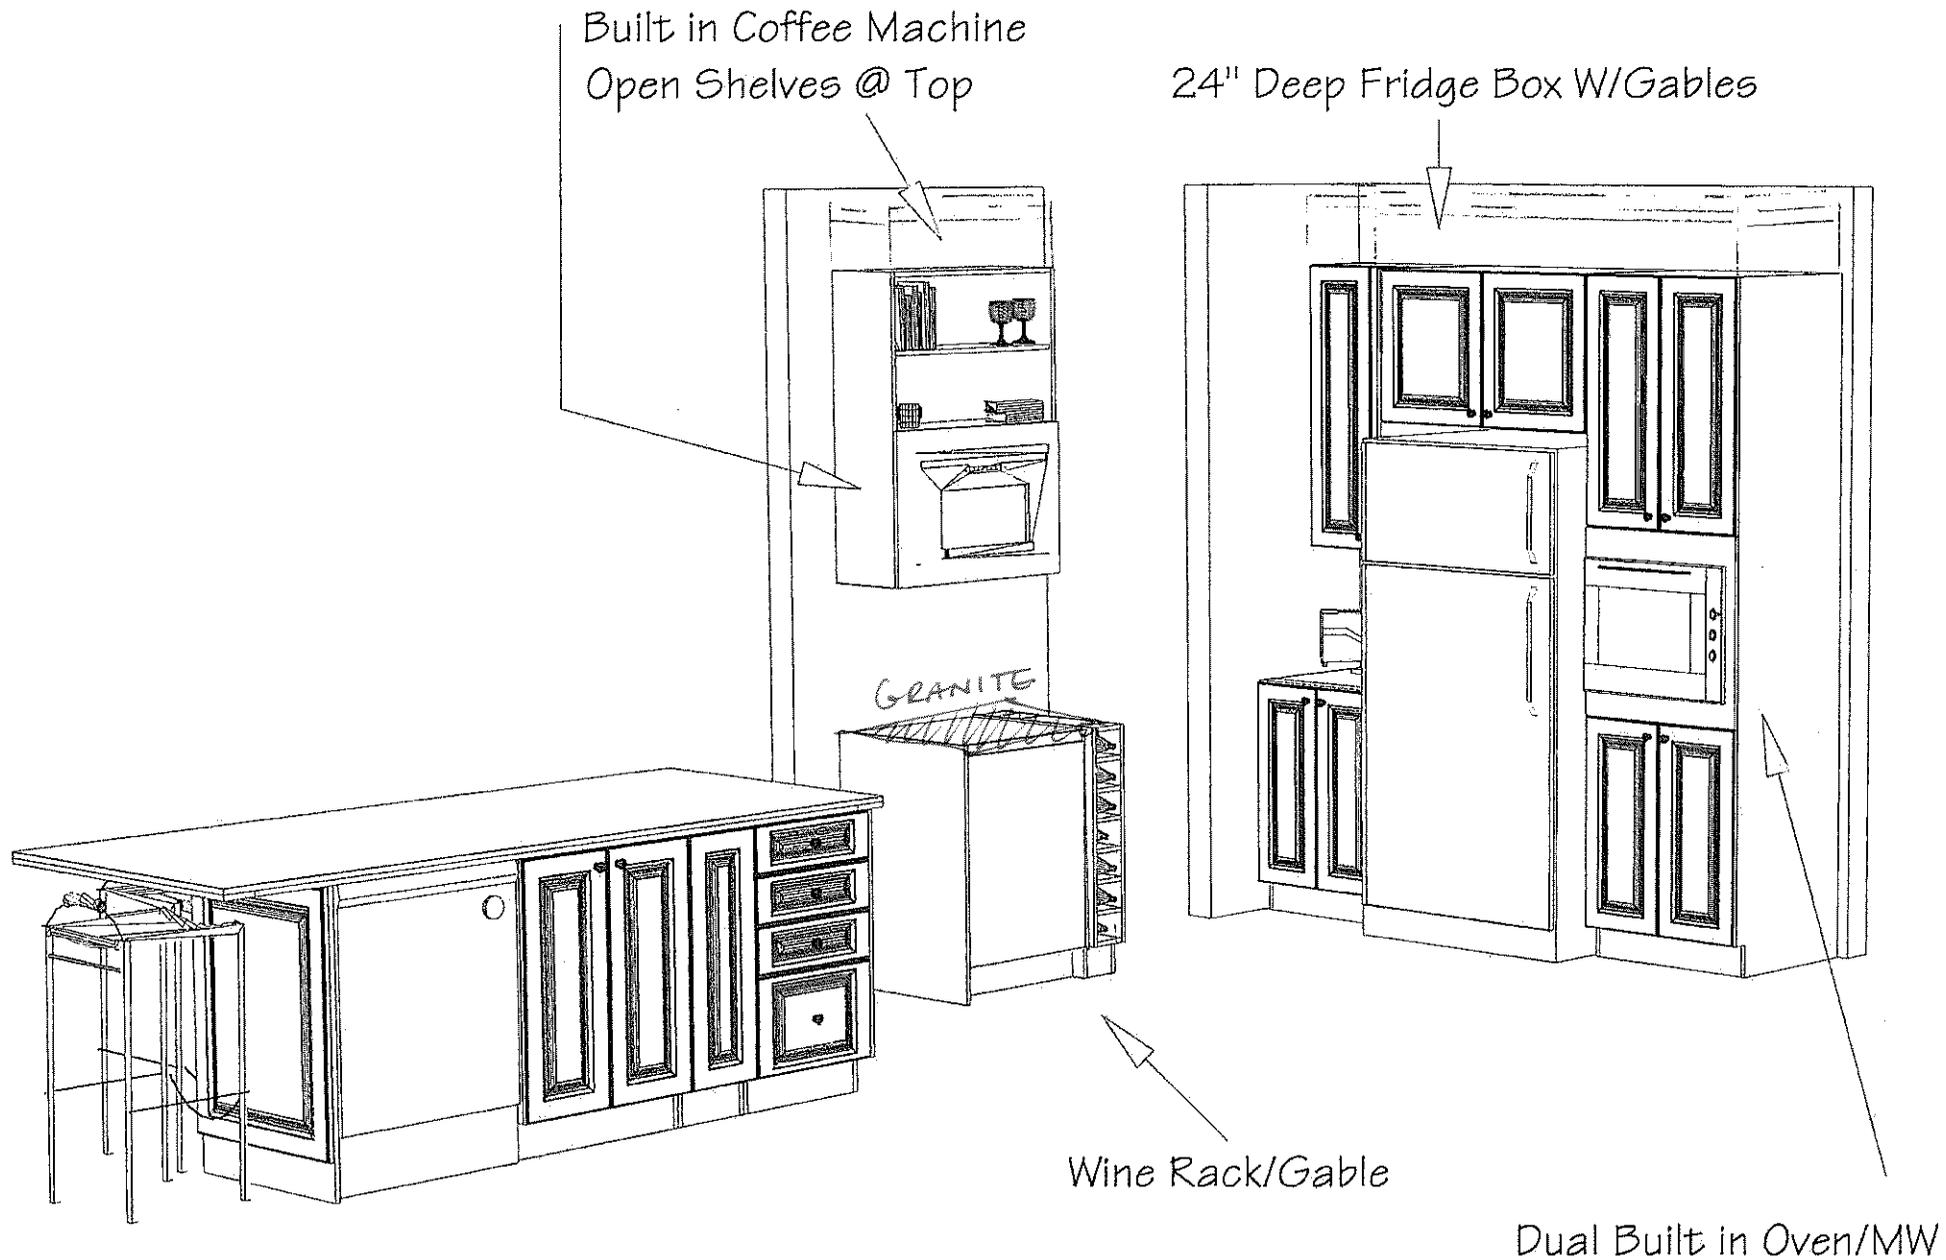

**MR** kitchēns

296 Entreprise, Vars., ON  
K0A 3H0  
T:613.443.3399  
F:613.443.3406

Contractor:

Designer: Julie

Job Number:

Date:  
06/15/12

Notes:

Robson 50-1

Lot #19

Heritage Hills

Re-Design

Scale:

1" = 1'

Page: