



~~Deco Post~~



Double Garbage Pull Out



~~5" Spice Pull Out~~

MR kitchens

296 Entreprise, Vars, ON
K0A 3H0
T:613.443.3399
F:613.443.3406

Contractor:

Phoenix Homes

Designer:

GB

Job Number:

Date:

01/09/13

Notes:

Heritage Hills

Lot #26

Platina



Re-Design

Scale:

Page:

With Soffit and Crown Above Window

No Soffit and Crown Above Window

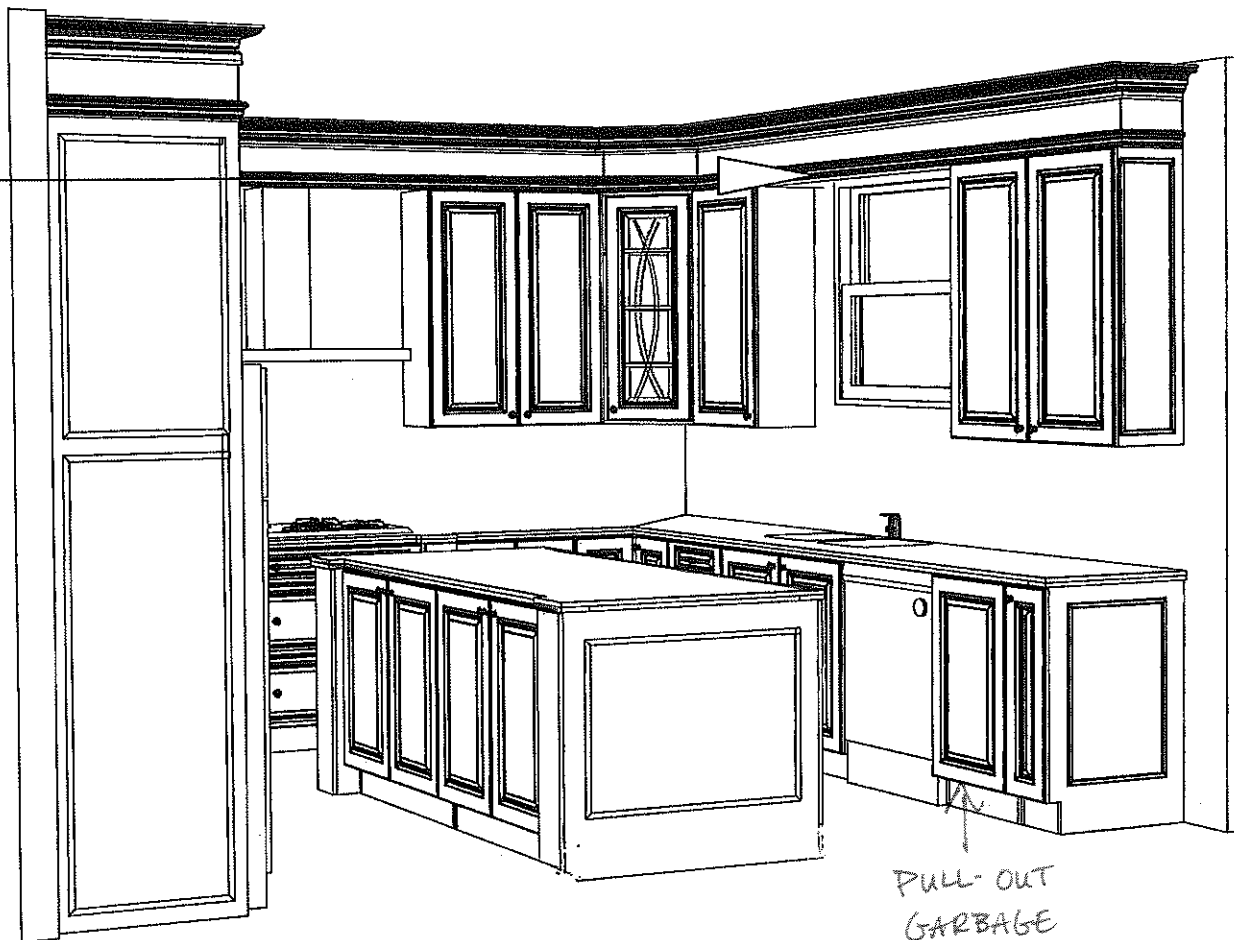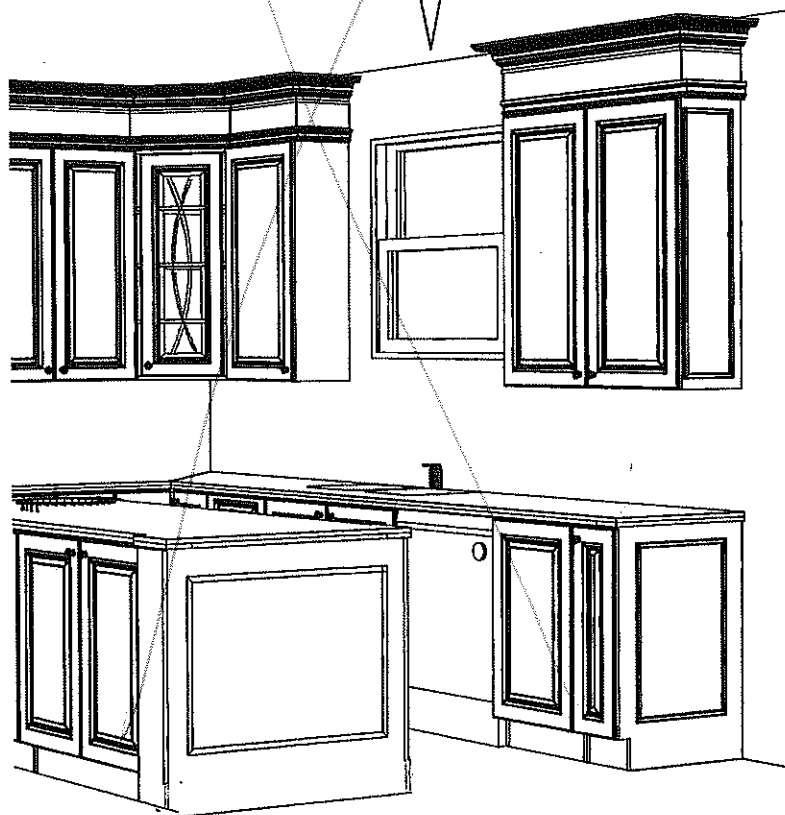

MR kitchens

296 Entreprise, Vars, ON
K0A 3H0
T:613.443.3399
F:613.443.3406

Contractor:

Phoenix Homes

Designer:

Job Number:

Job

Date:

01/28/13

Notes:

Heritage Hills

Lot #26

Platina


Re-Design

Scale:

3/4" = 1'

Page:

22 of 22

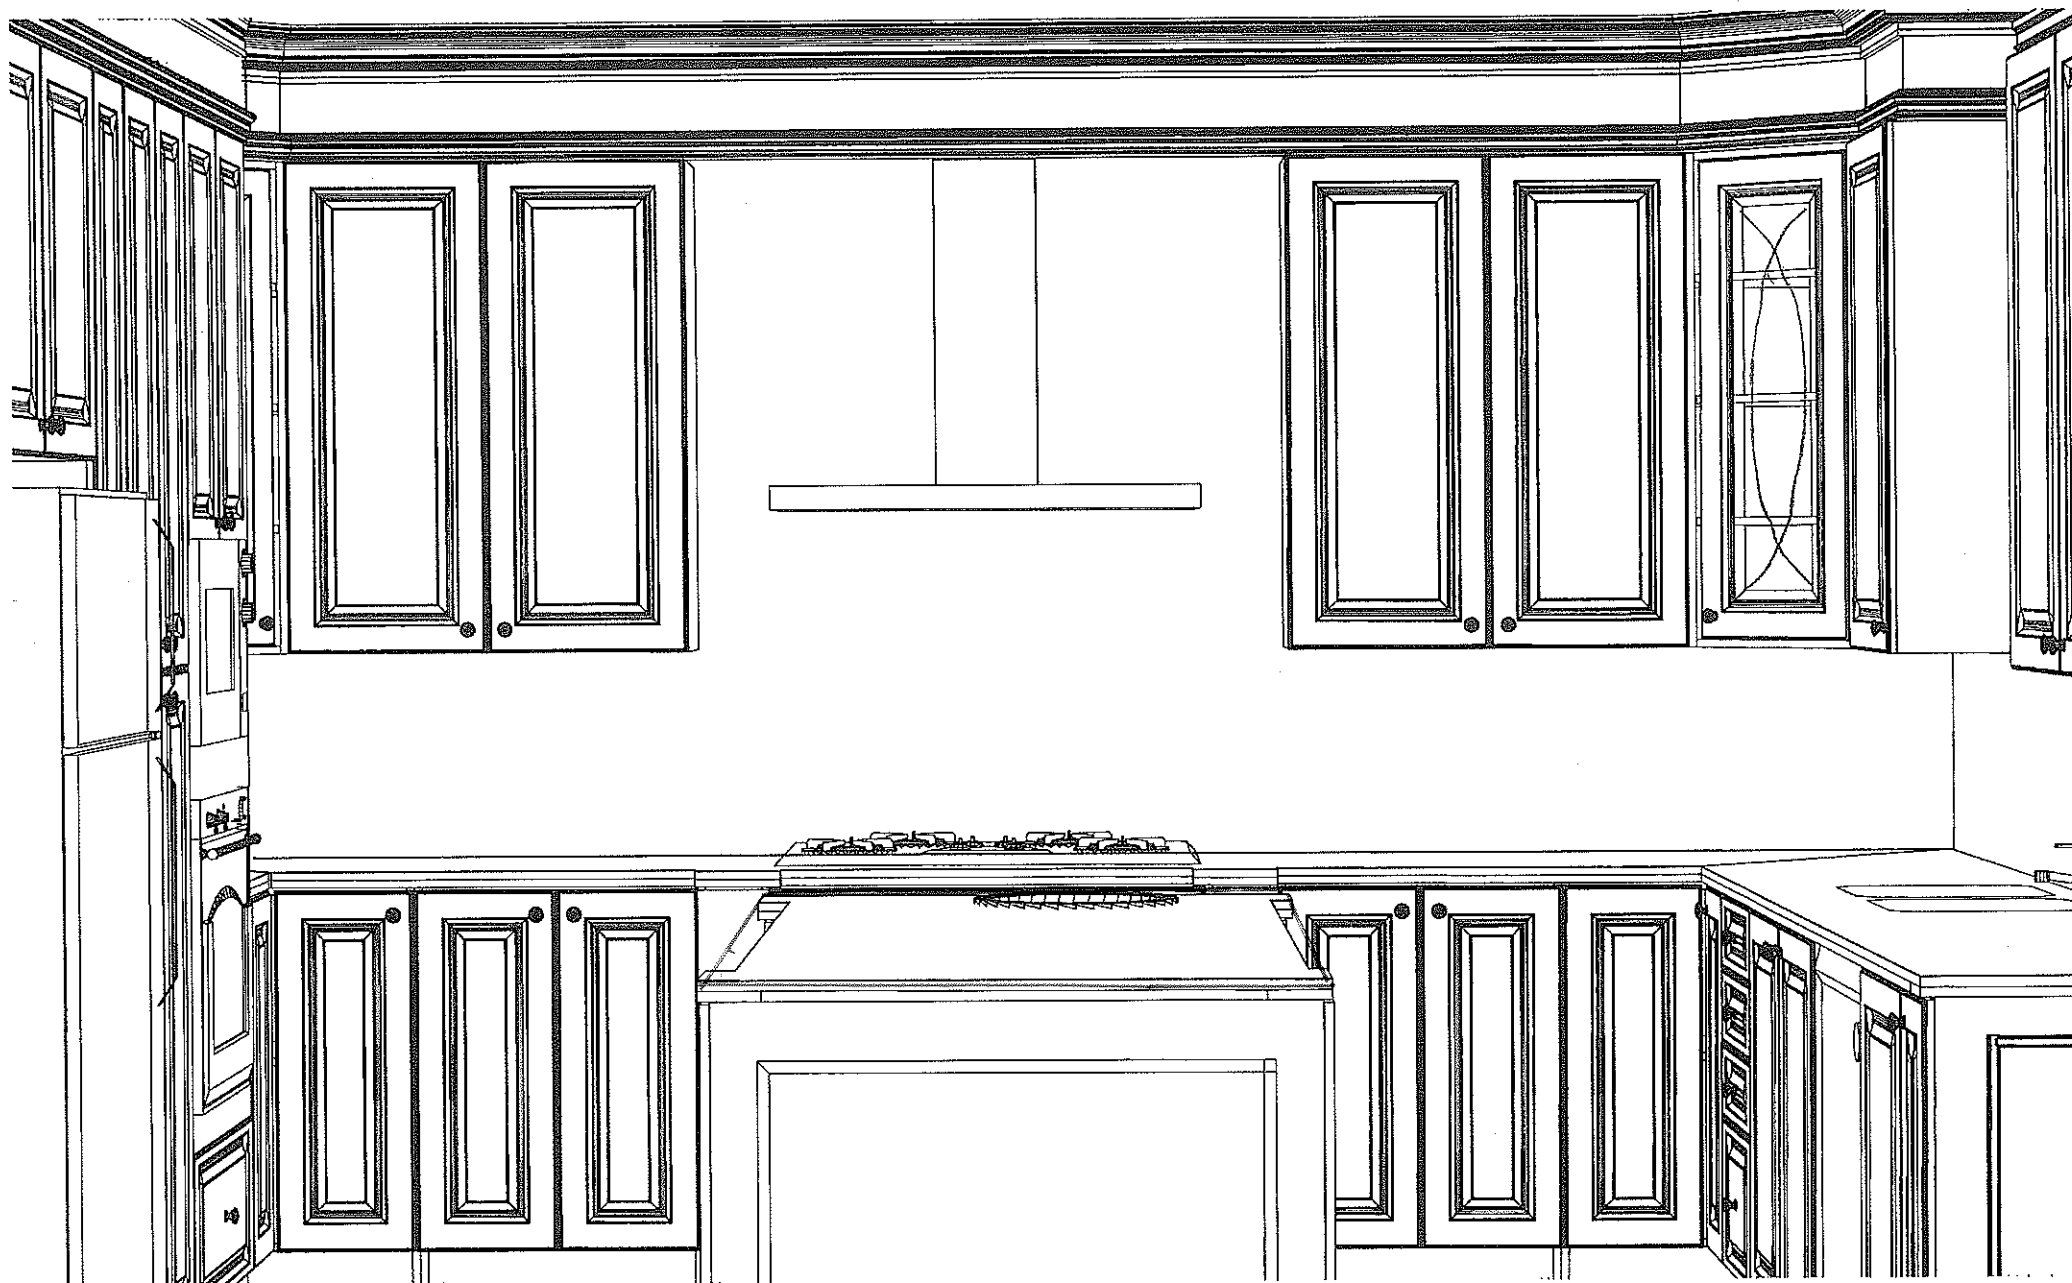

MR kitchens

296 Entreprise, Vars, ON
K0A 3H0
T:613.443.3399
F:613.443.3406

Contractor:

Phoenix Homes

Designer:

GB

Job Number:

Date:

01/11/13

Notes:

Heritage Hills

Lot #26


Platina
Re-Design

Scale:

1 1/2" = 1'

Page:

19 of 20

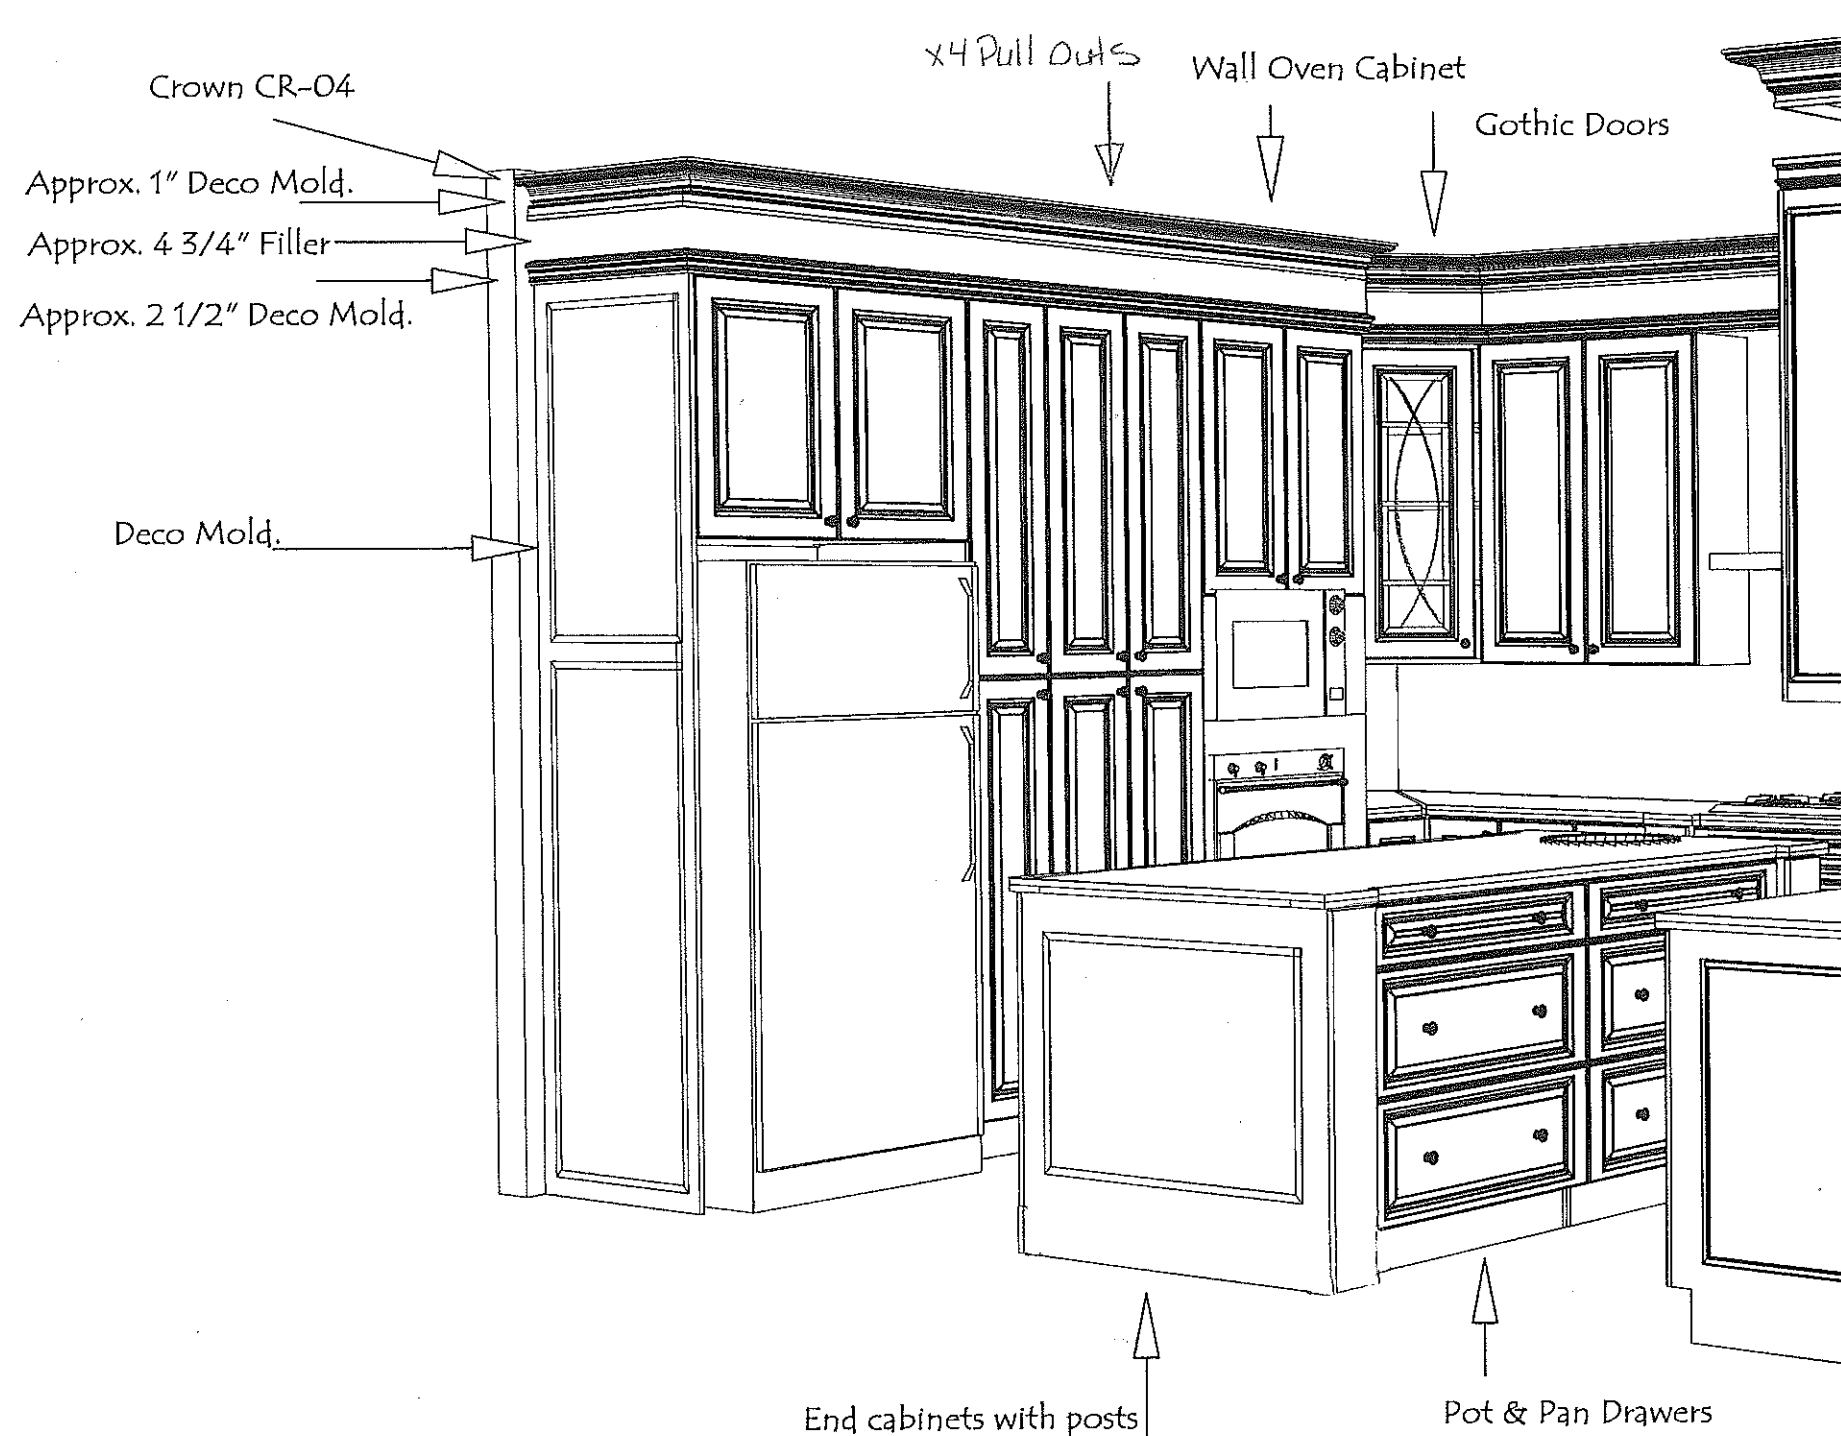

MR kitchenēns

296 Entrepise, Vars, ON
K0A 3H0
T:613.443.3399
F:613.443.3406

Contractor:

Phoenix Homes

Designer:

GB

Job Number:

Date:

01/11/13

Notes:

Heritage Hills

Lot #26

Platina

Re-Design

Scale:

1" = 1'

Page:

18 of 20