




		Contractor: Phoenix Homes	Designer: GB	Job Number:	Date: 12/16/08	Notes:	Page: 4 of 7
--	--	------------------------------	-----------------	-------------	-------------------	--------	-----------------

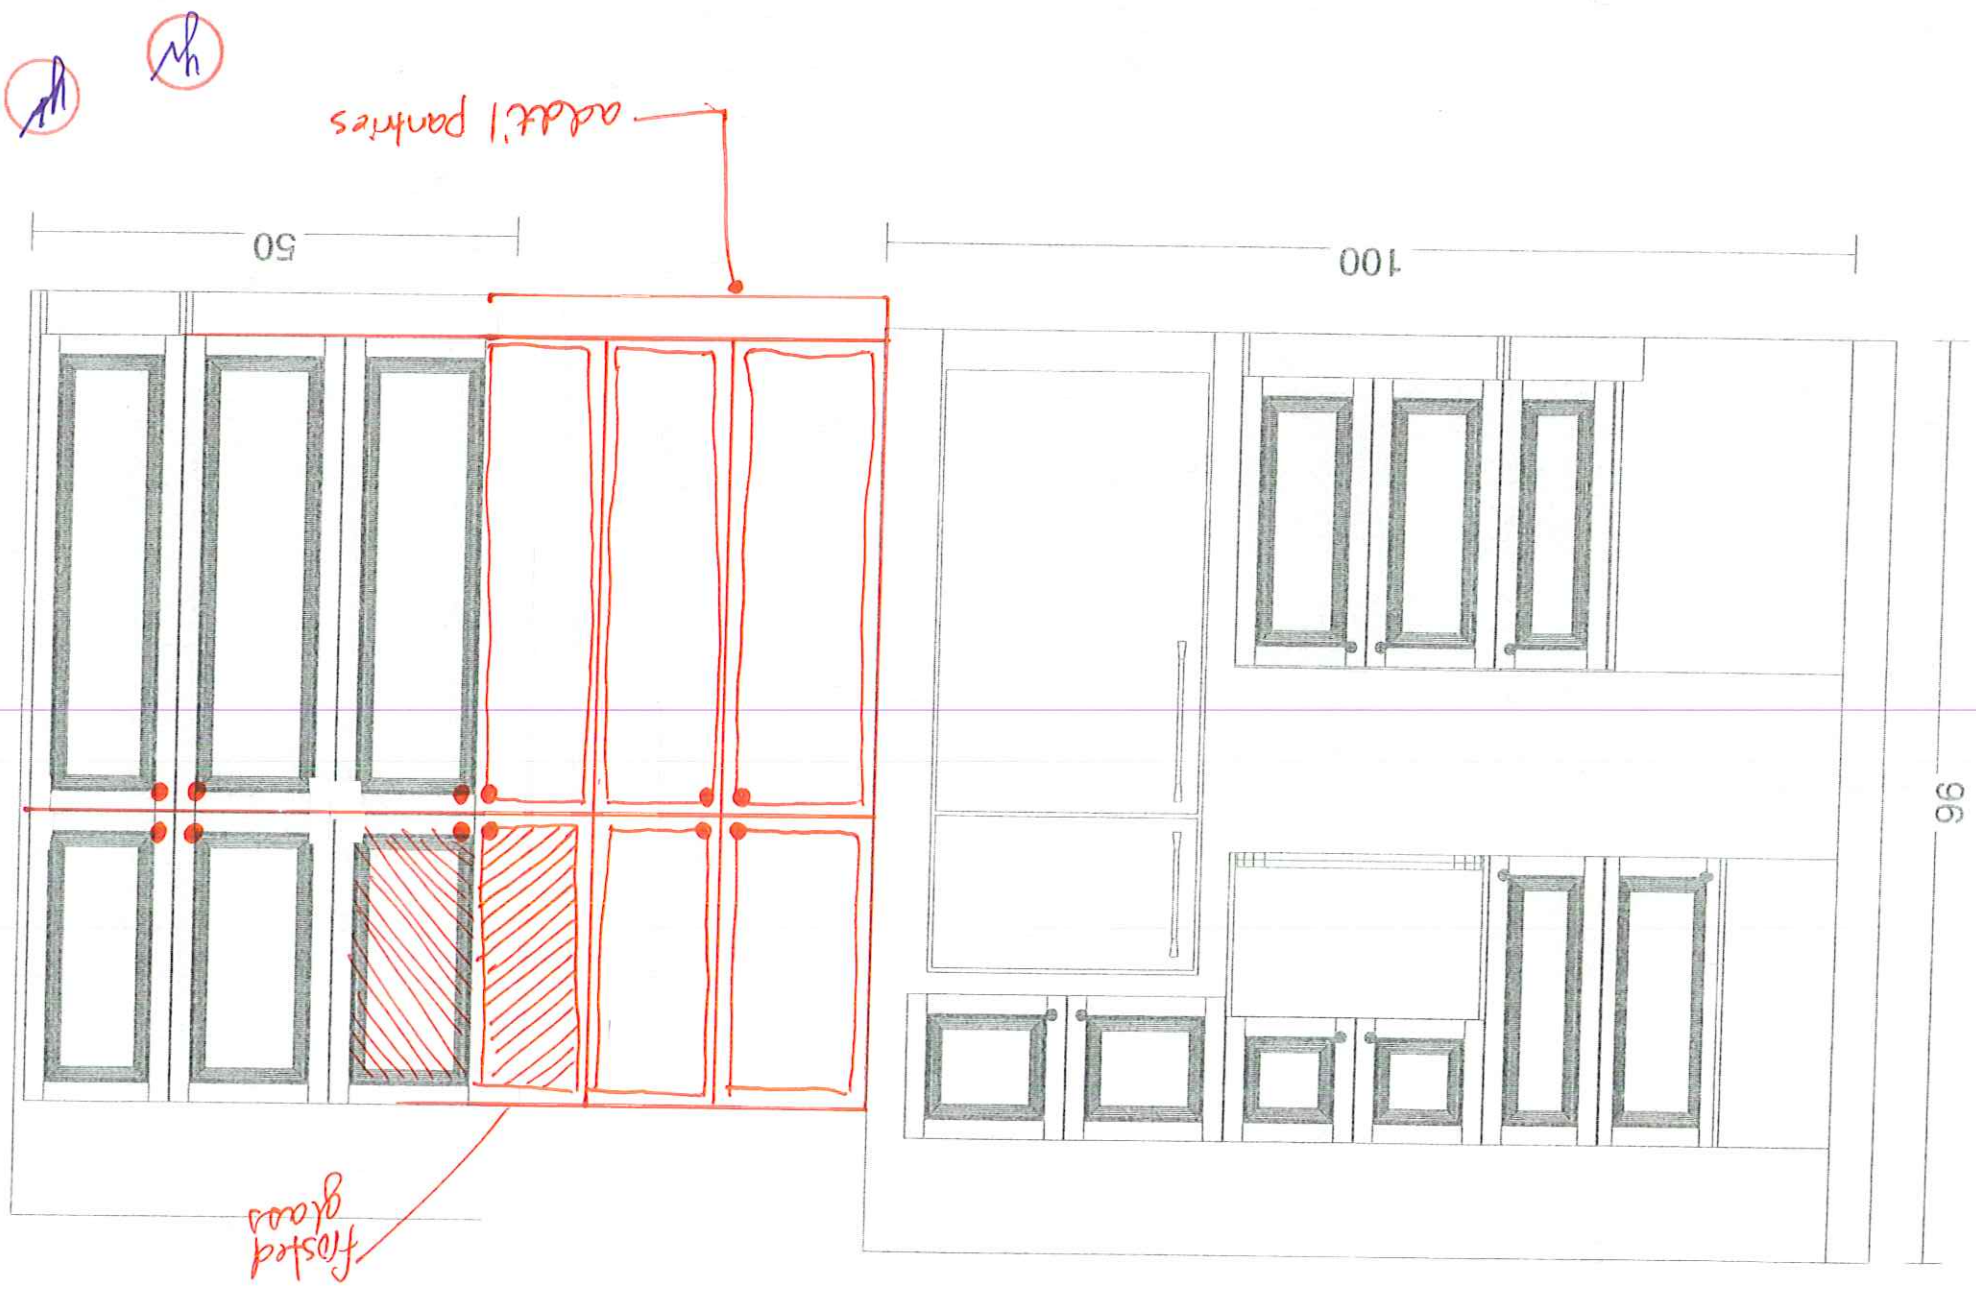