

**CABINET SERIES:**  
**STYLE & COLOUR:**


**HW:**

## STD WHITE INTERIORS

## METAL DRAWER BOXES

2 - PCS. 90 DEG. CORNER MOULD.

1 PC - T MOULD

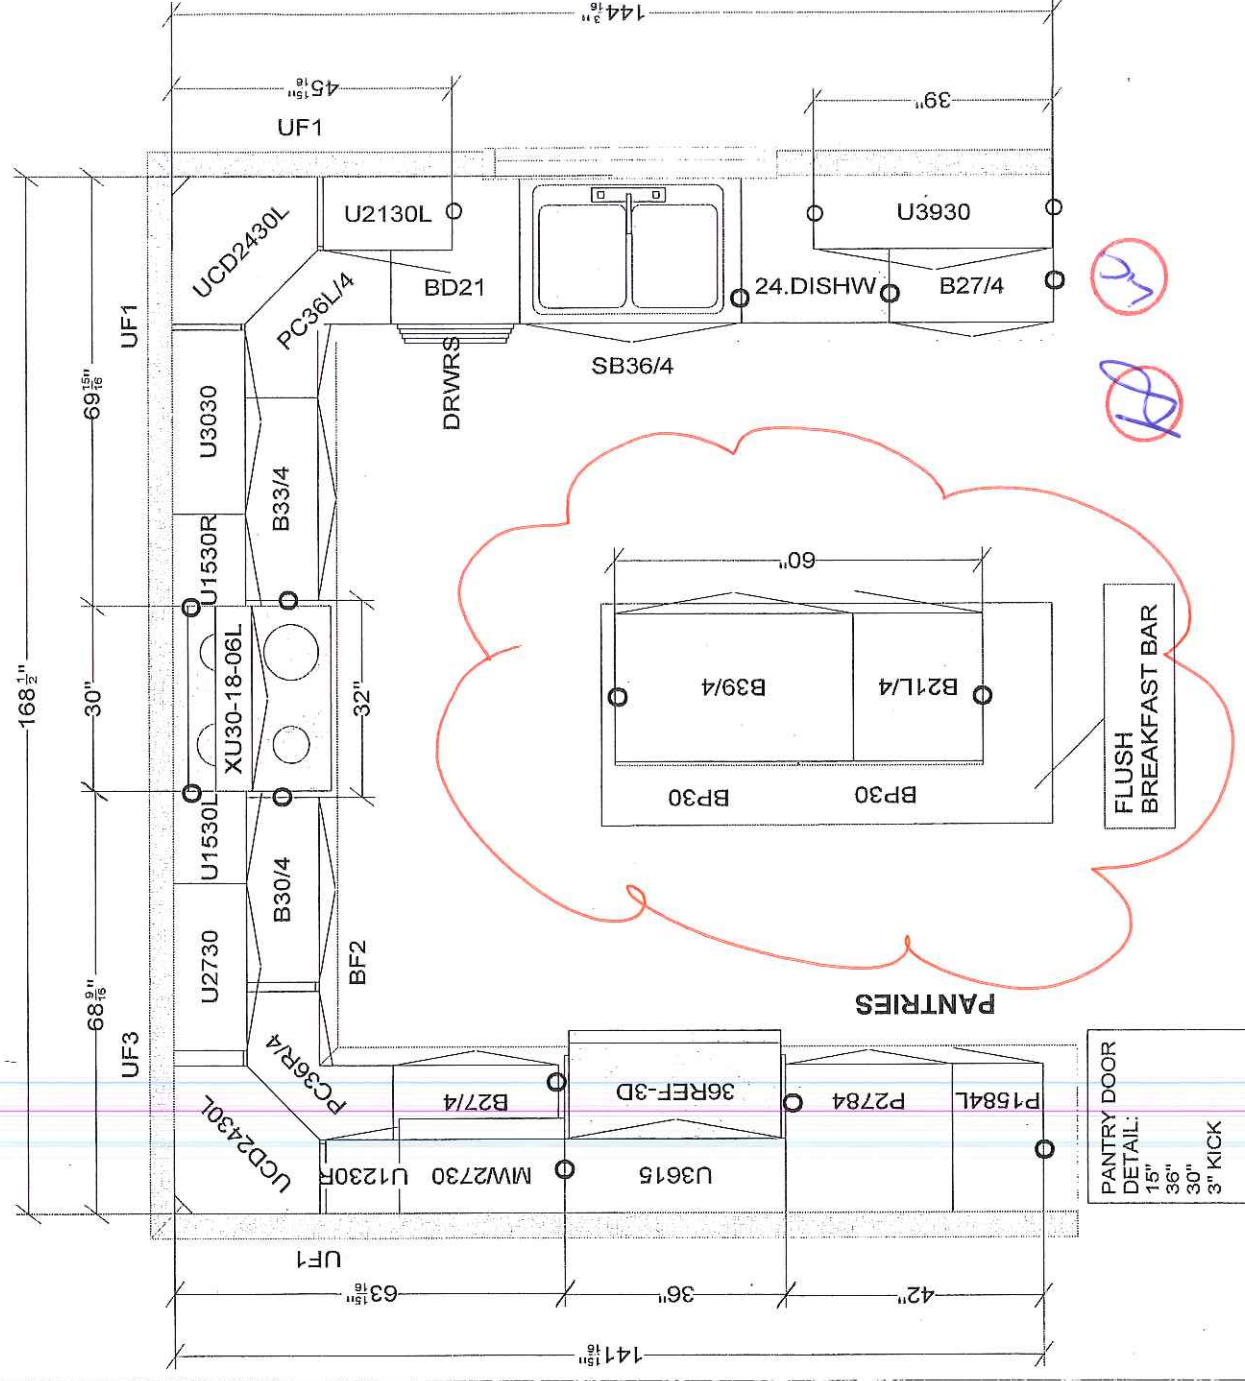

This is an original design and must not be released or copied unless applicable fee has been paid or job order placed.

Designed: 11/30/2008  
Printed: 3/9/2009

DCR PHOENIX - PLATINA(512) KITCHEN

All

Drawing #: 1