

DCR PHOENIX HOMES

FERNBANK CROSSING
LOT #78

BRADFORD (35-4)

ALT. 4 BDRM VANITIES

REV. SEPT.3/13


LINE -

HARDWARE -


STD WHITE INTERIORS

METAL DRWR BOX


5/8" KICK

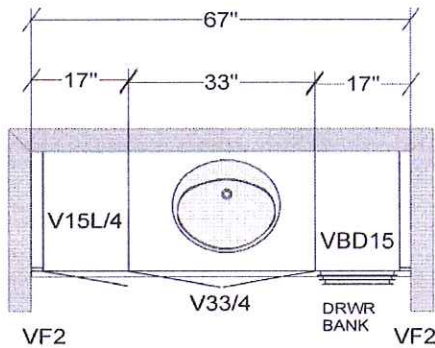

SHARED BATH

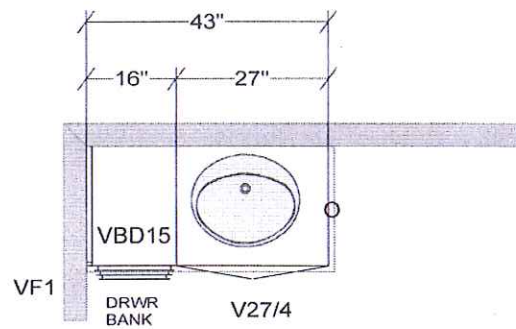

MAIN BATH

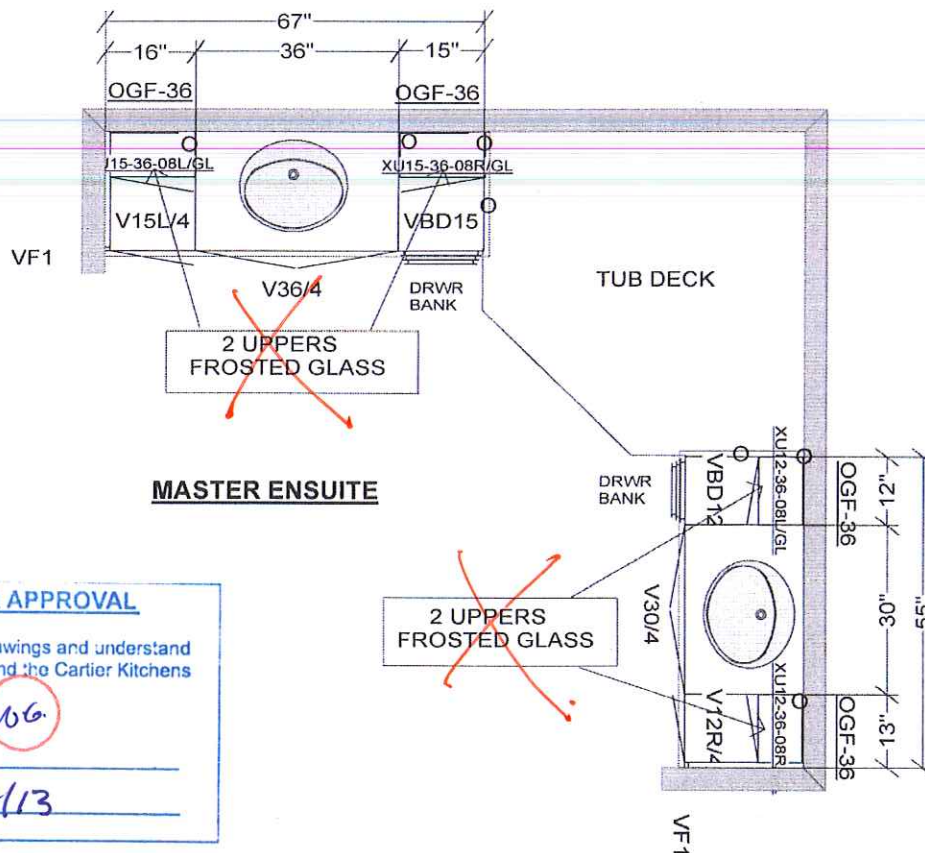

MASTER ENSUITE

CUSTOMER APPROVAL

I have reviewed these drawings and understand the details of the layout and the Cartier Kitchens specifications.

Signature

Date

Oct. 17/13

All dimensions, size designations given are subject to verification on job site and adjustment to fit job conditions.

Cartier Kitchens Ottawa



This is an original design and must not be released or copied unless applicable fee has been paid or job order placed.


Drawn by: Lori Di Saverio, B.I.D.
Cartier Kitchens Ottawa

Designed: 05/09/2013
Printed: 05/09/2013

DCR - #78 FBC - BRADFORD(35-4) - ALT. 4 BDRM VANITIES.kit

All

Drawing #: 1 No Scale.

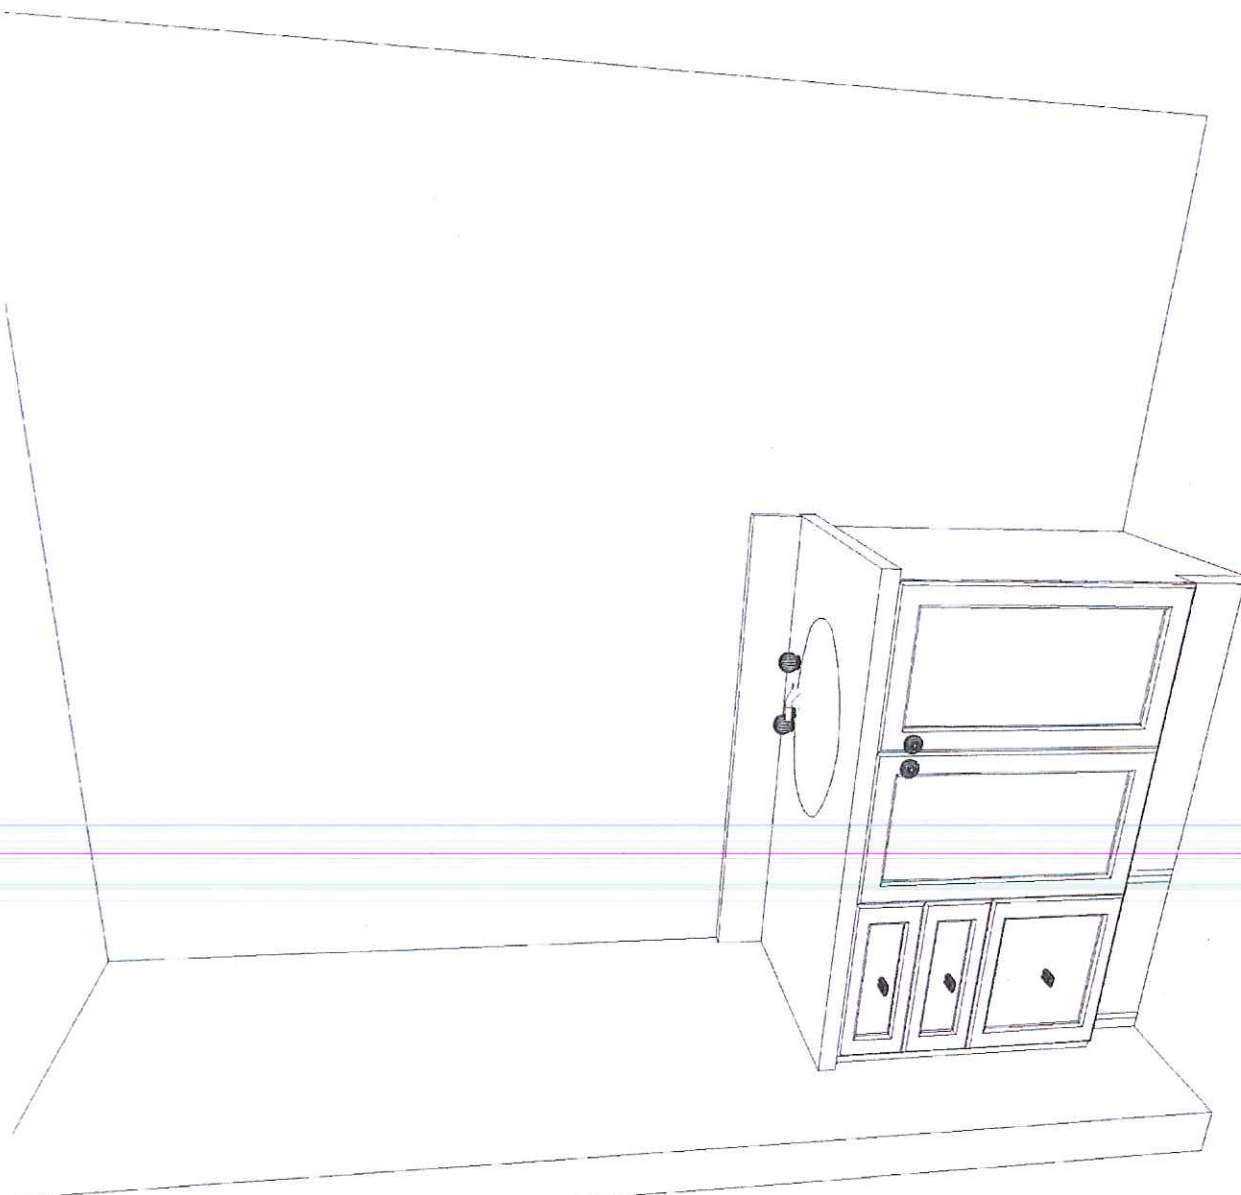

MAIN BATH VANITY

CUSTOMER APPROVAL

I have reviewed these drawings and understand the details of the layout and the Cartier Kitchens specifications.

RG v.s.

Signature _____

Date Oct. 17/13




Designed: 05/09/2013
Printed: 05/09/2013

Note: This drawing is an artistic interpretation of the general appearance of the design. It is not meant to be an exact rendition.

Drawn By: Lori D Saverio, B.I.D.
Cartier Kitchens Ottawa

DCR - #78 FBC - BRADFORD(35-4) - ALT. 4 BDRM All

Drawing #: 1

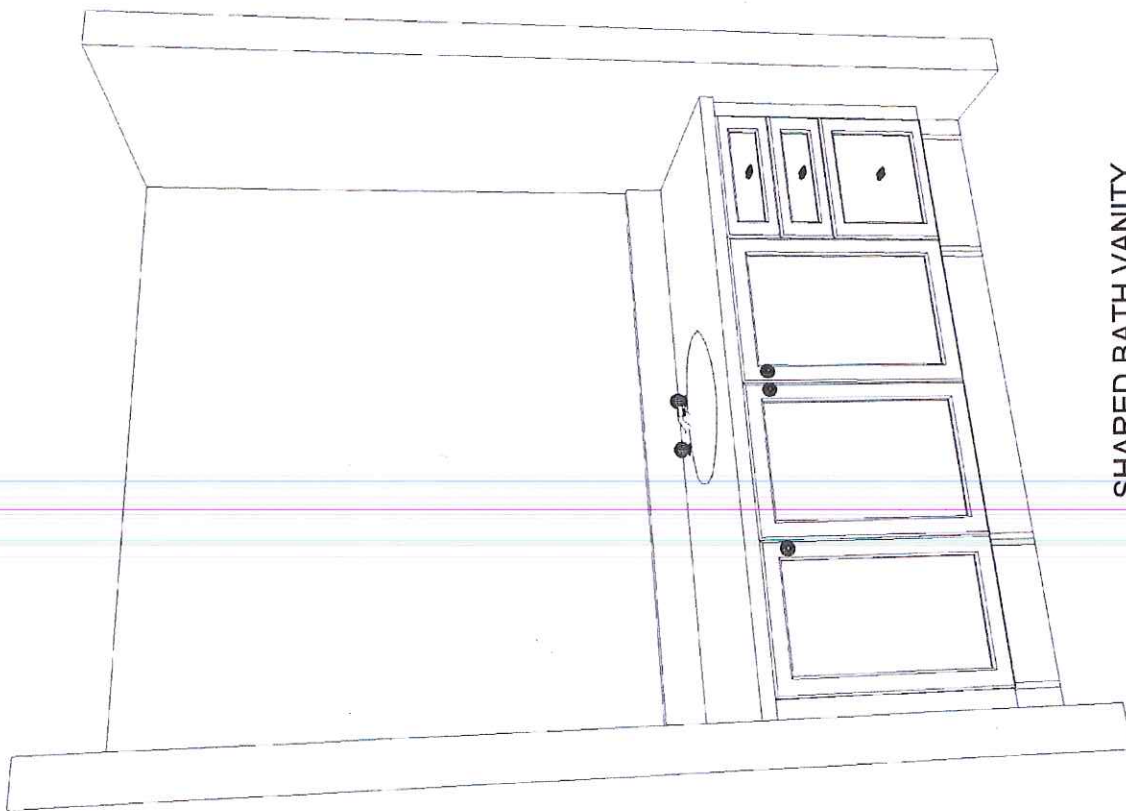

SHARED BATH VANITY

CUSTOMER APPROVAL

I have reviewed these drawings and understand the details of the layout and the Cartier Kitchens specifications.

RG-bb

Signature

Date

Oct. 17 /13

Note: This drawing is an artistic interpretation of the general appearance of the design. It is not meant to be an exact rendition.


Drawn By: Lori D Saverio, B.I.D.
Cartier Kitchens Ottawa



Designed: 05/09/2013
Printed: 05/09/2013

DCR - #78 FBC - BRADFORD(35-4) - ALT. 4 BDRM All

Drawing #: 1

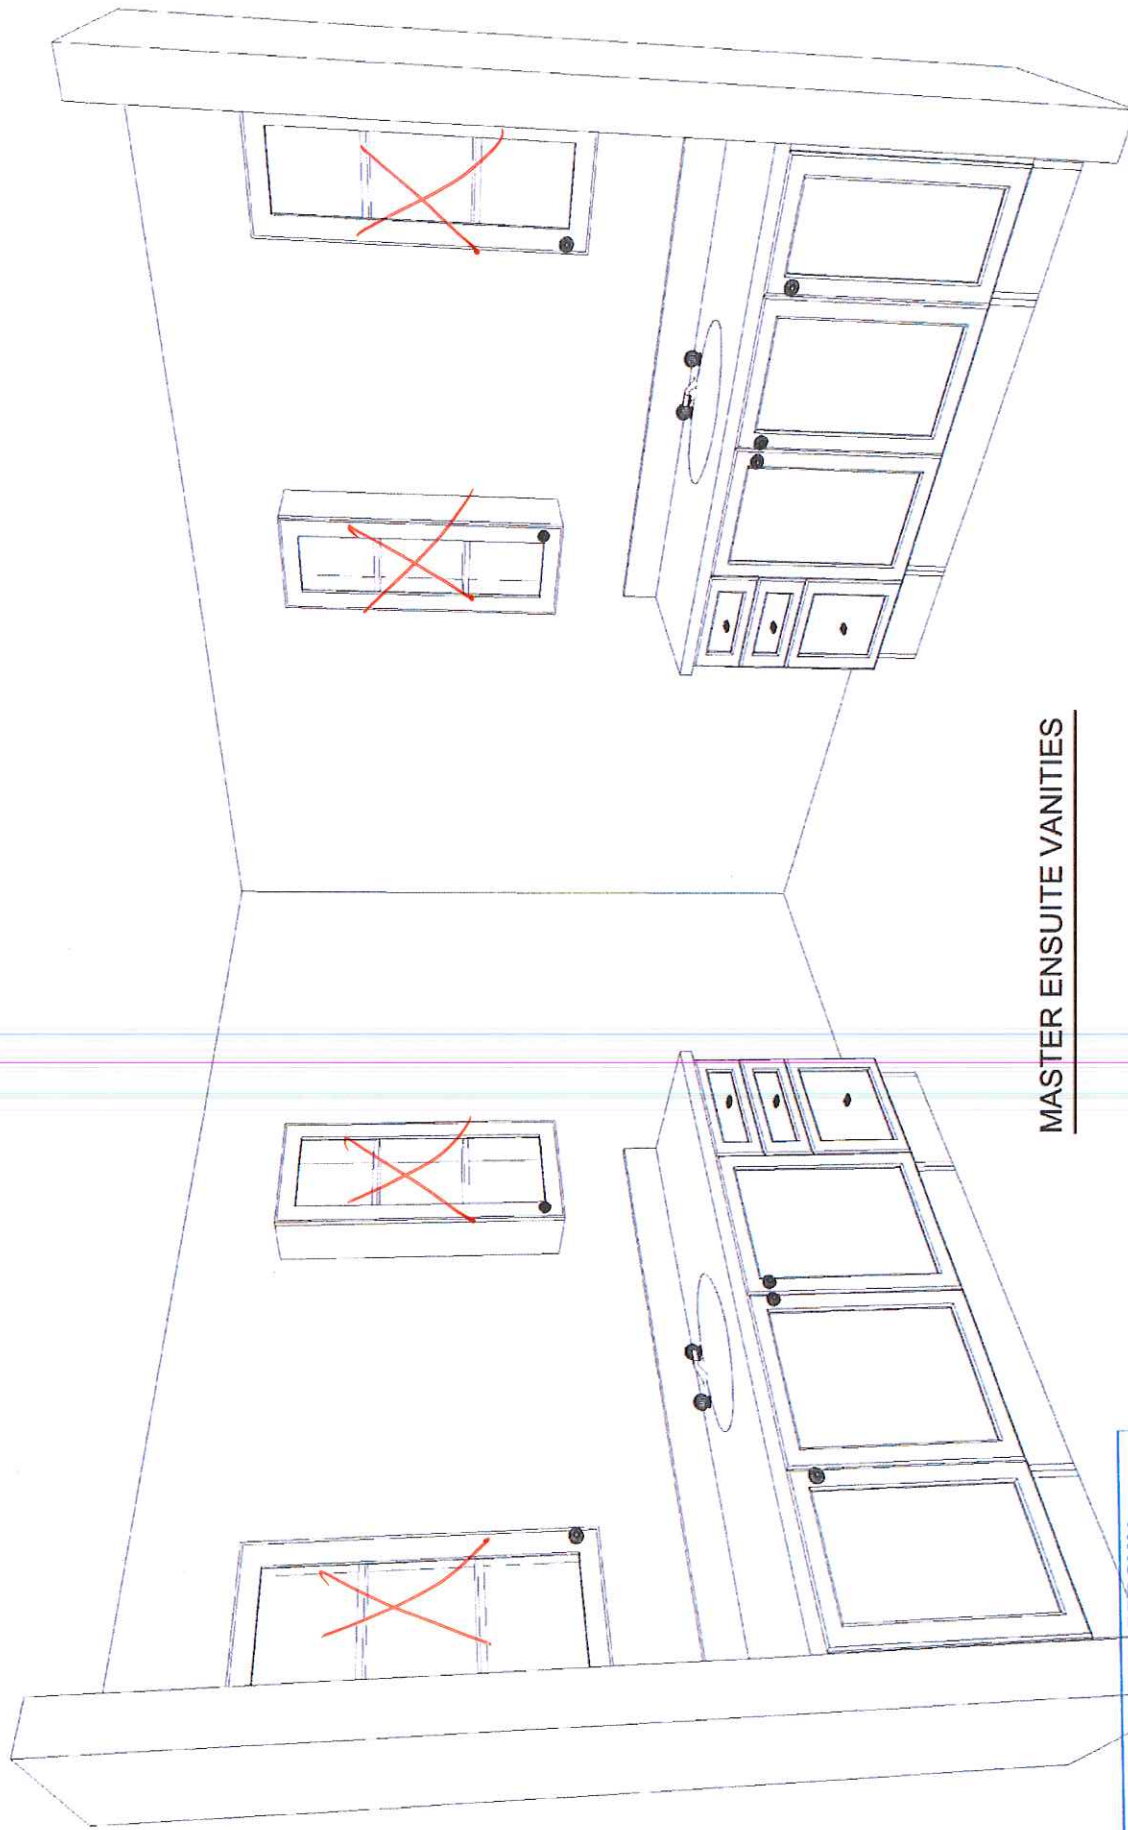

MASTER ENSUITE VANITIES

CUSTOMER APPROVAL

I have reviewed these drawings and understand the details of the layout and the Cartier Kitchens specifications.

RG 10.6.

Signature _____

Date Oct. 17/13

Note: This drawing is an artistic interpretation of the general appearance of the design. It is not meant to be an exact rendition.

Drawn By: Lori D Saverio, B.I.D.
Cartier Kitchens Ottawa

DCR - #78 FBC - BRADFORD(35-4) - ALT. 4 BDRM All

Drawing #: 1

2020
TECHNOLOGIES

Designed: 05/09/2013
Printed: 05/09/2013