

DCR PHOENIX HOMES

STRANDHERD MEADOWS 5

LOT #12


LAUNDRY ROOM

CUSTOMER APPROVAL


I have reviewed these drawings and understand the details of the layout and the Cartier Kitchens specifications.

Signature [Signature]

Date May 18/12

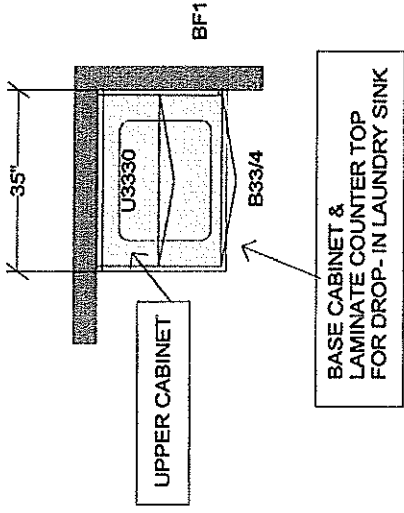

BASEMENT ~ FRIDGE/FREEZER ROOM ~

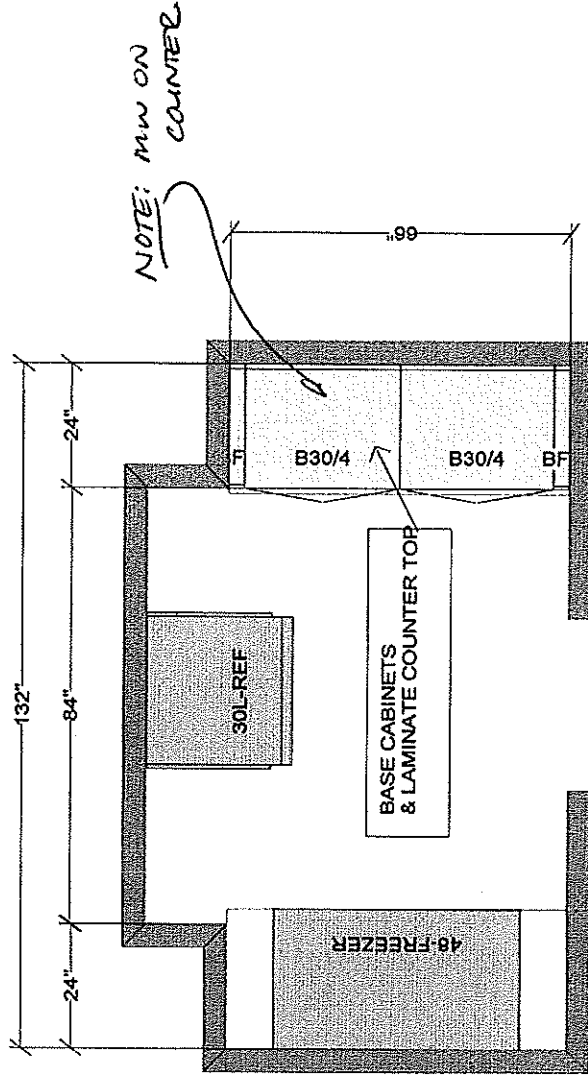

All dimensions, size designations given are subject to verification on job site and adjustment to fit job conditions.

CARTIER KITCHENS OTTAWA

DCR #12 SM5 - LAUNDRY RM. BSMT



2020
TECHNOLOGIES

This is an original design and must not be released or copied unless applicable fee has been paid or job order placed.

DRAWN BY: LD
CARTIER KITCHENS OTTAWA

Designed: 4/18/2012
Printed: 4/18/2012

All


Drawing #: 1 | No Scale.

CUSTOMER APPROVAL

I have reviewed these drawings and understand the details of the layout and the Carter Kitchens specifications.

Signature: *[Signature]*

Date: May 18/12

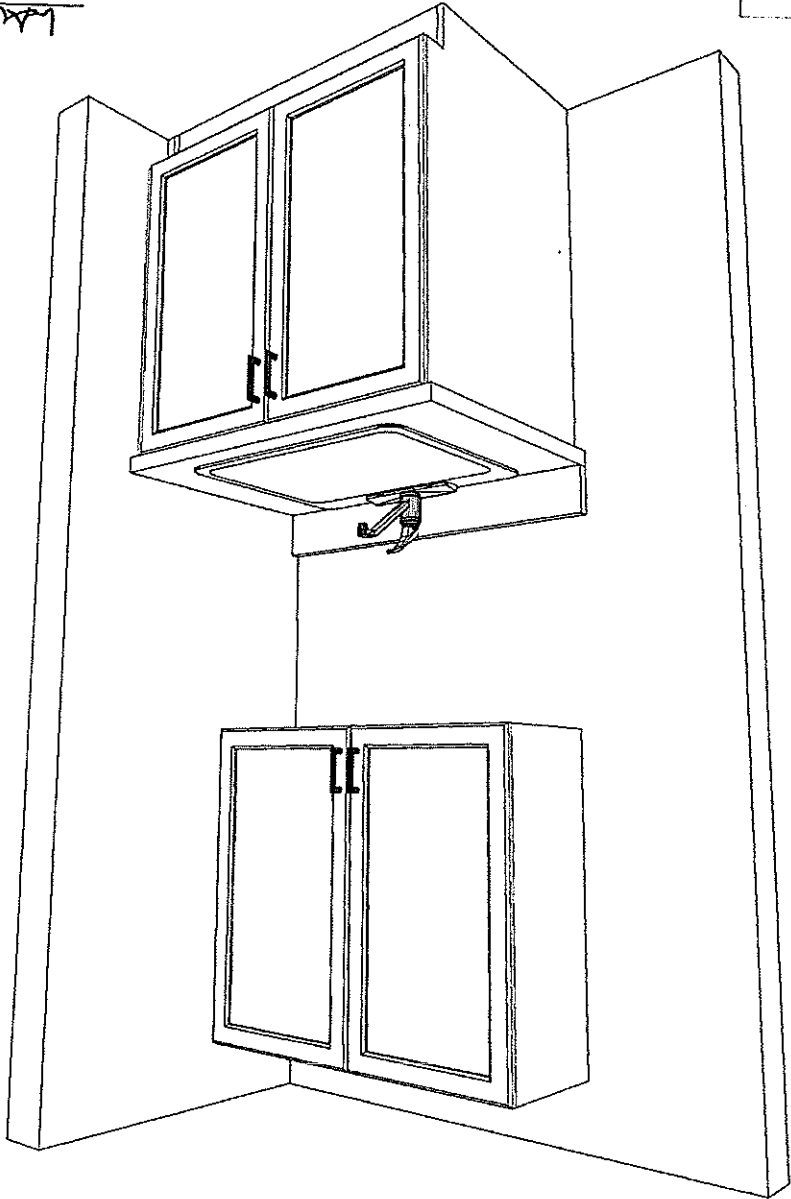

Laundry Room

DCR #12 SMS - LAUNDRY RM BSMT		DESIGNED BY: LORI DISAVERIO	
All		Note: This drawing is an artistic interpretation of the general appearance of the design. It is not meant to be an exact rendition.	
2020 TECHNOLOGIES		Printed: 4/18/2012 Designed: 4/18/2012	
Drawing #: 1			

DCR #12 SMS - LAUNDRY RM BSMT		DESIGNED BY: LORI DISAVERIO,	
All		Note: This drawing is an artistic interpretation of the general appearance of the design. It is not meant to be an exact rendition.	
2020 TECHNOLOGIES			
Designed: 4/18/2012		Printed: 4/18/2012	
Drawing #: 1			

CUSTOMER APPROVAL

I have reviewed these drawings and understand the details of the layout and the Carter Kitchens specifications.

Signature: *[Signature]*

Date: *May 18/12*

