

DCR PHOENIX HOMES

CHESAPEAKE (508)

ALT 4 BDRM

CUSTOM

VANITIES

LINE -
DOOR STYLE -
SPECIES -
COLOUR -

HW:

STD WHITE INTERIORS
METAL DRAWER BOXES
4 PCS - KICK


LOT #12
STRANDHERD MEADOWS 5

CUSTOMER APPROVAL


I have reviewed these drawings and understand the details of the layout and the Cartier Kitchens specifications.

Signature *R. R. L. L.*


Date *May 18/12*

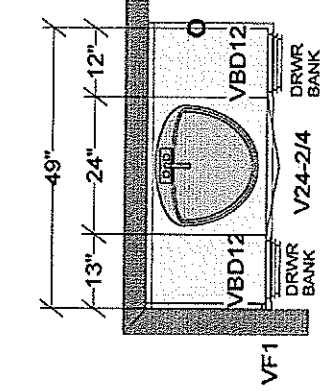


BDRM 2 ENSUITE

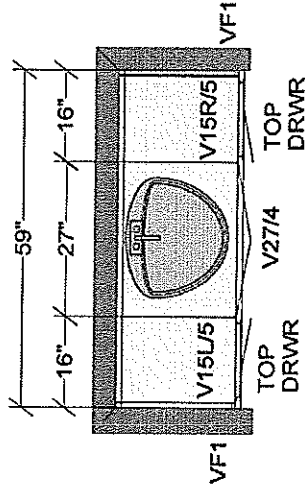

BDRM 3 & 4 ENSUITE

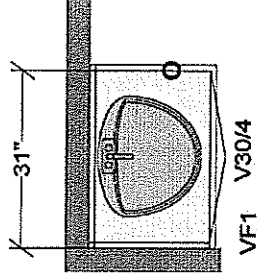

POWDER

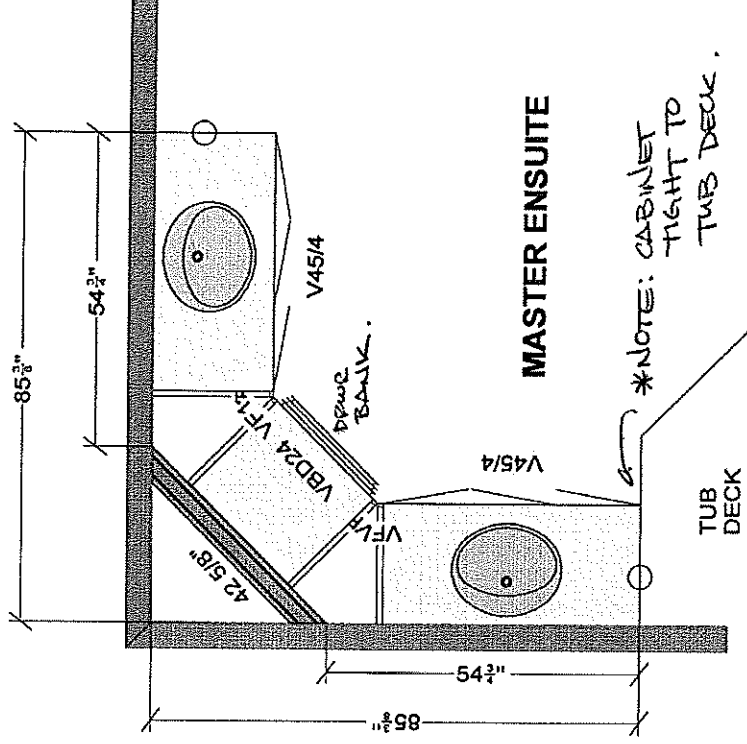

MASTER ENSUITE

*NOTE: CABINET TIGHT TO TUB DECK.

All dimensions, size designations given are subject to verification on job site and adjustment to fit job conditions.

CARTIER KITCHENS OTTAWA

DCR #12 SM5 - Vanities



2020
TECHNOLOGIES

DRAWN BY: LD
CARTIER KITCHENS OTTAWA

This is an original design and must not be released or copied unless applicable fee has been paid or job order placed.

Designed: 11/13/2011
Printed: 11/13/2011


Drawing #: 1 No Scale.

CUSTOMER APPROVAL

I have reviewed these drawings and understand the details of the layout and the Carlier Kitchens specifications.

Signature: Mark H. H.

Date: May 18/12

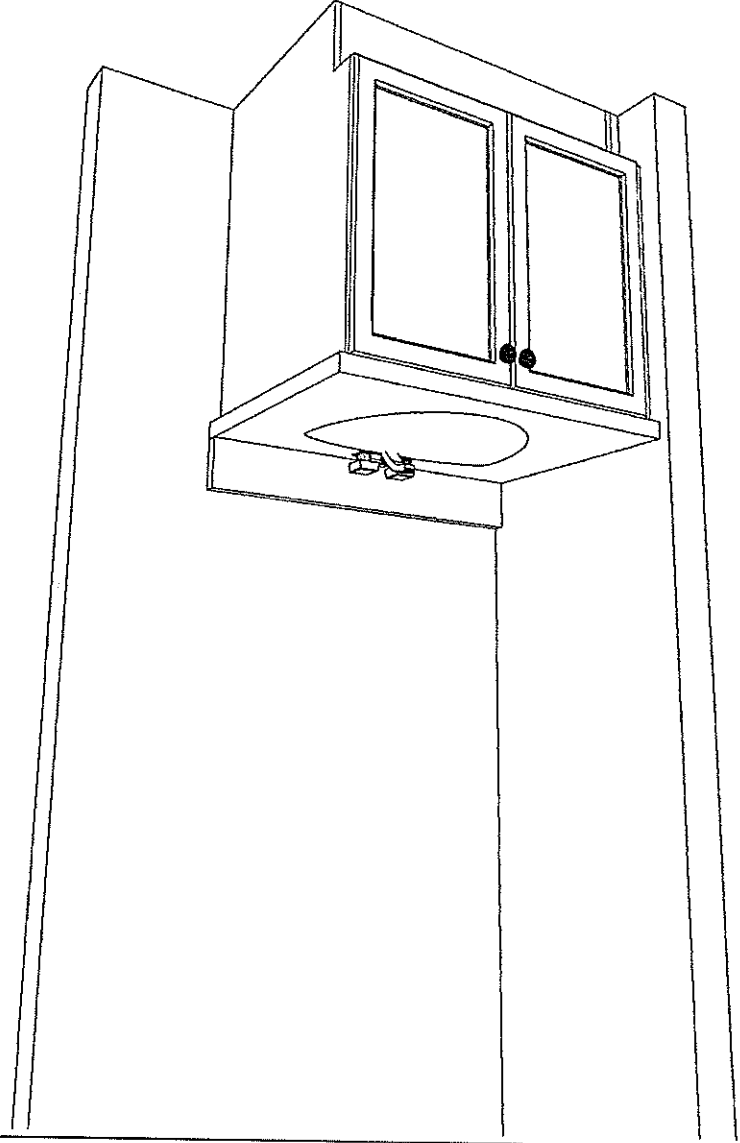

Powder Room

DCR #12 SMS - Vanities	
DESIGNED BY: LORI DISAVERRIO.	
Note: This drawing is an artistic interpretation of the general appearance of the design. It is not meant to be an exact rendition.	
 2020 TECHNOLOGIES	All Drawing #: 1
Designed: 11/13/2011 Printed: 11/13/2011	


CUSTOMER APPROVAL

I have reviewed these drawings and understand the details of the layout and the Carrier Kitchens specifications.

Signature: *[Signature]*

Date: *May 18/12*

Bedroom #2 ensuite

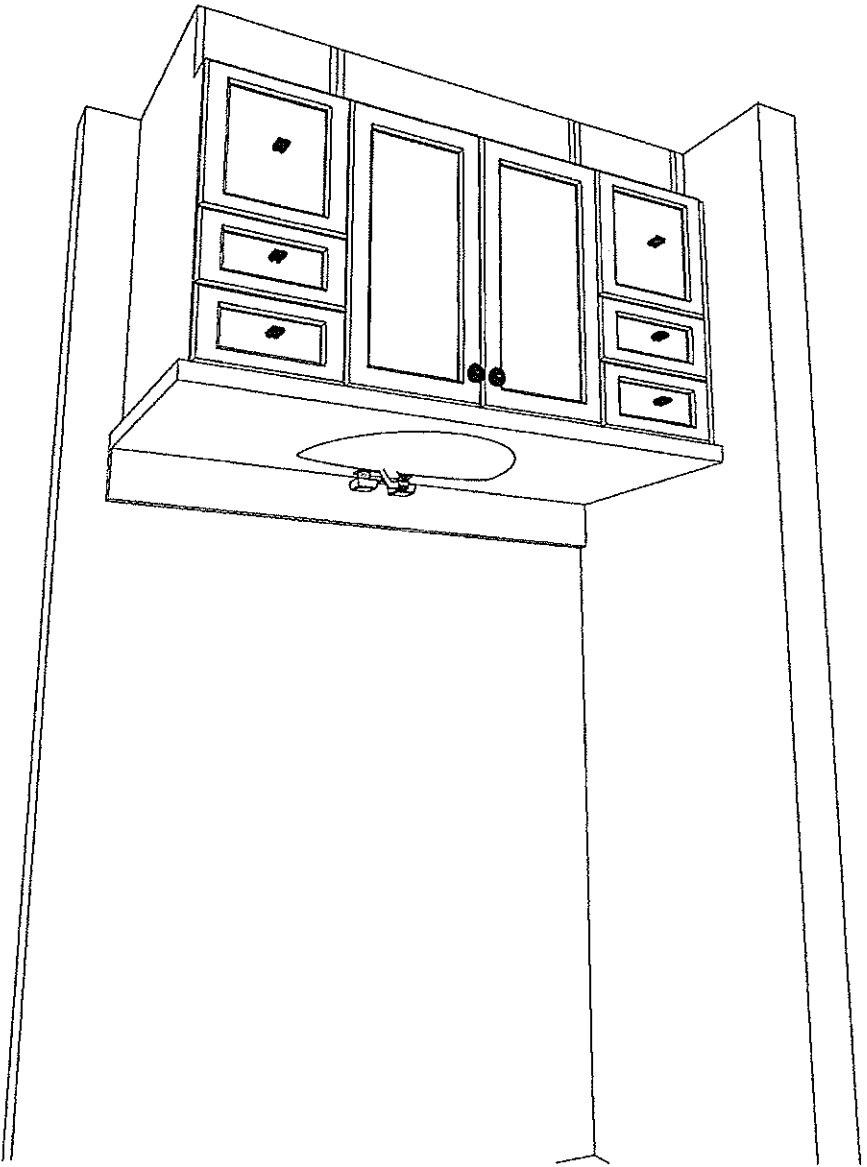


DCR #12 SM5 - Vanities		All		Drawing #: 1	
DESIGNED BY: LORI DISAVERIO,					
Note: This drawing is an artistic interpretation of the general appearance of the design. It is not meant to be an exact rendition.				Designed: 11/13/2011 Printed: 11/13/2011	

CUSTOMER APPROVAL

I have reviewed these drawings and understand the details of the layout and the Carrier Kitchens specifications.

Signature: Robert Allen

Date: May 18/12

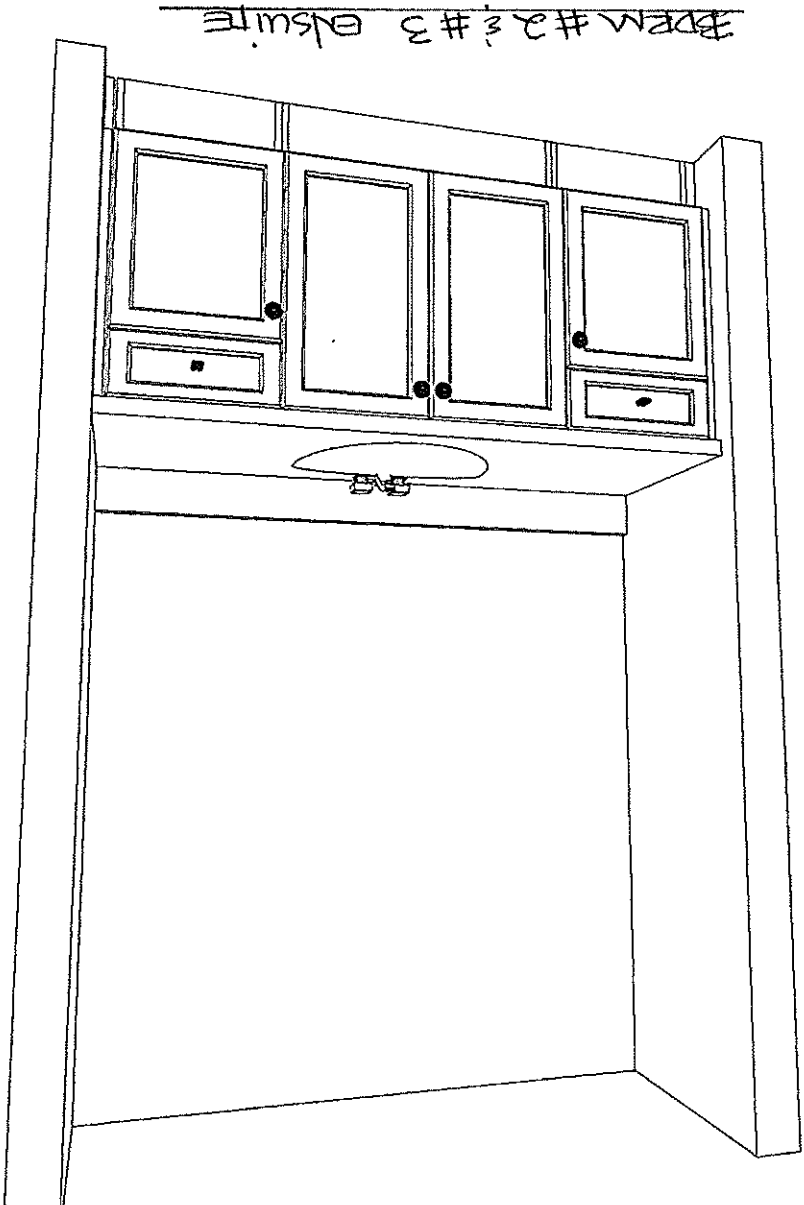

ITEM # 2 & # 3 elskite

Note: This drawing is an artistic interpretation of the general appearance of the design. It is not meant to be an exact rendition.

DESIGNED BY: LORI DISAVERRIO.

DCR #12 SM5 - Vanities

2020
TECHNOLOGIES

Carrier
KITCHENS

Designed: 11/13/2011
Printed: 11/13/2011

Drawing #: 1


All

CUSTOMER APPROVAL

I have reviewed these drawings and understand the details of the layout and the Carrier Kitchens specifications.

Signature: *Rock Hill*

Date: *May 18/12*

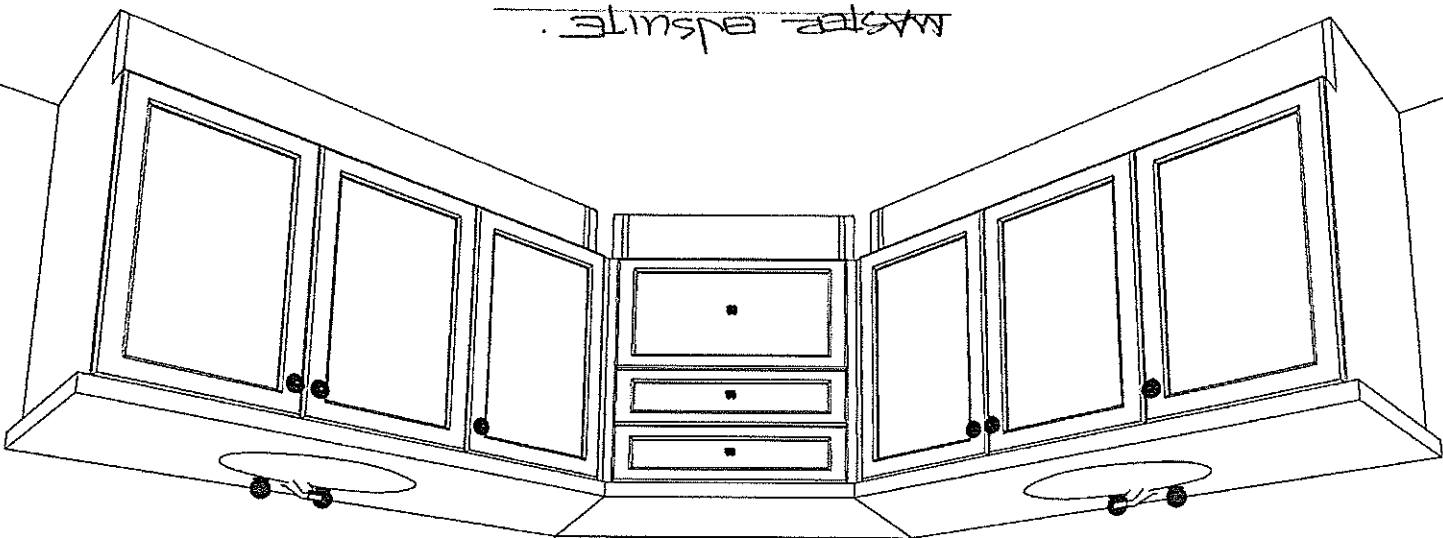

Master suite.

Note: This drawing is an artistic interpretation of the general appearance of the design. It is not meant to be an exact rendition.

DESIGNED BY: LORI DISAVERIO.

2020
TECHNOLOGIES

2020
KITCHENS

Drawing #: 1

All

DCR #12 SMS - Vanities

Designed: 11/13/2011
Printed: 11/13/2011