
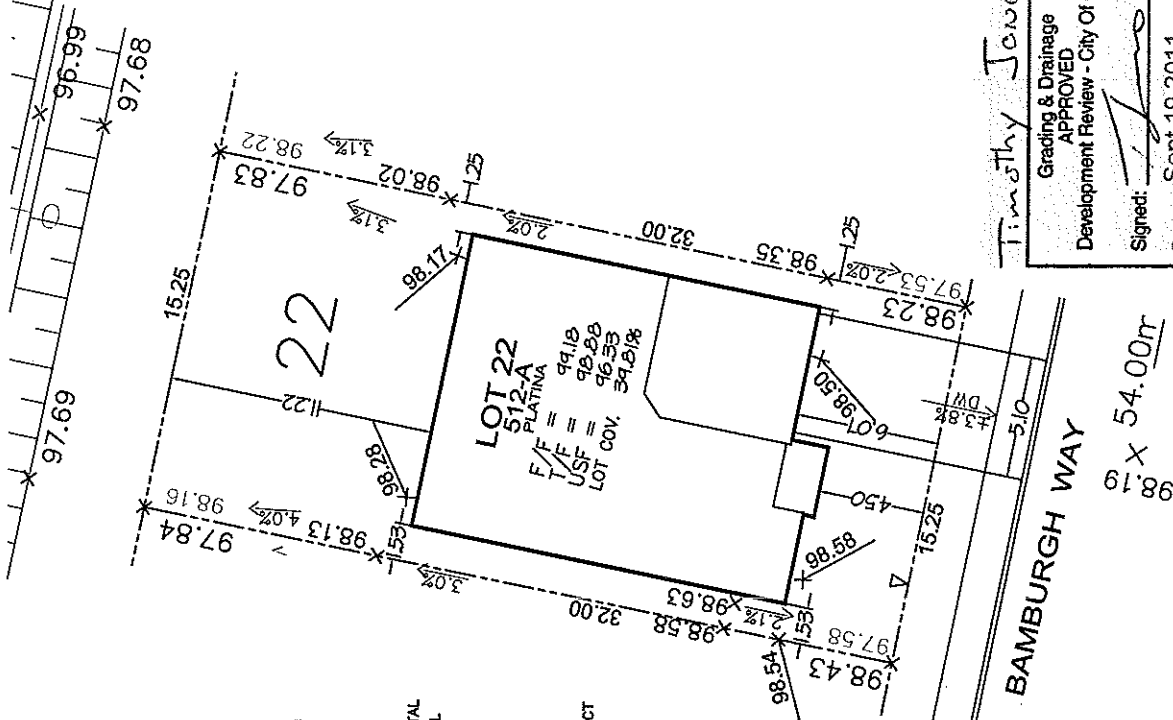


CITY OF-VILLE DE OTTAWA

☐ NEW SUBMISSION ☐ RE-SUBMISSION ☐ MODEL CHANGE ☐ MODEL CHANGE PERMIT #

LEGEND

- F.F. Finish Floor
T.O.F. Top Of Foundation
U.S.F. Underside Of Footing
M.U.S.F. Min. Underside Of Footing
Drainage/Swale Direction
Terracing 3H to 1V (max.)
Service Location
Proposed Grade
Existing Grade
Driveway & Slope Direction
Grade Percentage
Major Storm Flow Direction
Property Line
- CB Catch Basin
Utility Drop Locations
PROPOSED ROGERS CABLE PEDESTAL
EXISTING ROGERS CABLE PEDESTAL
PROPOSED TRANSFORMER
EXISTING TRANSFORMER
PROPOSED BELL PEDESTAL
EXISTING BELL PEDESTAL
PROPOSED STREETLIGHT C/W
BRACKET AND NUMBER
PROPOSED STREETLIGHT DISCONNECT
SANITARY, STORM AND WATER
SERVICE LOCATIONS

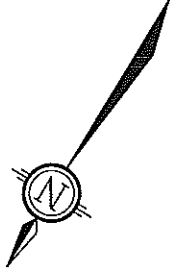


CITY OF-VILLE DE OTTAWA

☐ NEW SUBMISSION ☐ RE-SUBMISSION ☐ MODEL CHANGE ☐ MODEL CHANGE PERMIT #

LEGEND

- F.F. Finish Floor
 T.O.F. Top Of Footing
 U.S.F. Underside Of Footing
 M.U.S.F. Min. Underside Of Footing
 Drainage/Swale Direction
 Terracing 3H to 1V (max.)
 Service Location
 Proposed Grade
 Existing Grade
 Driveway & Slope Direction
 Grade Percentage
 Major Storm Flow Direction
 Property Line
 Catch Basin
 Utility Drop Locations
 PROPOSED ROGERS CABLE PEDESTAL
 EXISTING ROGERS CABLE PEDESTAL
 PROPOSED TRANSFORMER
 EXISTING TRANSFORMER
 PROPOSED BELL PEDESTAL
 EXISTING BELL PEDESTAL
 PROPOSED STREETLIGHT C/W
 BRACKET AND NUMBER
 PROPOSED STREETLIGHT DISCONNECT
 SANITARY, STORM AND WATER
 SERVICE LOCATIONS

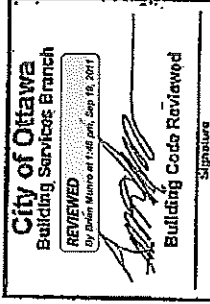


6' X 8'

N

ELEVATIONS SHOWN HEREIN ARE FOR SITE GRADING
PLAN SUBMISSION.

BAMBURGH WAY

CARLINE THOMAS

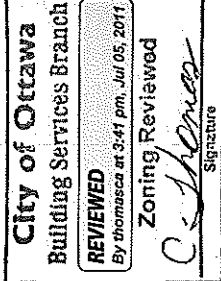

Owner/Applicant
DCR/PHOENIX HOMES

Telephone # 723-9227

Plan # 4M-

Lot # 22 STRANDHERD MEADOWS

Block # Unit #

Conc. #

Civic Address: 354 BAMBURGH WAY

Bldg. Ht. m

Lot coverage 39.81 %

Scale 1:250

ELEVATIONS

Step footings N/A m

Underside footing SEE ABOVE m

Top of foundation SEE ABOVE m

CHECKED/APPROVED BY: T.L.MAK ENG.

MAY 2011

REV.1 JUNE16-11

LOT 22 SITE/GRADING PLAN
STRANDHERD MEADOWS PH5

F.F. = 99.10
 T.O.F. = 98.88
 U.S.F. = 96.33
 LOT COV. 39.81%

PLEASE NOTE: THIS APPLICATION EXPIRES 6(SIX) MONTHS
AFTER DATE RECEIVED

Application No:
 OFFICE USE ONLY: Civic Address:

Circ Date	Circ Date	Circ Date	APPLICATION RECEIVED
Works Division Approval	Zoning Approval	UPO Approval	
Date:	Date:	Date:	