


CUSTOMER ACCEPTANCE _____

DATE _____


Lot 26 SMS

SM 26

Page 2 of 3

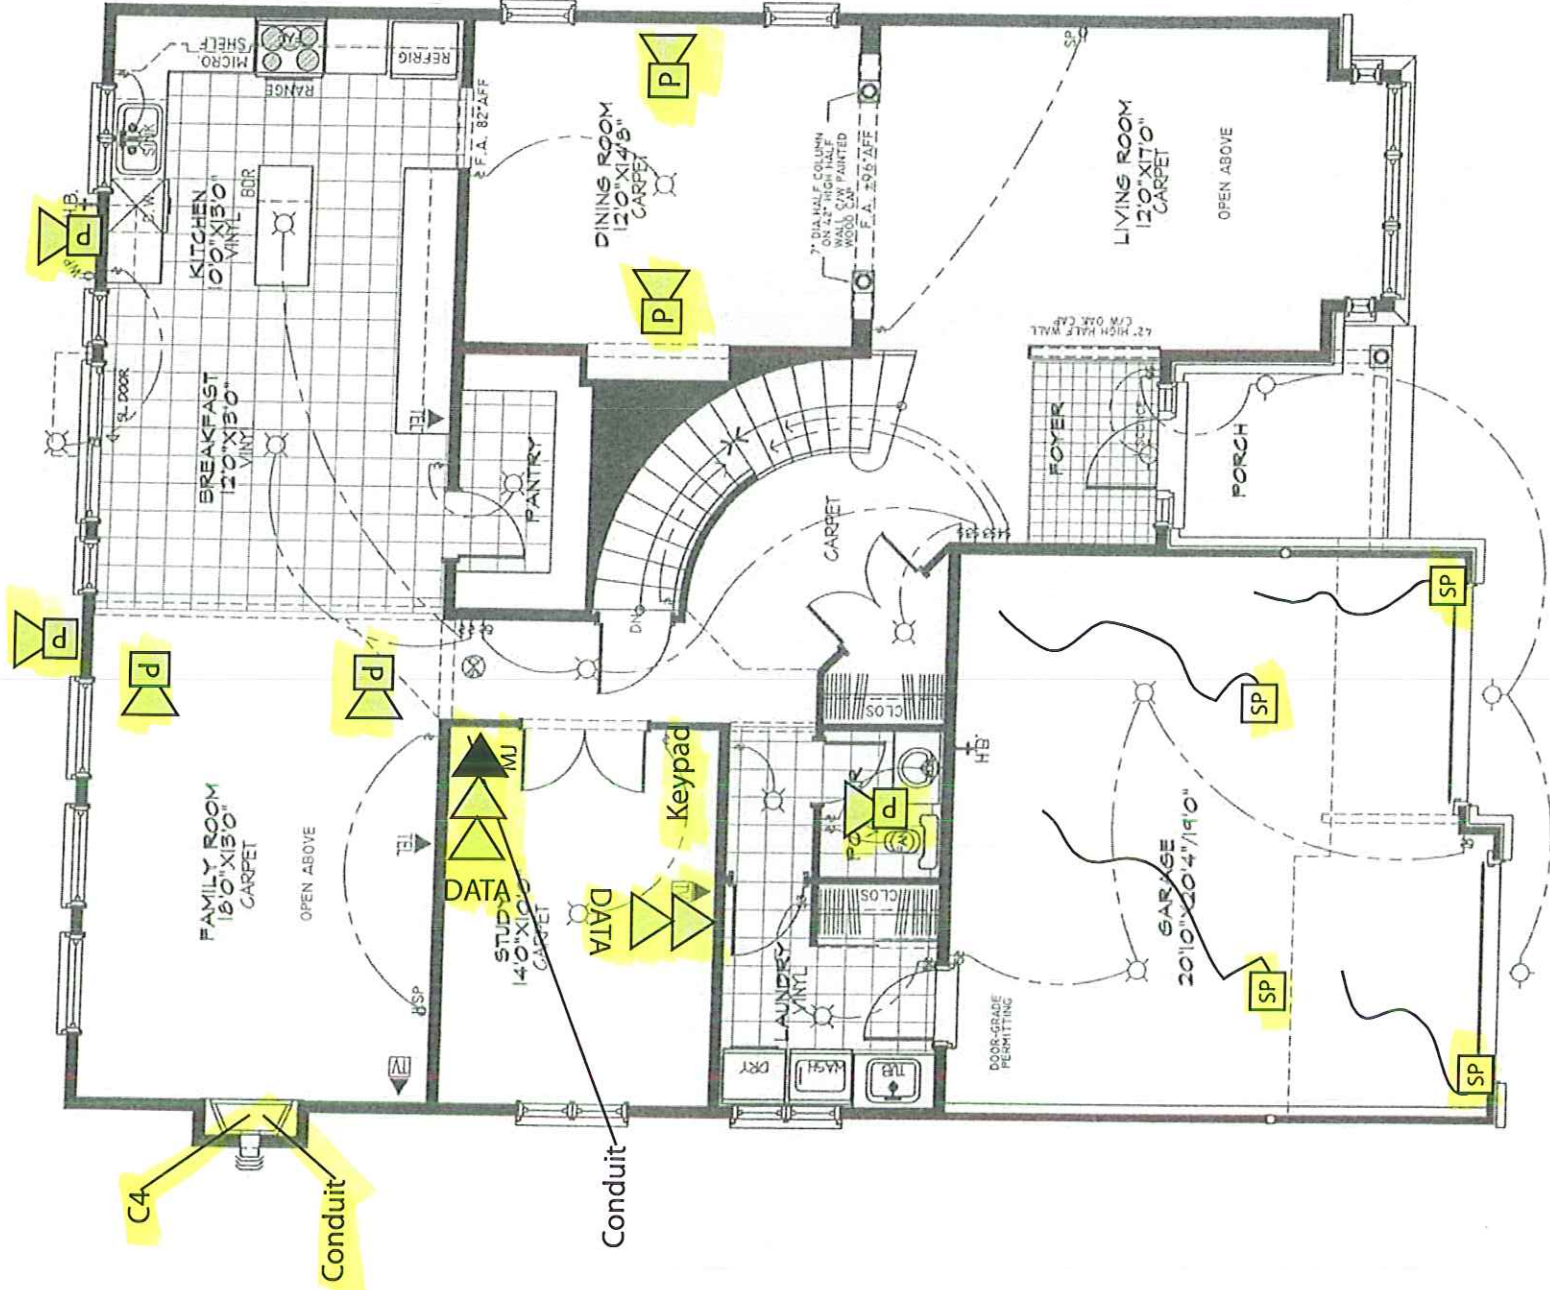

MAIN FLOOR PLAN ELEV. A - 1635 SF

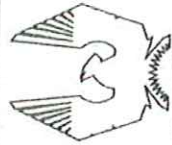

PHOENIX HOMES

CHEASAPEAKE-2007-A

RECEIVED
JUL 13 2009


File number:	508
Drawn by:	A. FRANCOER
Date:	OCT. 2003
Scale:	3/16"=1'
Sheet no.:	3A 9

CUSTOMER ACCEPTANCE _____


DATE _____

SM 26

Page 3 of 3

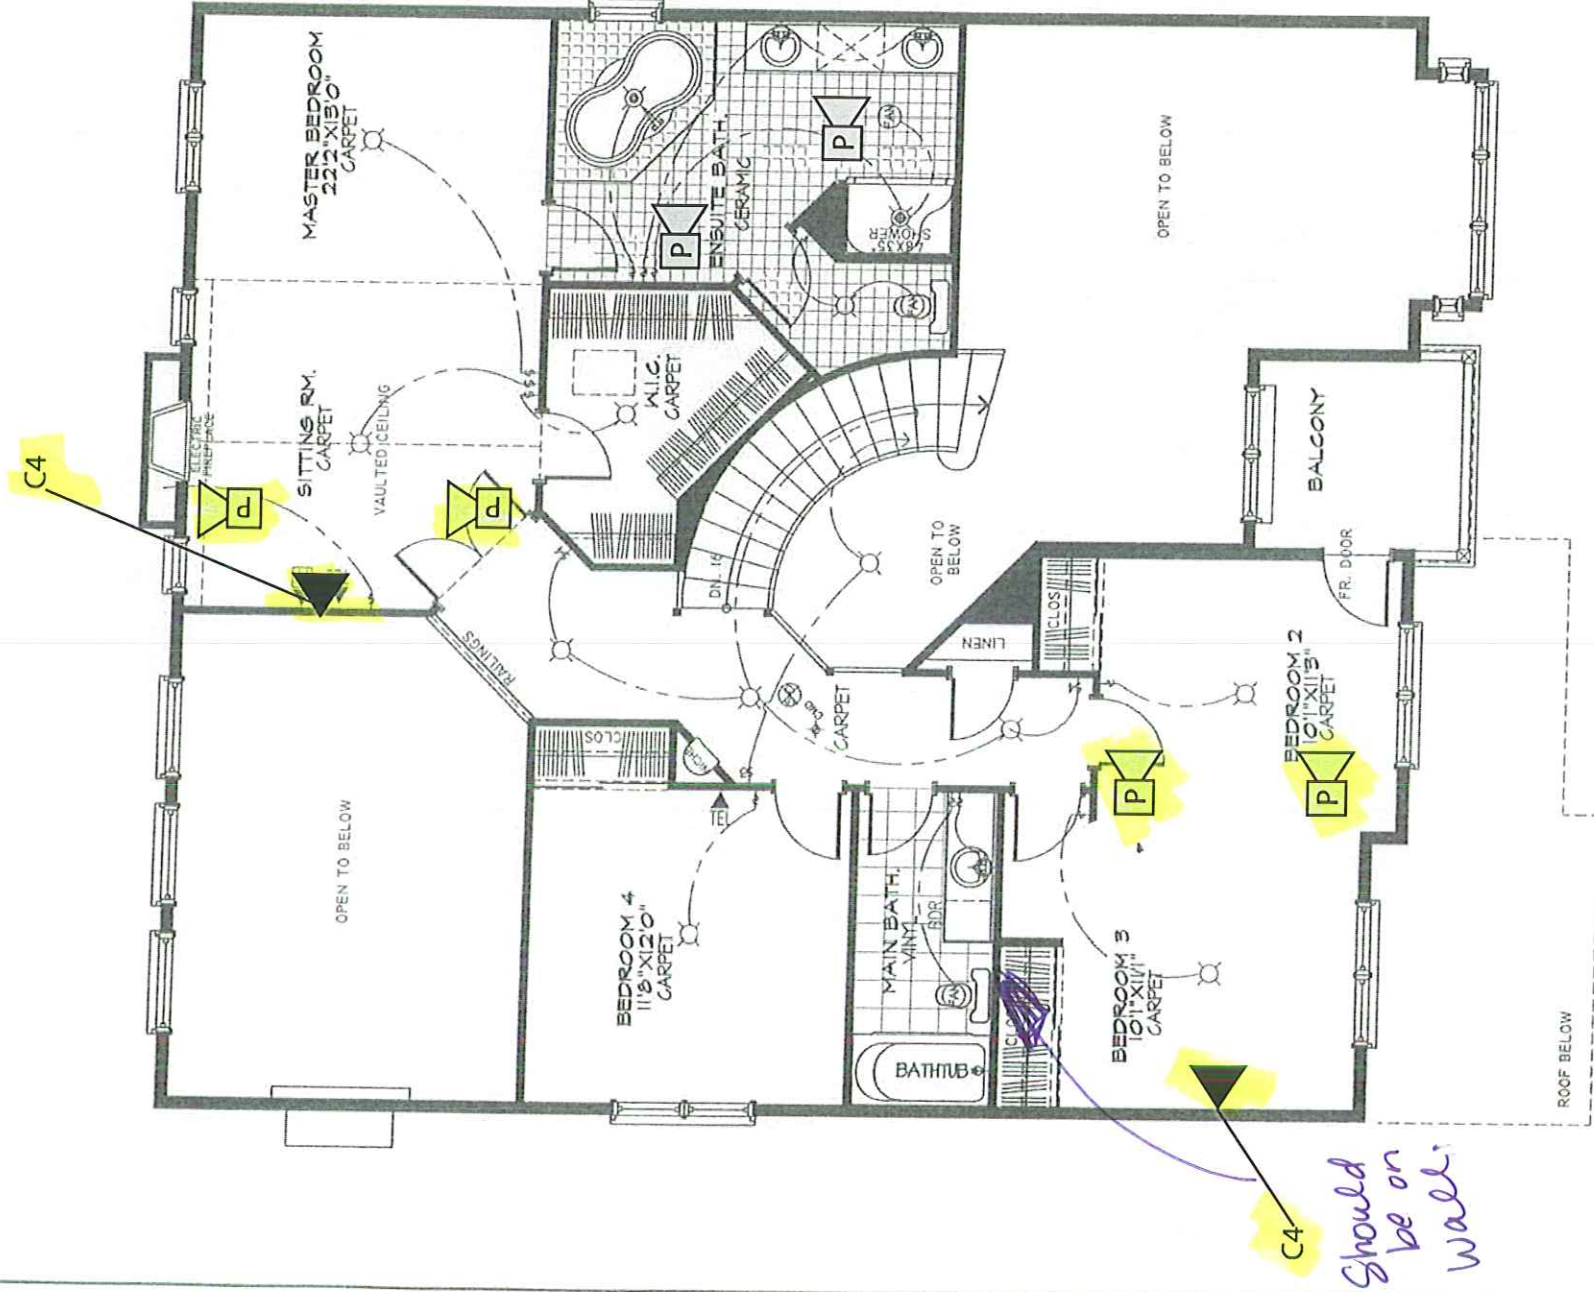

SECOND FLOOR PLAN ELEV. A - 1335 SF

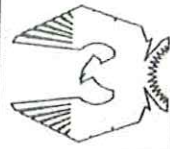

PHOENIX HOMES

CHEASAPEAKE-2007-A

RECEIVED

JUL 13 2009

File number: 508

drawn by: A. FRANCOER

date: OCT. 2003

scale: 3/16"=1'

sheet no:

4A
9