
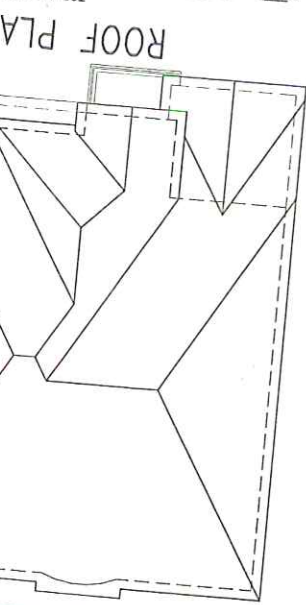


Johns
Wesley

FRONT ELEVATION 'A'
 = *Hand Drawn Studio*
 MONTGOMERY TRAPPE

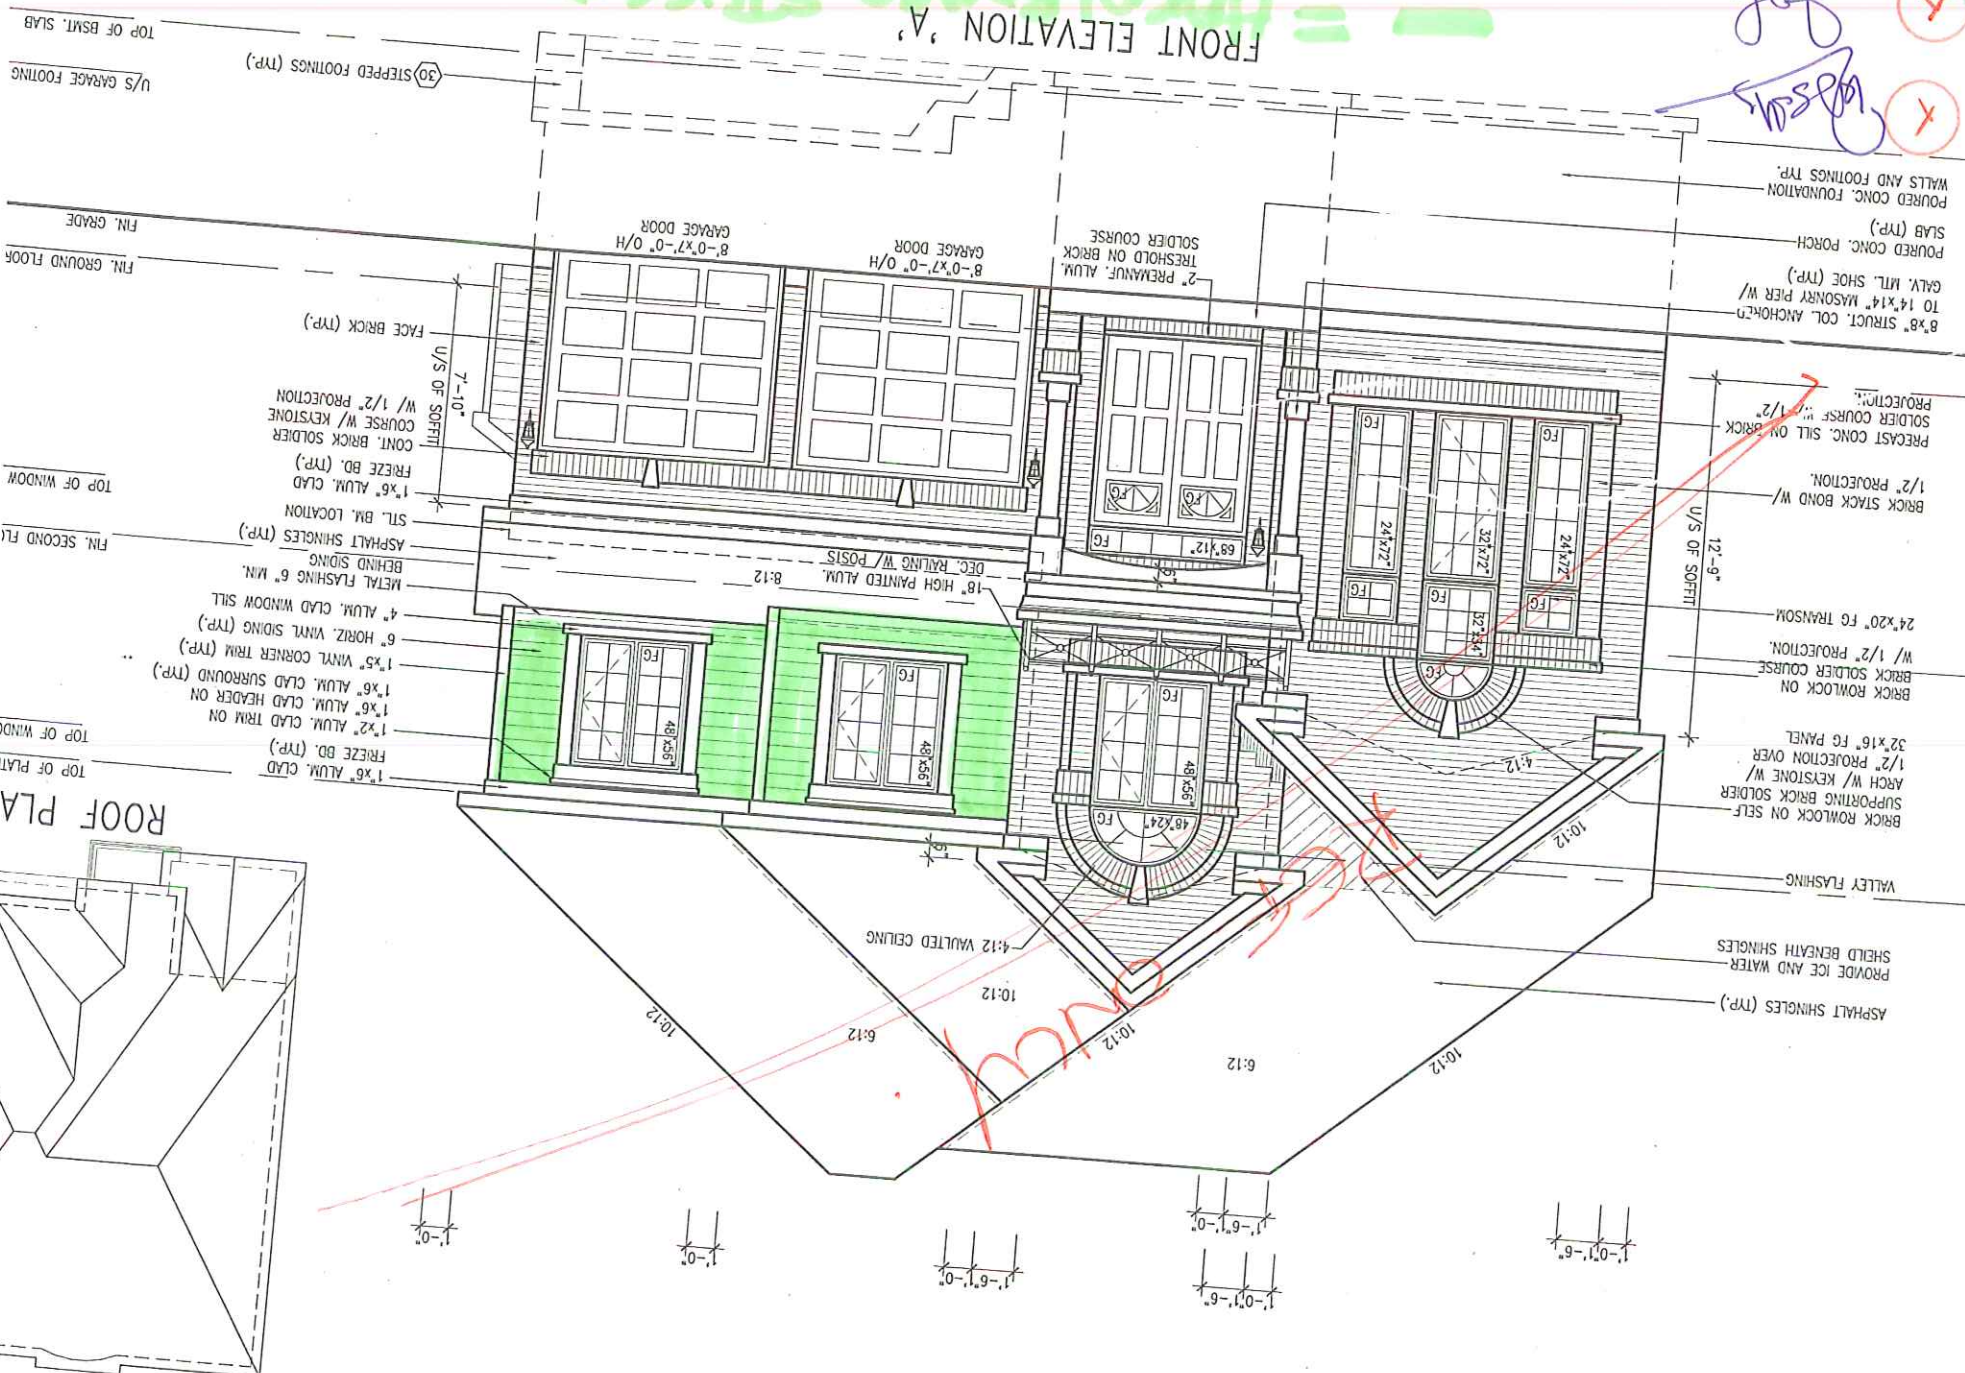

TOP OF BSMT. SLAB
 U/S GARAGE FOOTING
 FIN. GROUND FLOOR
 FIN. SECOND FLR
 TOP OF WINDOW
 TOP OF PLATT

WALLS AND FOOTINGS TYP.
 POURED CONC. FOUNDATION
 SLAB (TYP.)
 POURED CONC. PORCH
 GALV. MTL. SHOE (TYP.)
 8"x8" STRUCT. COL. ANCHORED TO 14"x14" MASONRY PIER W/ 1/2" PROJECTION.
 PRECAST CONC. SILL ON BRICK 1/2" PROJECTION.
 BRICK STACK BOND W/ 1/2" PROJECTION.
 12'-9" U/S OF SOFTI
 24"x20" FG TRANSOM W/ 1/2" PROJECTION.
 BRICK ROWLOCK ON BRICK SOLDIER COURSE
 32"x16" FG PANEL
 SUPPORTING BRICK SOLDIER ARCH W/ KEystone OVER 1/2" PROJECTION
 BRICK ROWLOCK ON SELF
 VALLEY FLASHING
 PROVIDE ICE AND WATER SHIELD BENEATH SHINGLES
 ASPHALT SHINGLES (TYP.)

1"x6" ALUM. CLAD TRIM ON FRIEZE BD. (TYP.)
 1"x2" ALUM. CLAD TRIM ON 1"x6" ALUM. CLAD SURROUND (TYP.)
 1"x6" ALUM. CLAD WINDOW SILL
 4" ALUM. CLAD WINDOW SILL
 METAL FLASHING 6" MIN. BEHIND SIDING
 ASPHALT SHINGLES (TYP.)
 STL. BM. LOCATION
 1"x6" ALUM. CLAD FRIEZE BD. (TYP.)
 CONT. BRICK SOLDIER COURSE W/ KEystone W/ 1/2" PROJECTION
 FACE BRICK (TYP.)
 7'-10" U/S OF SOFTI

18" HIGH PAINTED ALUM. DEC. RAILING W/ POSTS 8:12

2" PREMANUF. ALUM. TRESHOLD ON BRICK SOLDIER COURSE

8'-0"x7'-0" O/H GARAGE DOOR

8'-0"x7'-0" O/H GARAGE DOOR

4:12 VAULTED CEILING

6:12

10:12

6:12

10:12

10:12

10:12

1'-0" 1'-6" 1'-0"

1'-0" 1'-6" 1'-0"

