


☐ NEW SUBMISSION ☐ RE-SUBMISSION ☐ MODEL CHANGE ☐ MODEL CHANGE PERMIT #

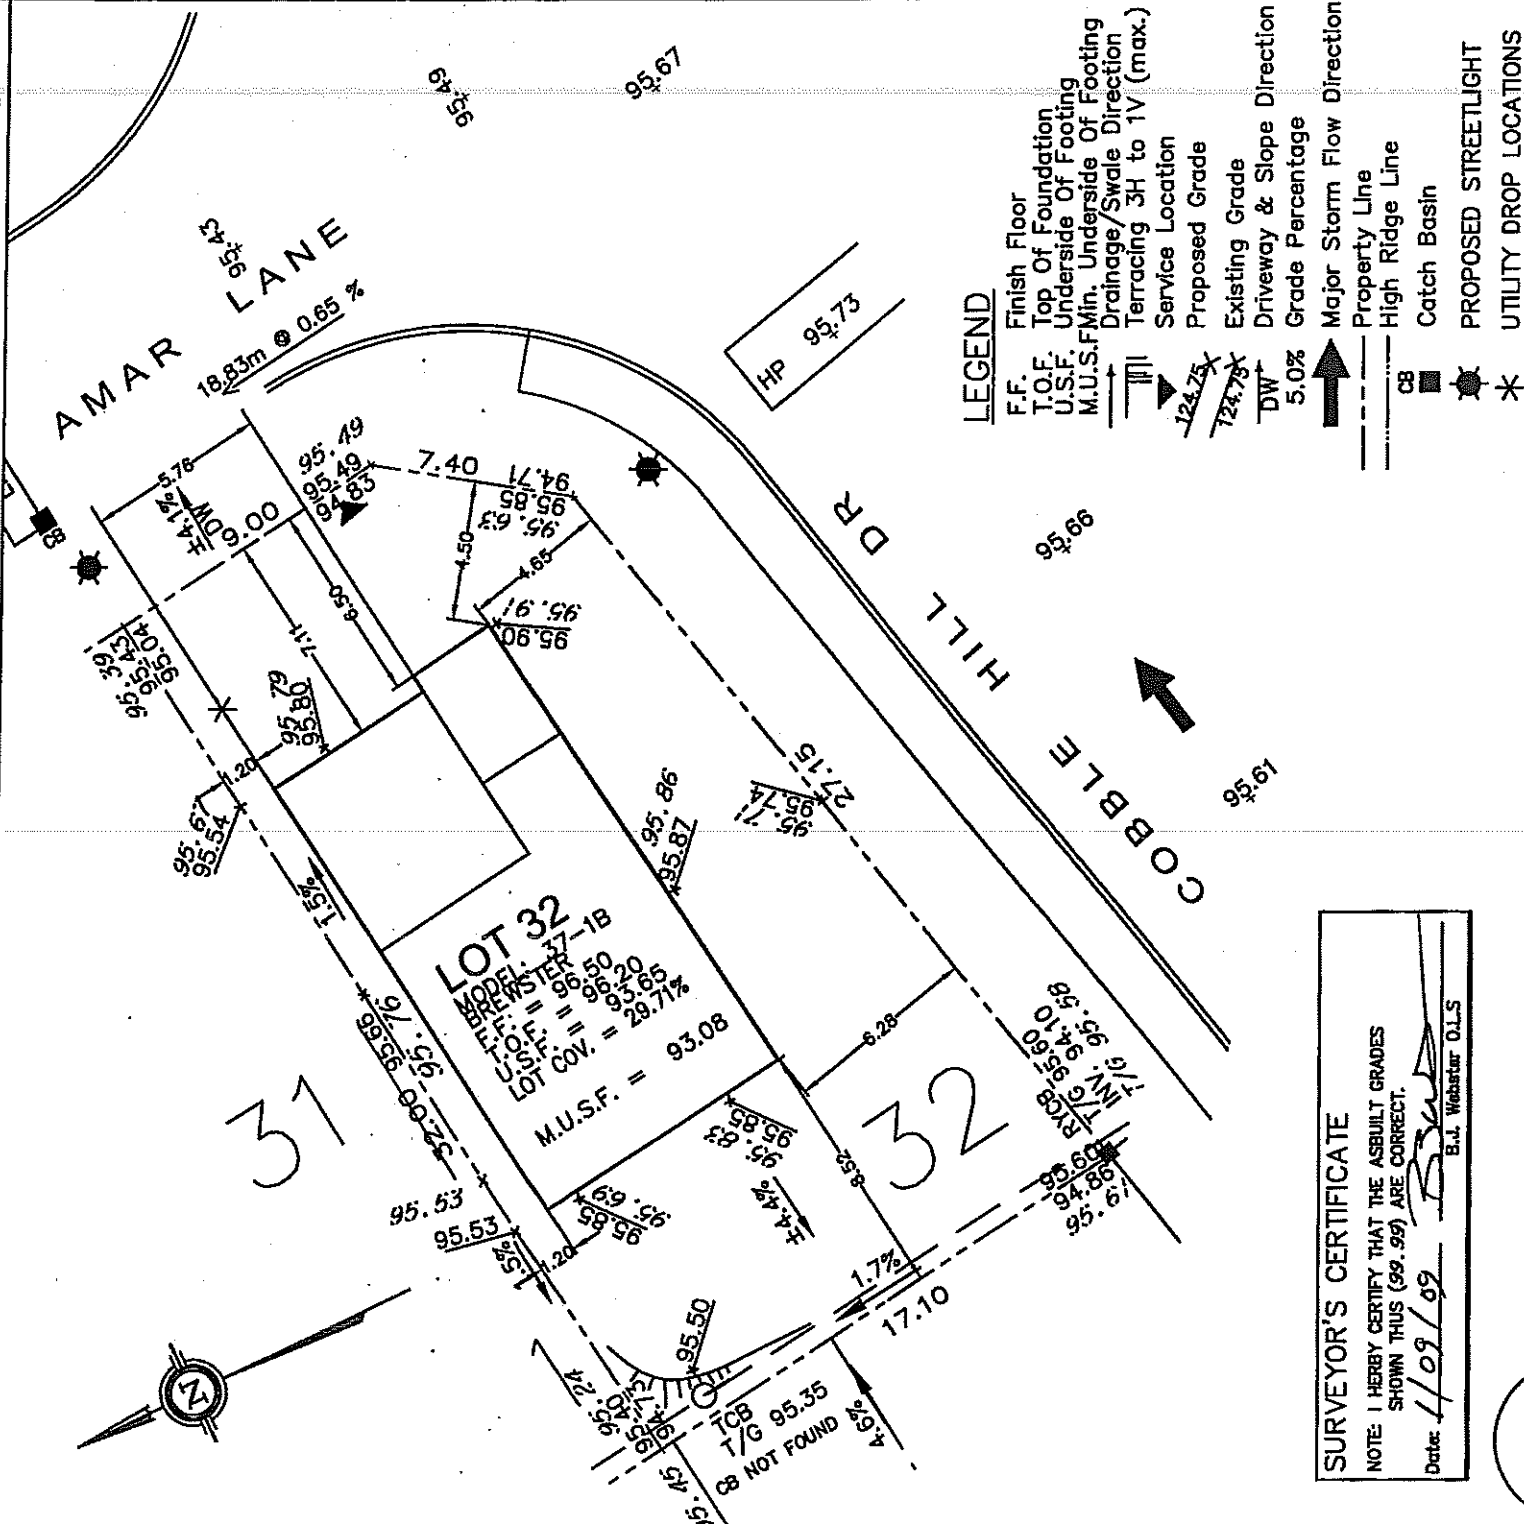

LOT SITE/GRADING PLAN
32 STRANDHERD MEADOWS

F.F. = 96.50
T.O.F. = 96.20
U.S.F. = 93.65
LOT COV. 29.71%

Owner/Applicant
DCR PHOENIX HOMES
Telephone # 723-9227
Plan # 4M-
Lot # 32 STRANDHERD MEADOWS
Block # Unit #
Conc. #
Civic Address: 401 AMAR LANE

Bldg. Ht. m
Lot coverage 29.71 %
Scale 1:250

ELEVATIONS
Step footings N/A m
Underside footing SEE ABOVE m
Top of foundation SEE ABOVE m

CHECKED/APPROVED BY: T.LMAK ENG.
MARCH 2007
REV.1 MAR26-07

PLEASE NOTE: THIS APPLICATION EXPIRES 6(SIX) MONTHS
AFTER DATE RECEIVED

OFFICE USE ONLY: Civic Address:

Circ Date	Circ Date	Circ Date	APPLICATION RECEIVED
Works Division Approval Date:	Zoning Approval Date:	UPO Approval Date:	