

CITY OF-VILLE DE OTTAWA

☐ NEW SUBMISSION ☐ RE-SUBMISSION ☐ MODEL CHANGE ☐ MODEL CHANGE PERMIT #

CARLINE THOMAS




Min. 3/4hr F.R.R. for E.B.F.
@ L.D. less than 1.2m.
No U.P.O. permitted.

LEGEND

- F.F. Finish Floor
- T.O.F. Top Of Foundation
- U.S.F. Underside Of Footing
- M.U.S.F. Min. Underside Of Footing
- Drainage/Swale Direction
- Terracing 3H to 1V (max.)
- Service Location
- Proposed Grade
- Existing Grade
- Driveway & Slope Direction
- Grade Percentage
- Major Storm Flow Direction
- Property Line
- CB Catch Basin
- Utility Drop Locations
- PROPOSED ROGERS CABLE PEDESTAL
- EXISTING ROGERS CABLE PEDESTAL
- PROPOSED TRANSFORMER
- EXISTING TRANSFORMER
- PROPOSED BELL PEDESTAL
- EXISTING BELL PEDESTAL
- PROPOSED STREETLIGHT C/W BRACKET AND NUMBER
- PROPOSED STREETLIGHT DISCONNECT
- SANITARY, STORM AND WATER SERVICE LOCATIONS

ELEVATIONS SHOWN HEREON ARE FOR SITE GRADING PLAN SUBMISSION.

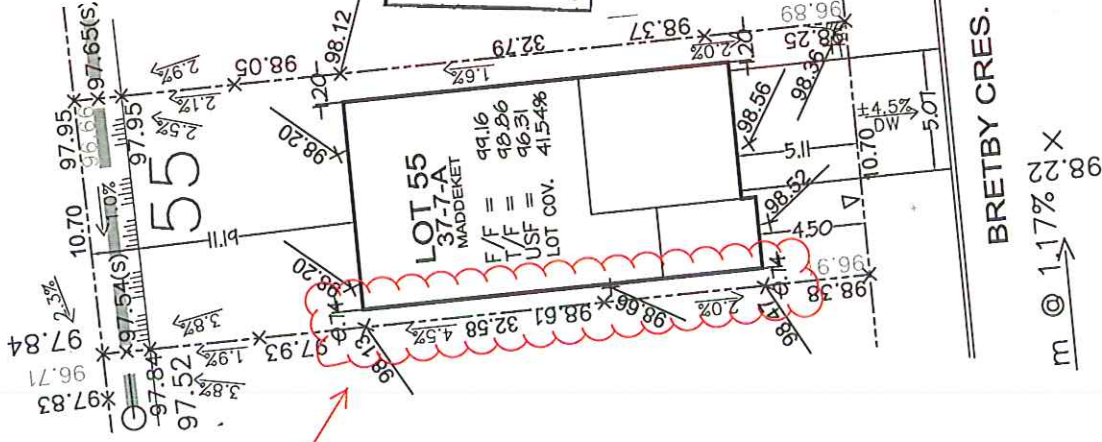

BRETRY CRES.

Owner/Applicant

DCR/PHOENIX HOMES

Telephone # 723-9227

Plan # 4M-

Lot # 55 STRANDHERD MEADOWS

Block # Unit #

Conc. #

Civic Address: 510 BRETRY CRES.

Bldg. Ht. m

Lot coverage 41.54 %

Scale 1:250

ELEVATIONS

Step footings N/A m

Underside footing SEE ABOVE m

Top of foundation SEE ABOVE m

CHECKED/APPROVED BY: T.L.MAK ENG.

JULY 2011

REV.1 JULY28-11

LOT 55 SITE/GRADING PLAN
STRANDHERD MEADOWS PH5

F.F. = 99.16
T.O.F. = 98.26
U.S.F. = 96.31
LOT COV. 41.54%

PLEASE NOTE: THIS APPLICATION EXPIRES 6(SIX) MONTHS AFTER DATE RECEIVED

Application No:

OFFICE USE ONLY: Civic Address:

Circ Date	Circ Date	Circ Date	APPLICATION RECEIVED
Works Division Approval	Zoning Approval	UPO Approval	
Date:	Date:	Date:	