

DCR PHOENIX HOMES

STRANDHERD MEADOWS 5

LOT #5

PLATINA (512) - RIGHT

KITCHEN

Rev. Sept. 21/11

CUSTOMER APPROVAL

I have reviewed these drawings and understand the details of the layout and the Cartier Kitchens specifications.

Signature

Date

LINE-
DOOR STYLE -
SPECIES -
COLOUR -

HW:

3 PCS - KICK

STD WHITE INTERIORS

METAL DRAWER BOXES


2 - PCS. 90 DEG. CORNER MOULD.

1 PC - T MOULD

CROWN MOULDING

LIGHT VALANCE

MOUNTING HT: 93" / STAGGERED TO 96"

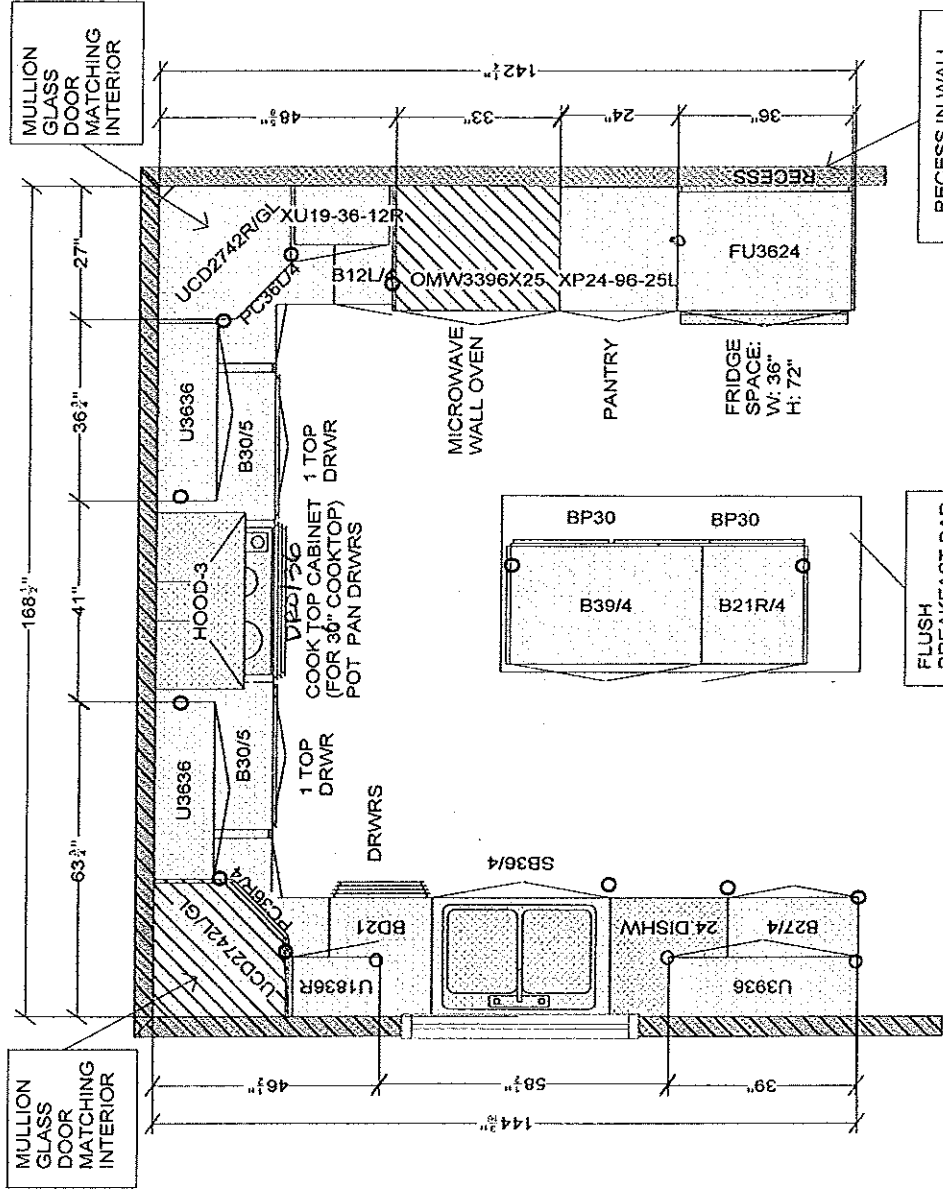

All dimensions, size designations given are subject to verification on job site and adjustment to fit job conditions.

CARTIER KITCHENS OTTAWA



20 YEARS
TECHNOLOGY

This is an original design and must not be released or copied unless applicable fee has been paid or job order placed.

DRAWN BY: LD
CARTIER KITCHENS OTTAWA


Designed: 6/5/2011
Printed: 6/5/2011

DCR #5 SM5 - Kitchen - 512 Platina (Right)

All

Drawing #: 1

3D View #2 ~ Kitchen
 LOT #5-SMS
 Rev. SEPT. 21/11

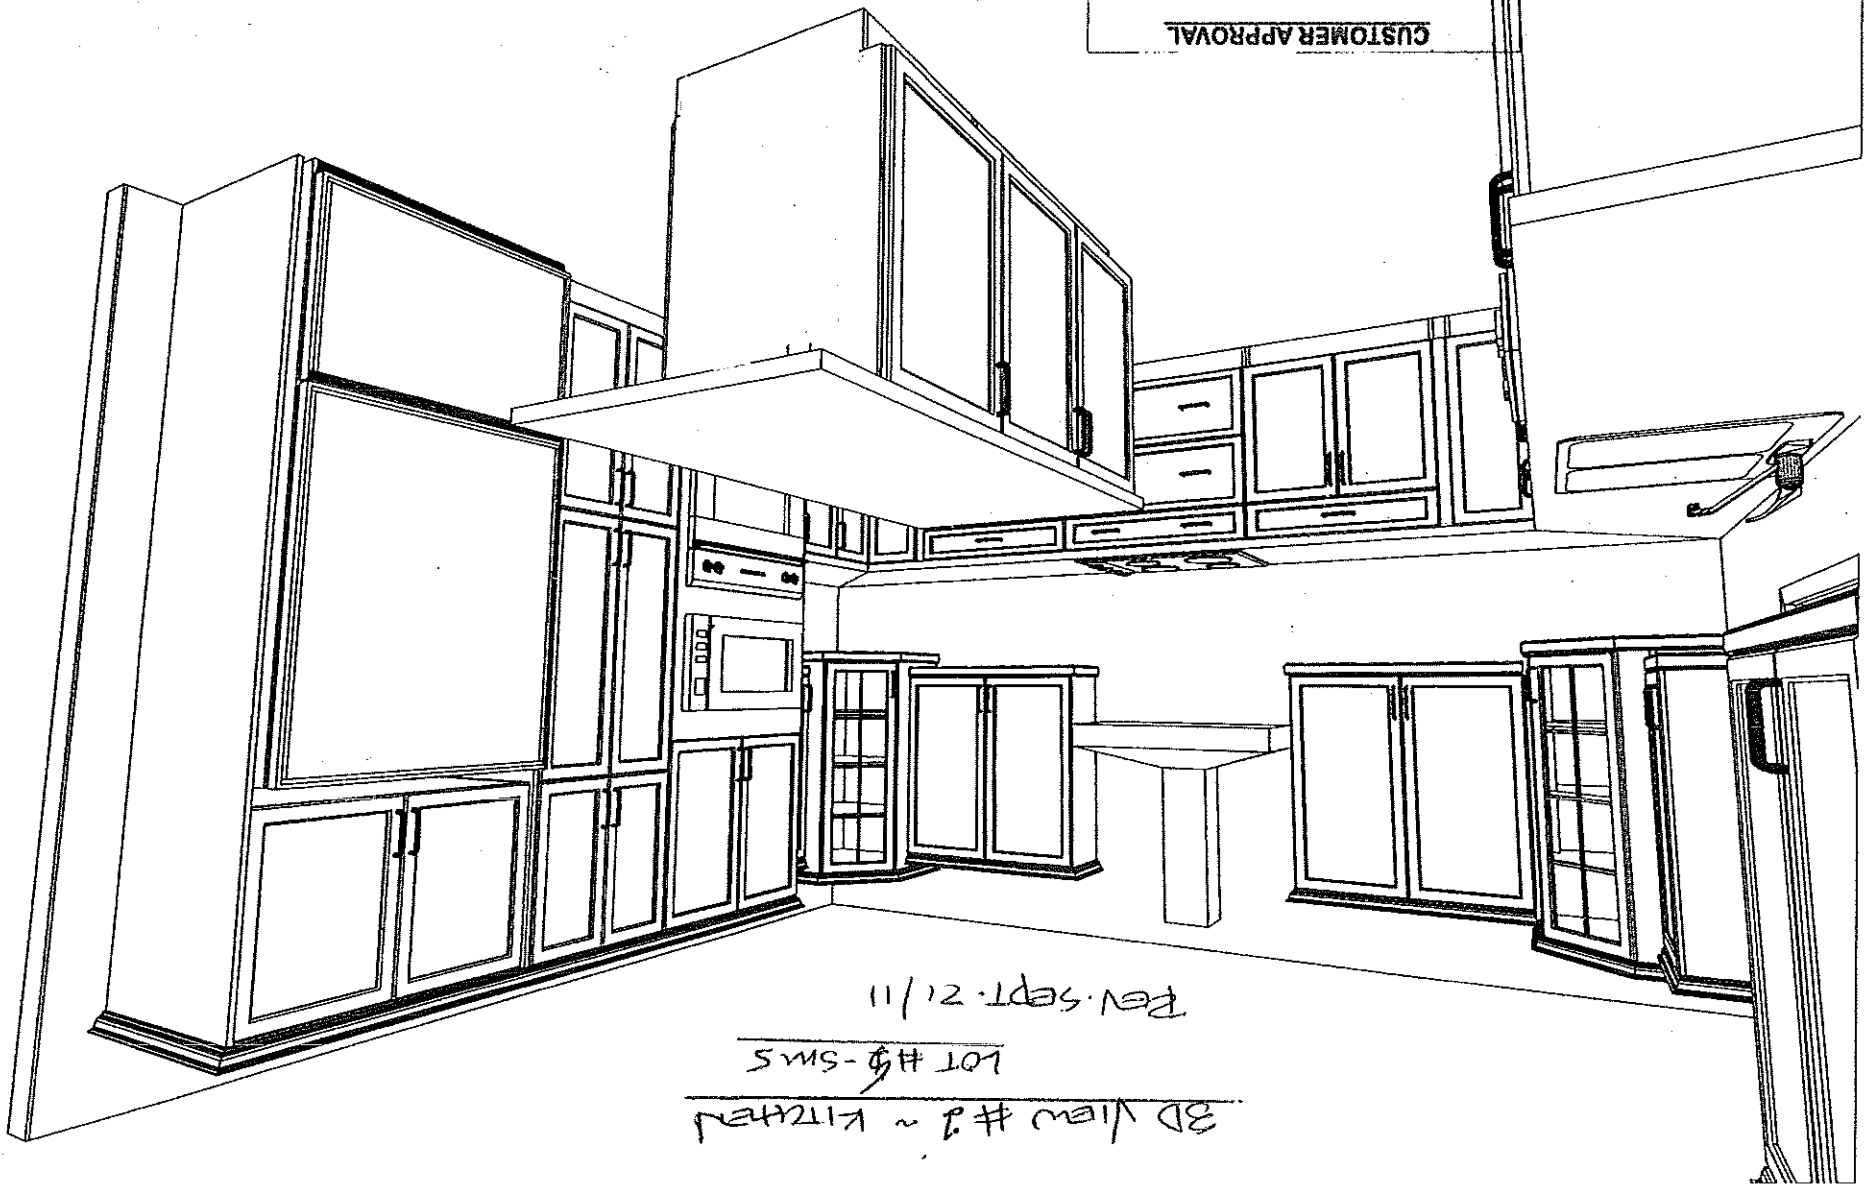

CUSTOMER APPROVAL

I have reviewed these drawings and understand the details of the layout and the Carter Kitchens specifications.

Signature: *[Signature]*
 Date: *[Signature]*


Note: This drawing is an artistic interpretation of the general appearance of the design. It is not meant to be an exact rendition.

DRAWN BY: Lori Di Saverio, B.I.D.
 CARTIER KITCHENS OTTAWA

2010 TECHNOLOGIES



Designed: 6/5/2011
 Printed: 6/5/2011
 Drawing #: 1

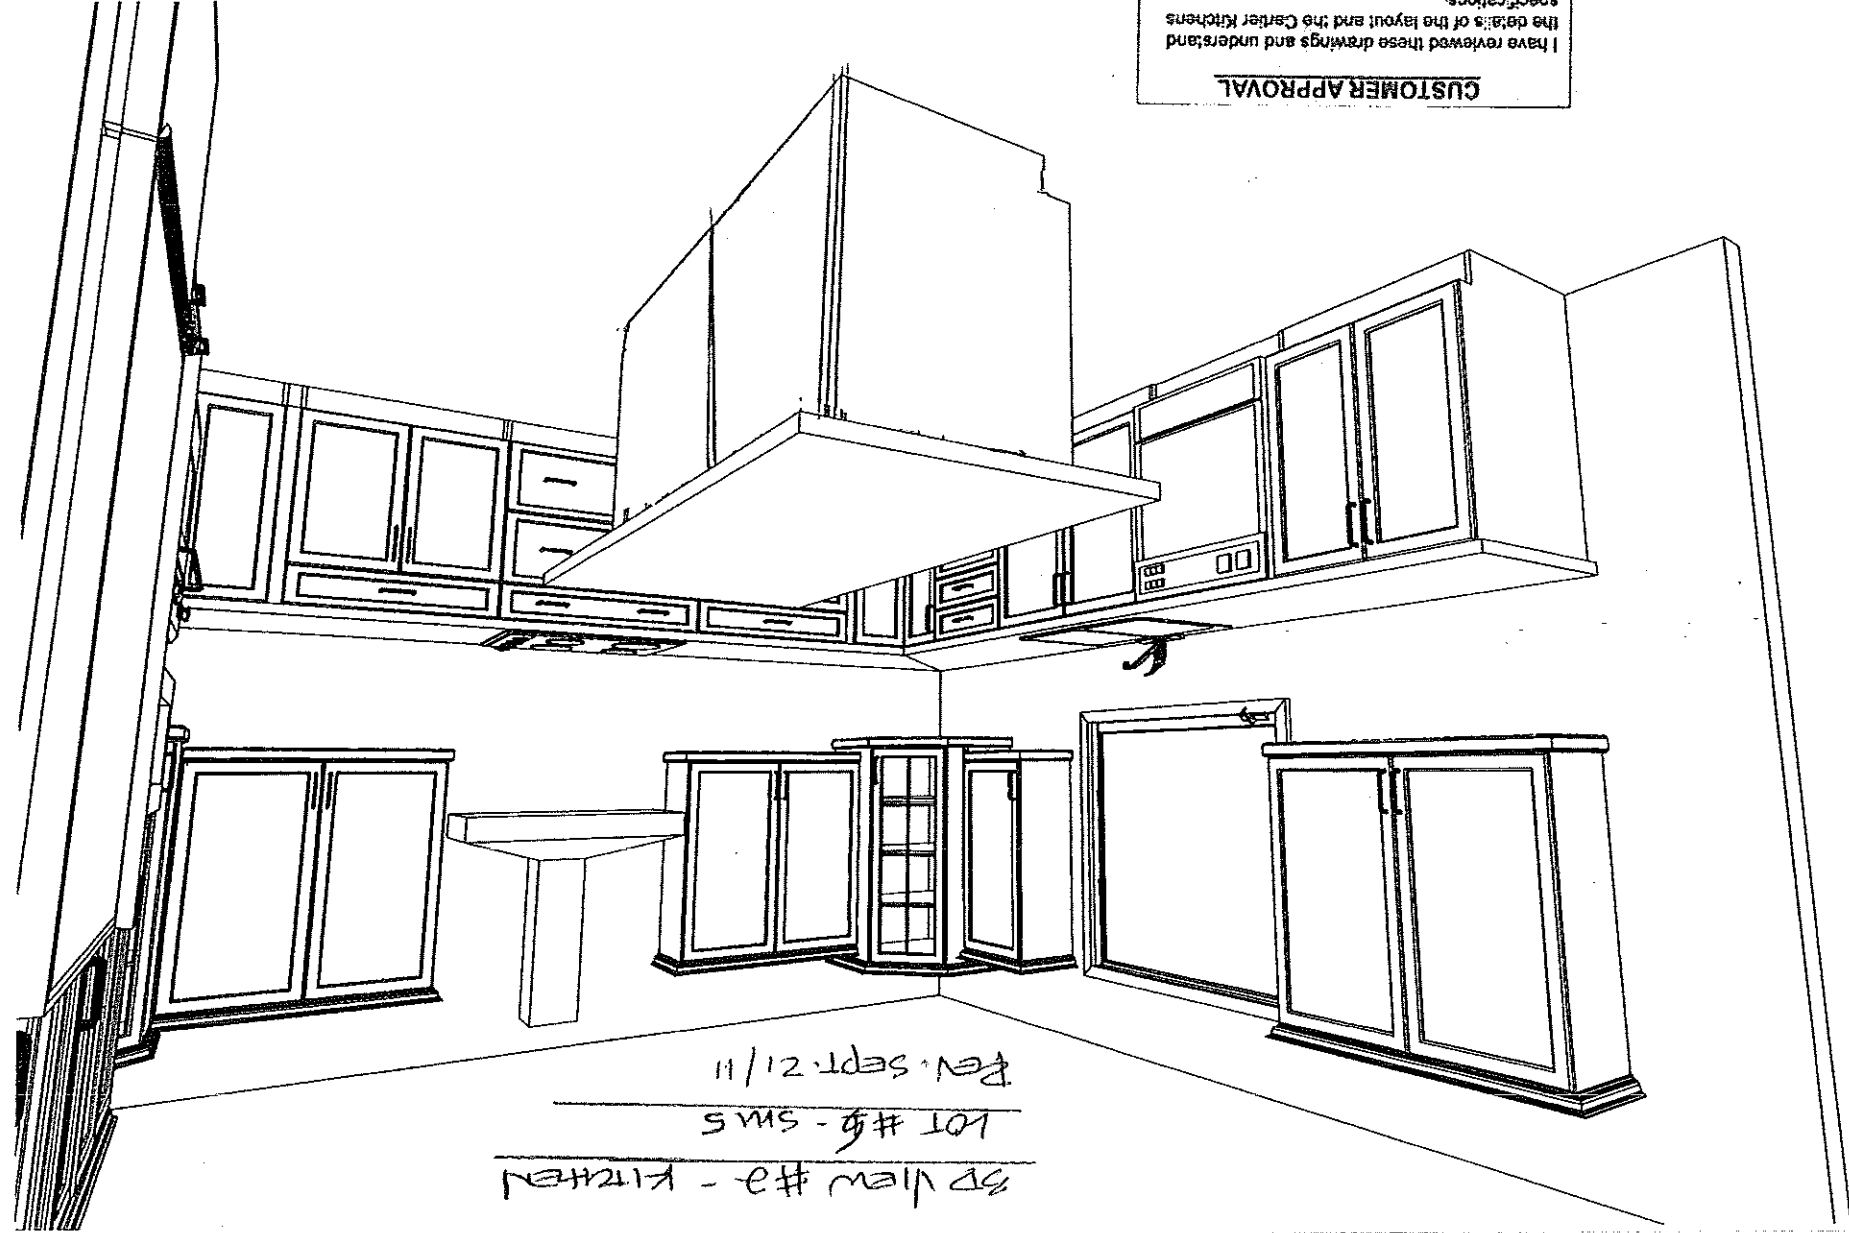

3D view #2 - kitchen
LOT #6 - SMS
REV. SEPT. 21/11

CUSTOMER APPROVAL

I have reviewed these drawings and understand the details of the layout and the Carter Kitchens specifications.

Signature: *[Signature]*
Date: *[Signature]*

Note: This drawing is an artistic interpretation of the general appearance of the design. It is not meant to be an exact rendition.

DRAWN BY: Lori Di Saverio, B.L.D.
CARTIER KITCHENS OTTAWA



All

DCR #5 SMS - Kitchen - 512 Platina (Right)

Drawing #: 1

Designed: 6/5/2011
Printed: 6/5/2011

CUSTOMER APPROVAL

I have reviewed these drawings and understand the details of the layout and the Carter Kitchens specifications.

Signature: *[Signature]*

Date: *[Date]*

Note: This drawing is an artistic interpretation of the general appearance of the design. It is not meant to be an exact rendition.

DRAWN BY: Lori Di Saverio, B.I.D.
CARTIER KITCHENS OTTAWA

DCR # SSM5 - Kitchen - 512 Platina (Right)


All

Drawing #: 1

Designed: 6/5/2011
Printed: 6/5/2011

2020 TECHNOLOGIES

2020

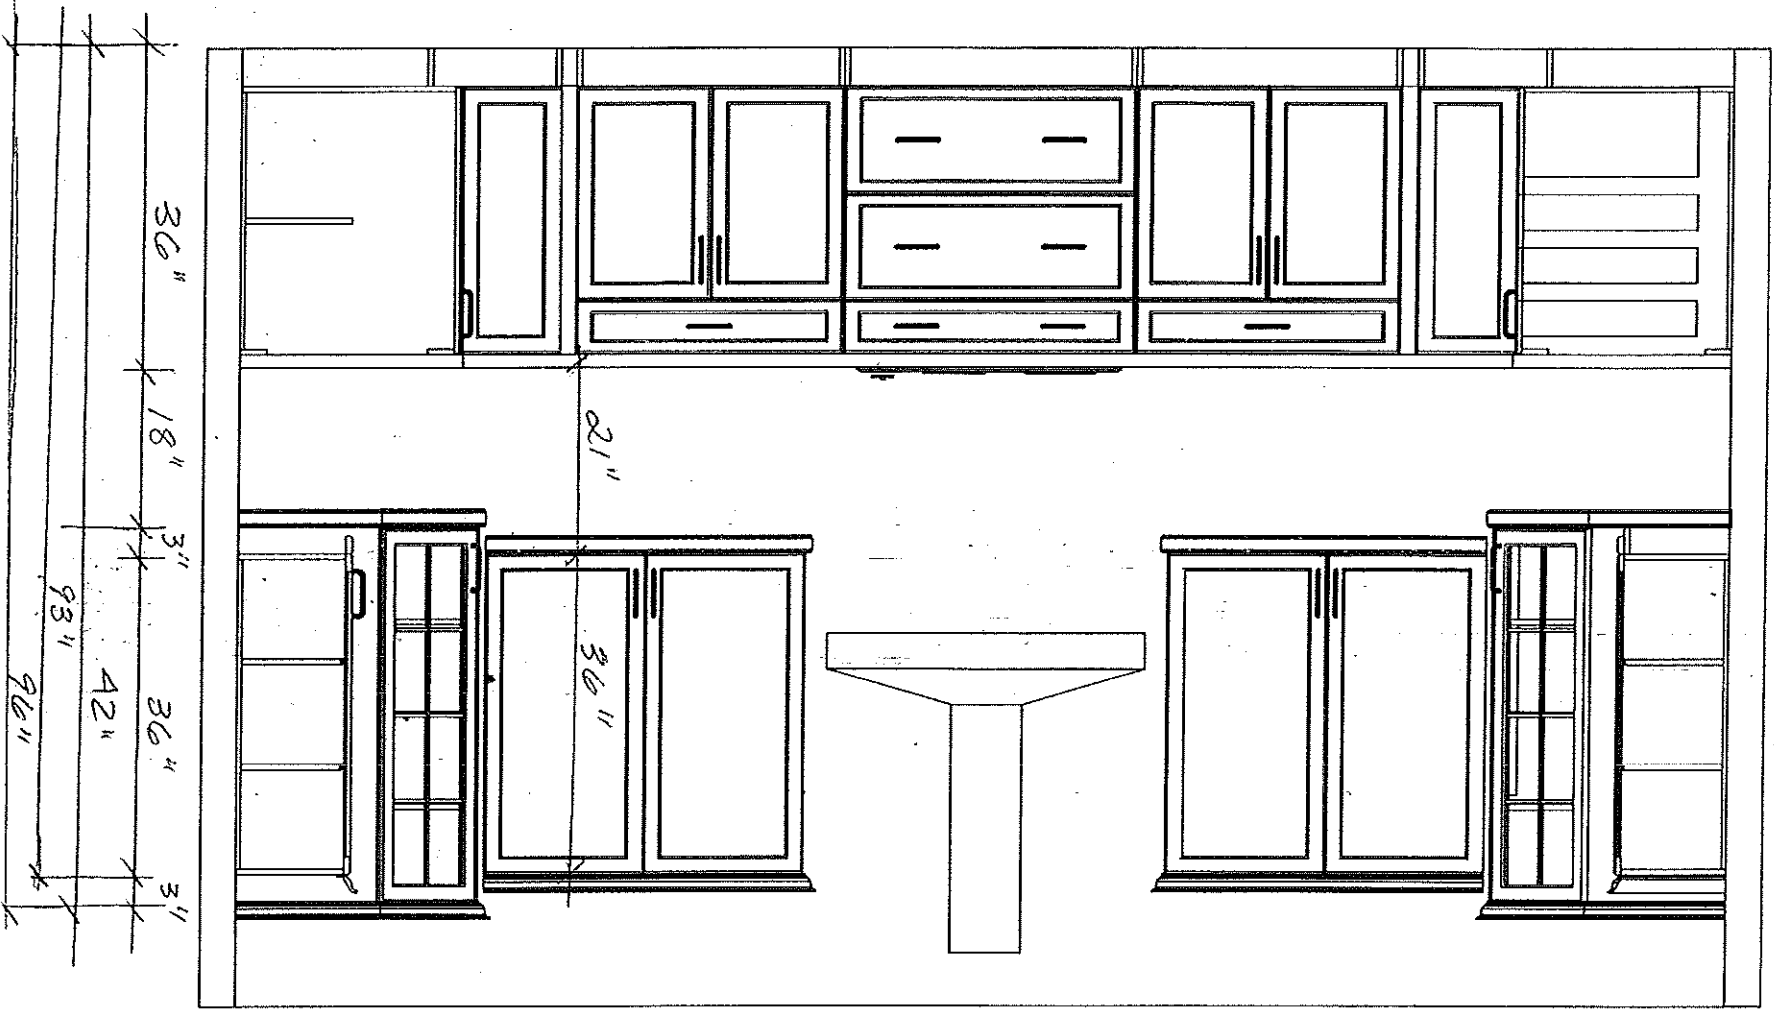

COOKTOP WALL ELEVATION - LOT # SSM5 - REV. SEPT. 21/11

CUSTOMER APPROVAL

I have reviewed these drawings and understand the details of the layout and the Carter Kitchens specifications.

Signature: _____
 Date: _____


Note: This drawing is an artistic interpretation of the general appearance of the design. It is not meant to be an exact rendition.

DRAWN BY: Lori Di Saverio, B.I.D.
 CARTIER KITCHENS OTTAWA



Drawing #: 1

Designed: 6/5/2011
 Printed: 6/5/2011

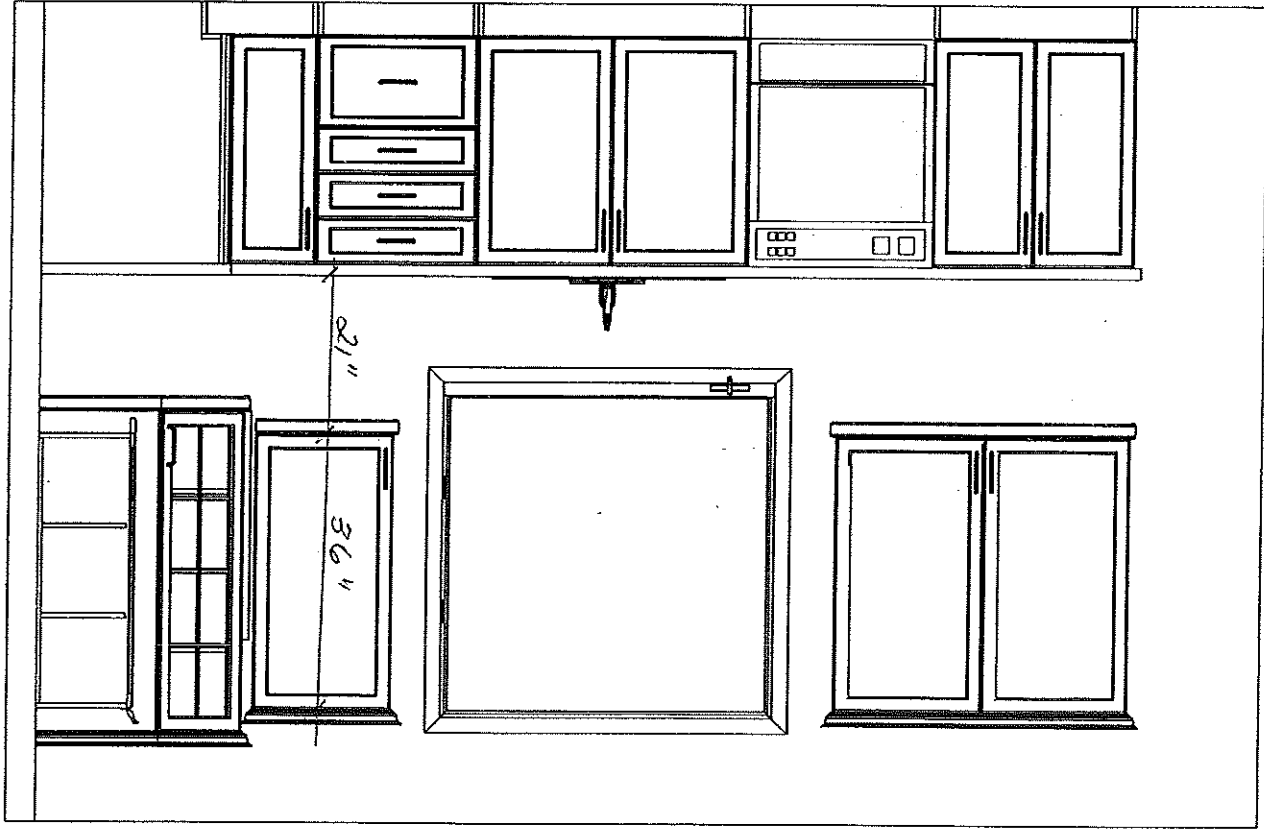


93" 36" 21" 36"

36" 18" 3" 36" 3"
 93" 42" 96"

SINK WALL ELEVATION ~ LOT # 5 SMS ~ REV. SEPT. 21/11

oiled / bridge water elevation ~ lot #4 SMS ~ Rev. Sept. 21/11

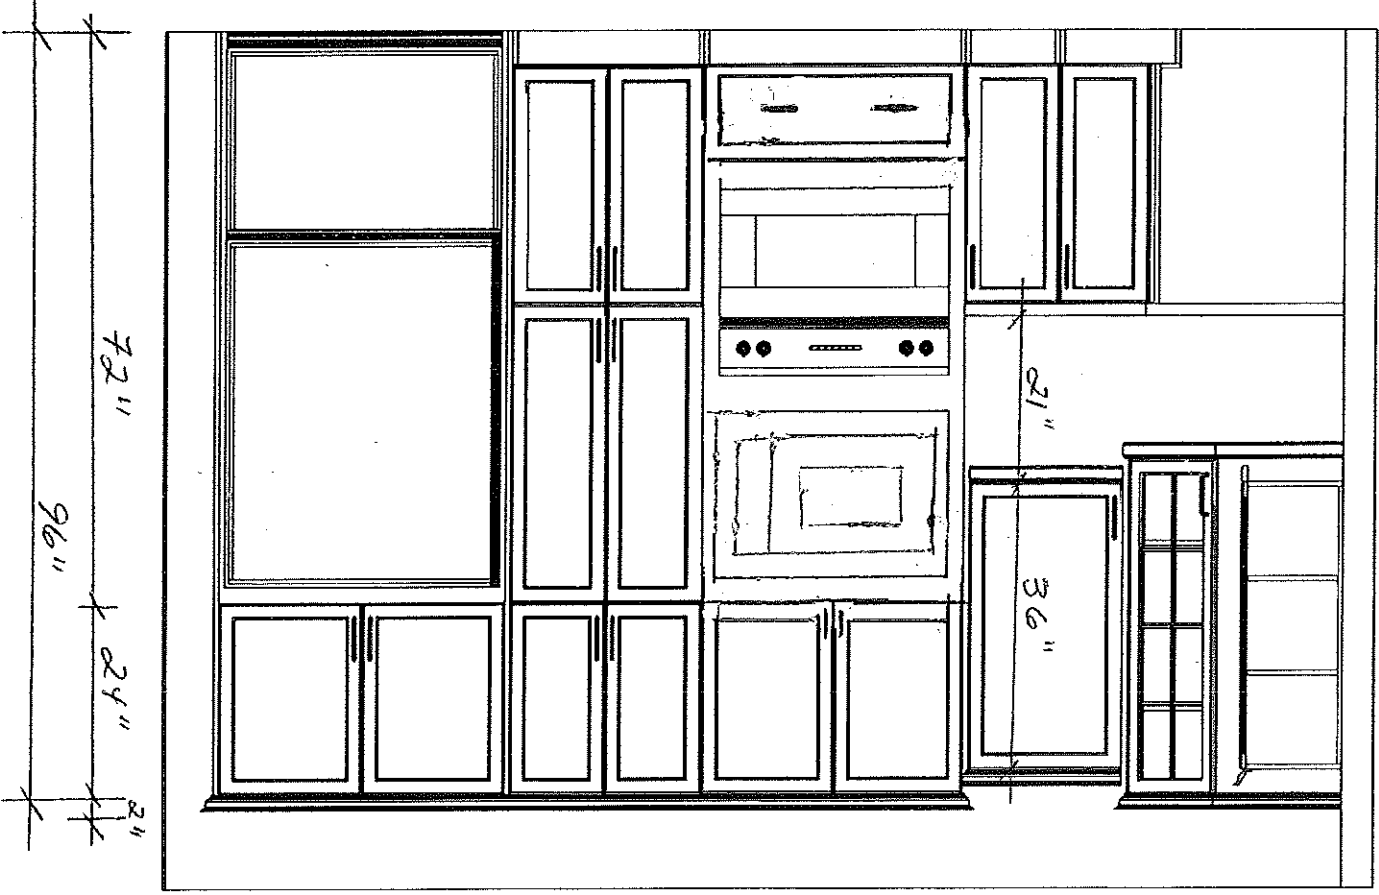

I have reviewed these drawings and understand the details of the layout and the Carter Kitchen's specifications.

Signature: _____
Date: _____

CUSTOMER APPROVAL

Note: This drawing is an artistic interpretation of the general appearance of the design. It is not meant to be an exact rendition.

DRAWN BY: Lori Di Saverio, B.I.D.
CARTIER KITCHENS OTTAWA


DCR #45MS5 - Kitchen - 512 Platina (Right)

IV

Drawing #: 1




Designed: 6/5/2011
Printed: 6/5/2011

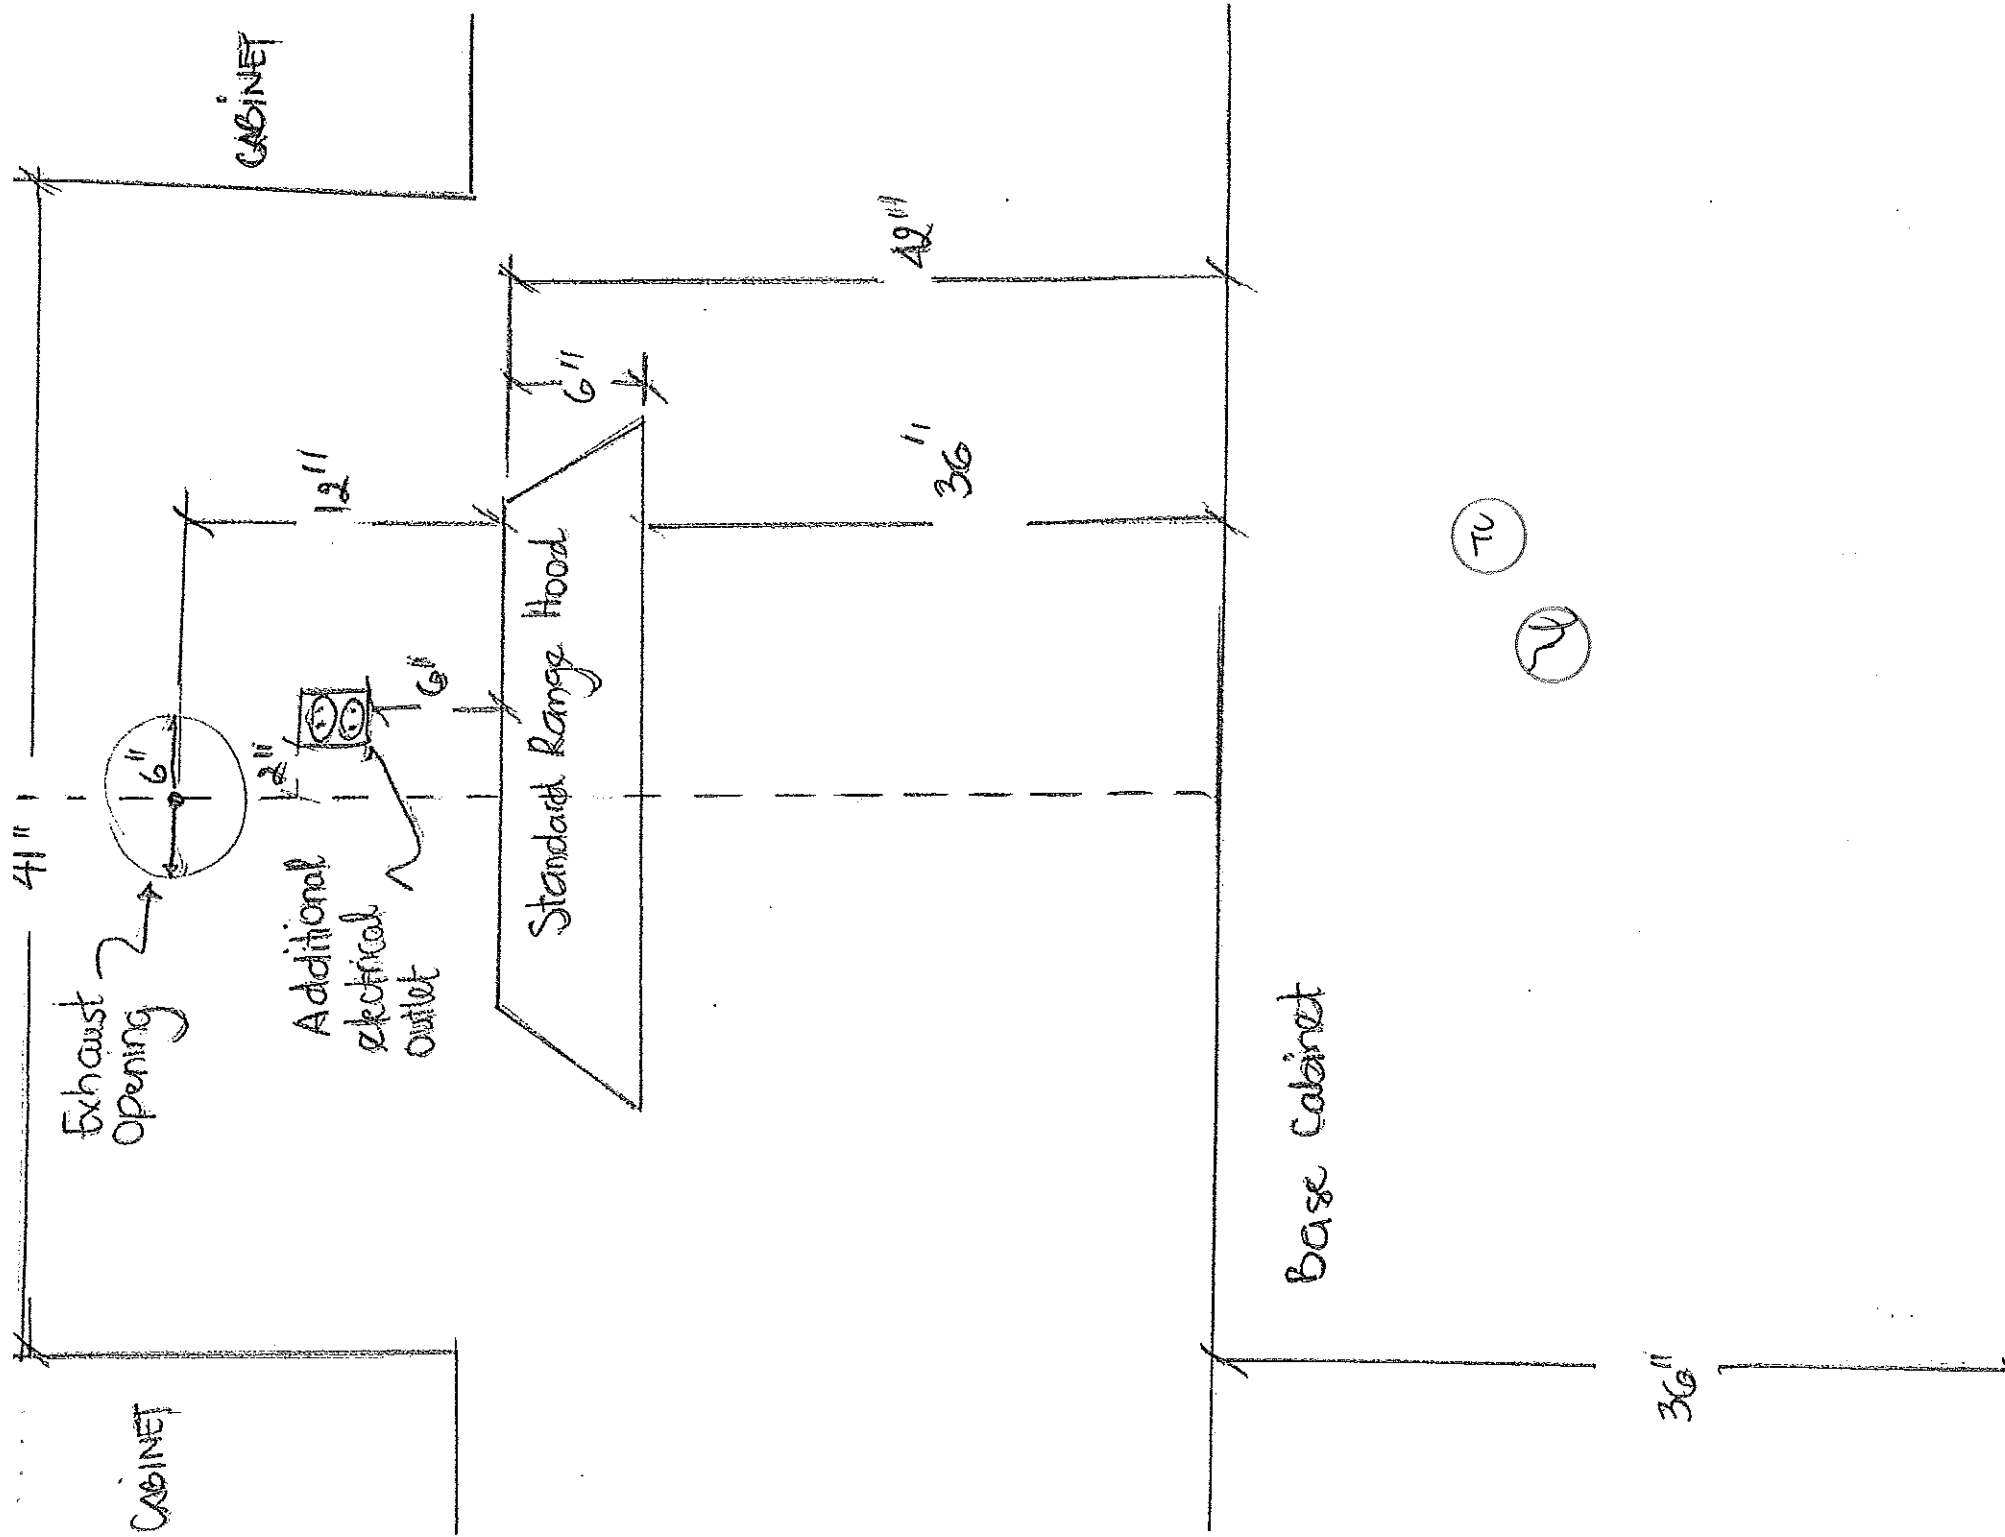

70

2